U.S.


PUBLIC LAND SURVEY MONUMENT RECORD

For Public Land Survey Corners in:

WI ADMINISTRATIVE CODE A-E 7.08 REQUIREMENT

T. / N., R. /2E

CORNER CODE INDEX

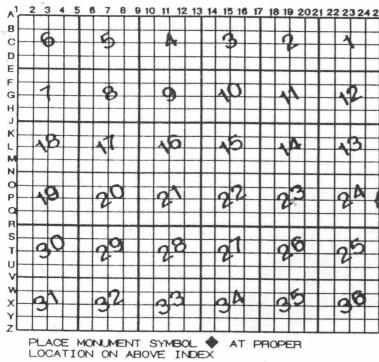

BELO	T	w	
ROCK	COUNTY	wı	

IF AVAILABLE ROCK COUNTY COORDINATES PERFERRED

North _____ Elev. East _____ Hor. Datum _____ Vert. Datum ____ LATITUDE _____ELLIPS. HT. LONGITUTE GPS (X) ___ TRAVERSE (X) ___ BASED ON THE FOLLOWING CONTROL:

♦ CORNER MONUMENT

O WITNESS MONUMENT

Ö BASED BEAFINGS ARE

(a)

FIELD BOOK	PAGE #	المحارف المراجع المتعلقة أتأثث فيساره	SHEET OF
SHOW A PLAN VIEW	DRAWING DEPICTING	THE CORNER MONUMEN	T AND SURROUNDING
PHYSICAL FEATURES,	INCLUDING THE EXC	AVATION AREA AND DEP	TH.
		BOVE FORM ON 12/2/1982	

CORNER CODE P-25(1)

BE580

- (B) Describe any record evidence, monument evidence, occupational evidence, testimonial evidence or any other material evidence you considered, and whether the monument was found or placed.
- 1859 HUBART VOL 1 PG 105 STATES NOTHING ABOUT MONUMENT VAR 0-29E 2647.92 TO SW CORNER OF SEC 19 & N89-57W 5075.40 TO E 1/4 COR SEC 19. N89-47E 2412.96 FROM SW TO S 1/4 CORNERS OF SECTION 19.
- 1911 KERCH VOL 3 PG 69 FOUND STONE OVER STAKE SURROUNDED BY BRICKS SET PIECE OF CAST IRON LAMPPOST 4" TO 6" DIAMETER. 2641.5 TO NW COR SEC 19,2643.5 TO SW CORNER SEC 19,89-28-30 AT W 1/4 COR SEC 19 FROM NW TO E 1/4 CORNERS OF SEC 19, ANGLE OF 90-31-30 AT W 1/4 COR SEC 19 FROM E 1/4 TO SW CORNERS OF SEC 19, ANGLE OF 90-37-45 AT NW CORNER SEC 19 FROM N 1/4 COR TO W 1/4 CORNERS OF SECTION 19, AND ANGLE OF 89-20 AT SW CORNER FROM W 1/4 TO S 1/4 CORNERS OF SECTION 19.
- 1936 SUNNY VOL 3 PG 297 FOUND CAST IRON WAGON WHEEL HUB & LIMESTONE MONUMENT 12" LOW. SET 1 1/2X 12" PIPE MONUMENT CAPPED. REFERENCED SAME.
- 1960 BATTERMAN VOL 4 PG 55 STATES NOTHING ABOUT MONUMENT. REFERENCES CORNER.
- 1976 BARNES VOL 5 PG 178 FOUND 3/4 BAR & REFERENCED SAME.
- 1977 BARNES VOL 5 PG 305 SET CAP IN CONCRETE FROM TIES. PIPE 3.18 TO SOUTH.
- 19?? VOL 6 PG 312 FOUND CAST IRON WAGON WHEEL HUB 10" LOW WITH LIMESTONE SOUTH SIDE. REFERENCED SAME.
- 1995 BARNES P-1 (TURTLE TWP) FOUND DISK IN CONCRETE. ANGLE OF 89-28-34 REC 89-28-30) AT W 1/4 FROM NW TO E 1/4 CORNERS OF SEC 19, ANGLE OF 90-31-21 (REC 90-31-30) AT W 1/4 COR FROM E 1/4 TO SW CORNERS OF SEC 19, ANGLE OF 90-37-43(REC 90-37-45) AT NW FROM N 1/4 TO W 1/4 CORNERS OF SEC 19, ANGLE OF 89-22-36(REC 88-20-20) AT SW COR FROM W 1/4 COR TO S 1/4 CORNERS OF SEC19.

INTERSECTION PROJECT WILL DESTROY DISK. FD STEM OF DISK. TOP WAS BROKE OFF. AFTER CONCRETE WAS REMOVED, I DUG 32" DEEP & 2' IN EITHER DIRECTION OF COR. AT INTERSECTION OF REC. TIES I FOUND 12" DEEP A LARGE OLD WOOD HUB IN EXCELLENT CONDITION. PLACED ALUM. MON. PRIOR TO POURING OF CONCRETE. PLACED 3 MAGNETS ABOUT 12" BELOW TOP OF MONUMENT. AT INTERSECTION OF RECORD TIES I DRILLED A SMALL HOLE IN THE TOP OF THE MON. CAP. IT IS IN THE SE QUARTER OF THE TOP.

C) Was the corner restored through acceptance of (1) an obliterated evidence location, or, (2) a found perpetuated location?

ACCEPTED FOUND PERPETUATED LOCATION.

- D) Describe any material discrepancy between the location of the corner as restored or reestablished and the location of that corner as previously restored or reestablished by distance and direction. Show the discrepancy on the plan view drawing under (a), above. Show the distances between the corner as previously restored or reestablished and (1) the corner as restored or reestablished, and (2) to at least 4 of the witness monuments shown on the drawing in (a), above.
- I, **Donald Barnes**, hereby certify that the corner location as identified by the corner code index was determined by me under my direction and control and that this U.S. Public Land Survey Monument Record is correct and complete to the best of my knowledge and belief.

Ind Bane

SHEET 1 OF 2

Sep 4 2003

CORNER GODE P-25(1)

A.E. 7.08 REQUIREMENT

