

(b.) Describe any record evidence, monument evidence, occupational evidence, testimonial evidence or any other material evidence you considered, and whether the monument was found or placed.

- 1) IN 1874 EDWARD RUGER FOUND AN OLD STAKE & PLACED A 15"X8"X6" LIMESTONE
- 2) IN 1984 STANTON STEWART (S1689) PLACED A 3/4" X 4' IRON PIN.
- 3) IN APRIL 1986 ROBERT LEUENBERGER DUG AND FOUND THE LIMESTONE WITH A DRILL HOLE IN THE TOP. THE STONE IS 3' DEEP.
- 4) I PLACED A POLY MON ON TOP OF THE STONE.

(c.) Was the corner restored through acceptance of (1) an obliterated evidence location, or, (2) a found perpetuated location?



ACCEPTED FOUND PERPETUATED LOCATION

(d.) Describe any material discrepancy between the location of the corner as restored or reestablished and the location of that corner as previously restored or reestablished by distance and direction. Show the discrepancy on the plan view drawing under (a), above. Show the distances between the corner as previously restored or reestablished and (1) the corner as restored or reestablished, and (2) to at least 4 of the witness monuments shown on the drawing in (a), above.

THE 3/4" PIN THAT WAS PLACED BY STEWART WAS NOT OVER THE STONE. THE PIN WAS REMOVED SO THE MONUMENT COULD BE INSTALLED.

(e.) Was the corner reestablished through lost corner proportionate methods? If so, show the method, including the directions and distances to other public land survey corners used as evidence or used for proportioning in determining the corner location.

I, Donald Barnes, hereby certify that the corner points as identified by the corner code index were, in a field survey on April 10, 1986, established, re-established, monumented, re-monumented, recovered or restored as expressed below and in conformance with the regulations and rules as required in the current manual of survey instructions of the United States Department of Interior, Bureau of Land Management.

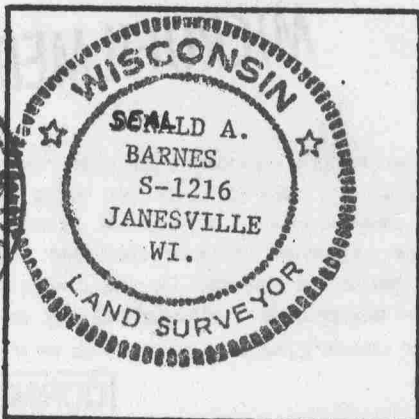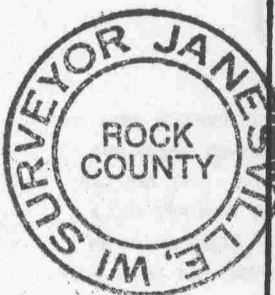

COUNTY SURVEYOR FILING DATA

Date of Computer Entry _____

Date Received _____

Date Microfilmed _____

Treasurer's Receipt No. _____

Number of Included Sheets _____

AFFIX YOUR LAND SURVEYOR SEAL.

CORNER CODE 230