U.S. PUBLIC LAND SURVEY MONUMENT RECORD

For Pul		_	_			ADMINISTRATIVE CODE A-E 7.08 REQUIREMENT
	TN.	, R. ∠	<u>2</u> E	4t	h P.M.	
CORNER CODE INDEX A1 2 3 4 5 6 7 8 9 10 11 12 13 14 15 16 17 18 19 2021 22 23 24 25						TWP
A1 2 3 4	5678	10 11 12 1	3 14 15 16 1	7 18 19 202	**************************************	
В		lacksquare	1			ROCK COUNTY, WI
c 6	119	 	- 3 -	12	 	TP AVATLANCE
						IF AVAILABLE
						ROCK COUNTY COORDINATES PERFERRED
G 1	1 8	9	140		121	202165
H	-	┠╶┼ ╌╂╌┼╌	╂┼╬┼	┠╾┾╌┼╌		North 227,457,10 Elev.
			╿ ┼┼┼			East 493, 758,00
K AB		16	100		<u> </u>	East 493, 12,00
M				\ \ \ \ \ \		Hor. Datum County Vert. Datum
N	┝╇┷┿┷					Hor. Datum Coopy Vert. Datum
° 10	100	0	02	103	OA	LATITUDE ELLIPS. HT.
	1 14	141	14	14		ELLIFS. MI.
R						LONGITUTE
			14		-6	
\$ 30	29	28	121	ර්ය	၇၁	ELLIPS. DATUM
Ul-H-			+++-	┠╼╁╌┼╌		NAD83(91) COUNTY LIST
<u> </u>						ODO (V) TOAUTOOT (V)
× az	04	23	la P	20	20	GPS (X) TRAVERSE (X)
						BASED ON THE FOLLOWING CONTROL:
لللا						
	TION ON AB			ROPER		
LUÇA	HON ON AB	OVE INDE	^			
◆CORNER MONUMENT WITNESS MONUMENT						
(a)						
]						

BEARINGS ARE BASED ON:

FIELD BOOK ____PAGE # ____ SHEET ___ OF ____ SHOW A PLAN VIEW DRAWING DEPICTING THE CORNER MONUMENT AND SURROUNDING PHYSICAL FEATURES, INCLUDING THE EXCAVATION AREA AND DEPTH.
PLANNING & ZONING COMMITTEE ADOPTED THE ABOVE FORM ON 12/2/1982

CORNER CODE \mathcal{E} -23()

(B) Describe any record evidence, monument evidence, occupational evidence, testimonial evidence or any other material evidence you considered, and whether the monument was found or placed.

1834 LYONS

EAST RANDOM BETWEEN SECTIONS 1 & 12

1607.76 TO AN INDIAN RAIL N & S

5315.64 INTERSECTED RANGE LINE 3.96' NORTH OF POST FIRST HALF MILE HILLY PRAIRIE & 2ND RATE LAST HALF MILE ROLLING PRAIRIE & FIRST RATE.

WEST CORRECTED BETWEEN SECS 1 & 12

2657.82 SET QUARTER SECTION POST & MADE MOUND OF EARTH & SOD 4' FEET SQUARE & 2 1/2 FEET HIGH.

SECTION CORNER 5315.64

- 1878 RUGER VOL 2 PG 239 FD BURNT LS IN CENTER OF HWY. VAR 3-47 2657.16 TO NW COR SEC 12.
- 1954 BATTERMAN MAP #133 FOUND R/R SPIKE 2669.33 TO SW COR SEC 1 & 2669.33 TO SE COR SEC 1
- 1957 BATTERMAN VOL 3 PG 537 R/R SPIKE 2669.33 TO SE & SW CORNERS OF SEC 1. ANGLE OF 180-12-20 AT SW COR SEC 1 FROM S 1/4 COR SEC 2 TO S 1/4 COR SEC 1, ANGLE OF 90-00-03 AT S 1/4 COR SEC 1 FROM CENTER OF SEC 1 TO SE COR SEC 1,& ANGLE OF 91-36-20 FROM S 1/4 COR SEC 1 TO E 1/4 COR SEC 1 AT THE SE COR SEC 1.
- 1958 BATTERMAN MAP #139 R/R SPIKE 2669.33 TO SE COR SEC 1 & 2669.33 TO SW COR SEC 1.
- 1963 LEE CSM V1 PG 90 R/R SPIKE.
- 1978 LEE CSM V8 PG 193 FOUND R/R SPIKE
- 19?? BATTERMAN VOL 6 PG 328 & E23 TIES FOR IRON ROD. IRON ROD REMOVED BY CONSTRUCTION WORK. R/R SPIKE 2669.33 NW & NE CORNERS OF SEC 12 & ANGLE OF 180-00-00 FROM THE SW TO SE CORNERS OF SEC 12 AT THE S 1/4 COR SEC 12.
- 1985 LEE MAP #13685 CI MON
- 1988 LEE CSM V13 PG 428 FOUND PK.
- 1990 LEE MAP #11609 CI


FD CAST IRON MONUMENT.

- C) Was the corner restored through acceptance of (1) an obliterated evidence location, or, (2) a found perpetuated location? ACCEPTED FOUND PERPETUATED LOCATION.
- D) Describe any material discrepancy between the location of the corner as restored or reestablished and the location of that corner as previously restored or reestablished by distance and direction. Show the discrepancy on the plan view drawing under (a), above. Show the distances between the corner as previously restored or reestablished and (1) the corner as restored or reestablished, and (2) to at least 4 of the witness monuments shown on the drawing in (a), above.
- (E) Was the corner reestablished through lost corner proportionate methods? If so, show the method, including the directions and distances to other public land survey corners used as evidence or used for proportioning the corner location.
- I, Donald Barnes, hereby certify that the corner points as identified by the corner code index were, in a field survey on, established, reestablished, monumented, re-monumented, recovered or restored as expressed below and in conformance with the regulations and rules as required in the current manual of survey instructions of the United States Department of Interior, Bureau of Land Management.

COUNTY SURVEYOR FILING DATA

Date of computer entry___

corner code \mathcal{E}^{3} Number of included sheets

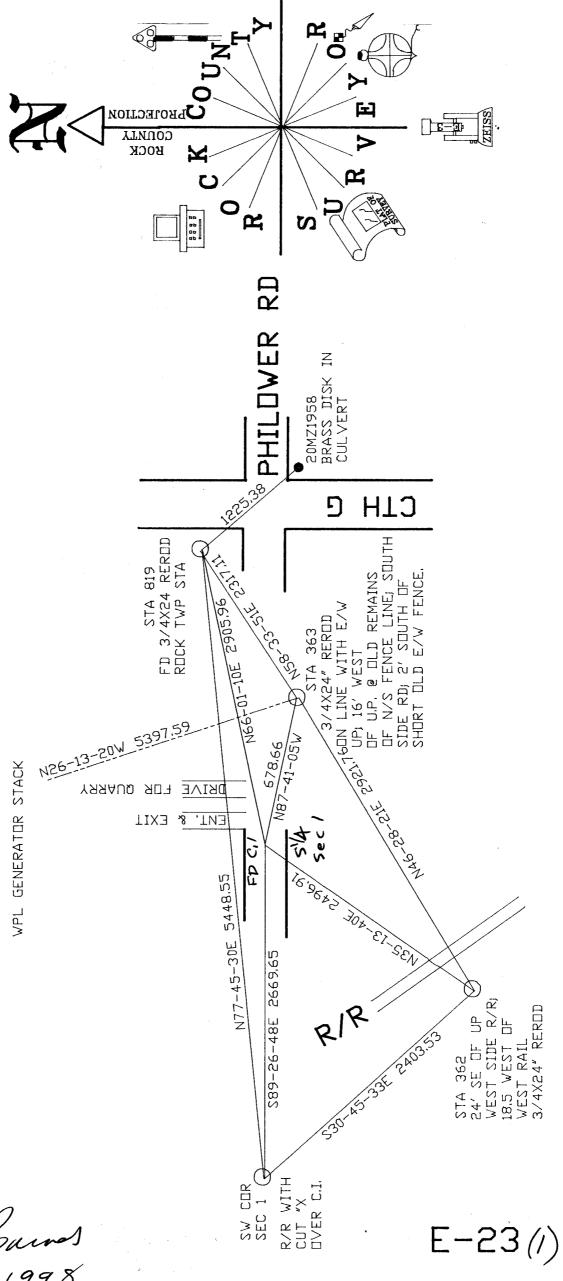

Onald Barres
027 9/1998