

Paper weight-110# (minimum)

Black nonfading ink required

# U.S. PUBLIC LAND SURVEY MONUMENT RECORD

For Public Land Survey Corners In:

WI ADMINISTRATIVE CODE A-E 7.08 REQUIREMENT

T. / N. R. 12 E. 4th P.M.

REV 10/23/2004 USMONREC.DWG

CORNER CODE INDEX

A	1	2	3	4	5	6	7	8	9	10	11	12	13	14	15	16	17	18	19	20	21	22	23	24	25	A
B		6				5				4				3				2				1				B
C																										C
D																										D
E																										E
F																										F
G																										G
H																										H
J																										J
K																										K
L																										L
M																										M
N																										N
O																										O
P																										P
Q																										Q
R																										R
S																										S
T																										T
U																										U
V																										V
W																										W
X																										X
Y																										Y
Z																										Z

BELOIT TWP

ROCK COUNTY WI

IF AVAILABLE  
ROCK COUNTY COORDINATES PREFERRED

North \_\_\_\_\_ Elev. \_\_\_\_\_

East \_\_\_\_\_

Hor. Datum \_\_\_\_\_ Vert. Datum \_\_\_\_\_

LATITUDE \_\_\_\_\_ ELLIPS. HT. \_\_\_\_\_

LONGITUDE \_\_\_\_\_

NAD83(91) \_\_\_\_\_ NETWORK ADJ. YR \_\_\_\_\_

GPS (X) \_\_\_\_\_ TRAVERSE (X) \_\_\_\_\_

BASED ON THE FOLLOWING CONTROL:  
\_\_\_\_\_

PLACE MONUMENT SYMBOL  AT PROPER LOCATION ON ABOVE INDEX

CORNER MONUMENT

WITNESS MONUMENT

BEARINGS ARE BASED ON: \_\_\_\_\_

FIELD BOOK \_\_\_\_\_ PAGE # \_\_\_\_\_



SHEET 1 OF 2

SHOW A PLAN VIEW DRAWING DEPICTING THE CORNER MONUMENT AND SURROUNDING PHYSICAL FEATURES, INCLUDING THE EXCAVATION AREA AND DEPTH.

PLANNING & ZONING COMMITTEE ADOPTED THIS FORM ON 12/2/1982

CORNER CODE R-13(2)

LOT 19 CHRISTILLA HEIGHTS

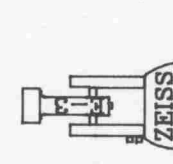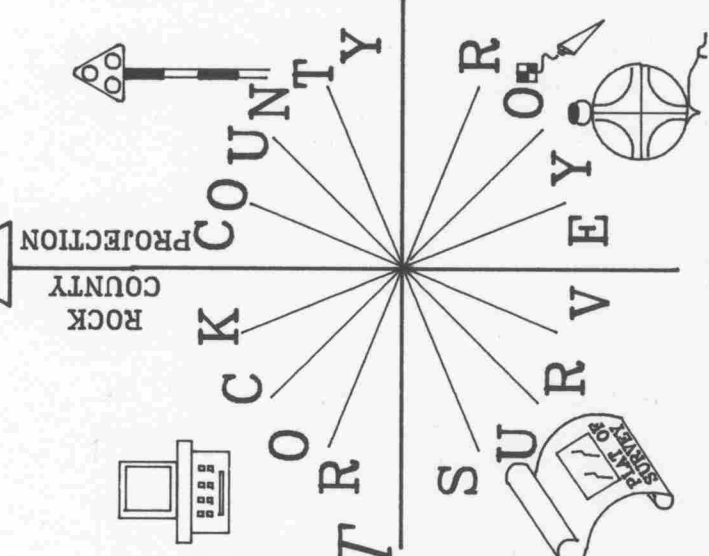

NOT TO SCALE

MONUMENT WILL BE DESTROYED BY RD CONSTRUCTION  
 ELEVATION'S BASED ON PHOTO © SEC COR OF 834.0  
 OBSERVATION SHEET #587 & 853  
 OBSERVATION SHEET #587

BURTON ST  
 NE COR  
 SEC 28  
 BELOIT TWP  
 T1N R12E

STA 853  
 FD COTTON PIN  
 2.5 SOUTH OF CURB

FD 1" PIPE

FD 2 1/2" PIPE  
 ELEV 832.8

FREDERICK ST  
 STREET NOT IN

FD 2 1/2" PIPE  
 ELEV 833.3

SHEET 2 OF 2

R-13(2)

FD 3" PIPE  
 ELEV 832.3

S88-53-01E 200.66

S77-47-58E 205.08  
 1988 205.08

S63-31-03E 186.92

S84-05-44W  
 CELL TOWER

NO-15-32E 39.43  
 1998 NO-14-40E 39.44  
 1984 40.00

FD SURVEY SPIKE

1998 S10-32-55E 58.97  
 S10-33-25E 58.96

1998 8661  
 S38-51-51E 52.47  
 S38-51-11E 52.47  
 1984 52.49

1984 66.00  
 1998 S89-15-55E 66.08  
 S89-15-34E 66.07

1998 N39-38-22E 51.96  
 N22-45-26E 86.15  
 N22-44-51E 86.15  
 1984 51.86  
 1984 51.86

EMBOSSSED SEAL

*D. J. Jones*

July 22, 2008

BE587

(B) Describe any record evidence, monument evidence, occupational evidence, testimonial evidence or any other material evidence you considered, and whether the monument was found or placed.

- 1950 BATTERMAN MAP #80022 FOUND PIN  
1958 SHIMEALL MAP #443 FOUND PIN 2660.80 TO E 1/4 CORNER SEC 21  
1959 SHIMEALL SUBDIVISION PLAT BK 20 PG 6 FOUND 1" IRON PIN  
1961 SHIMEALL SUBDIVISION PLAT BK 21 PG 7 1330.4 NORTH TO 1/16TH CORNER.  
1962 SHIMEALL SUBDIVISION PLAT BK 21 PG 31 FOUND 1" PIN  
1984 ROLOFF R-13 LOCATION OF THIS CORNER WAS REESTABLISHED OFF FROM VERIFIED EXISTING MONUMENTS FOUND ON THE EAST LINE OF THE PLAT OF CHRISTILLA HEIGHTS (RECORDED 6-21-59). I WAS UNABLE TO FIND IRON PIN AT SECTION CORNER AS SHOWN ON THE FACE OF THE PLAT PREPARED BY SURVEYOR CLAYTON SHIMEALL. SET PK & REFERENCED SAME.  
1997 BARNES R-13(1) FOUND R/R SPIKE WITH DRILL HOLE THAT WAS IN HARMONY WITH EXISTING TIES. ACCEPTED FOUND PERPETUATED LOCATION. REFERENCED SAME.

FD SURVEY SPIKE, REFERENCE MONUMENTS, & COTTON GIN PIN (STA#B63). CORNER IS 2.5' NORTH OF CENTER OF PVMT. MONUMENT WILL BE DESTROYED BY ROAD CONSTRUCTION

C) Was the corner restored through acceptance of (1) an obliterated evidence location, or, (2) a found perpetuated location?

ACCEPTED FD MONUMENT.

D) Describe any material discrepancy between the location of the corner as restored or reestablished and the location of that corner as previously restored or reestablished by distance and direction. Show the discrepancy on the plan view drawing under (a), above. Show the distances between the corner as previously restored or reestablished and (1) the corner as restored or reestablished, and (2) to at least 4 of the witness monuments shown on the drawing in (a), above.

NONE

(E) Was the corner reestablished through lost corner proportionate methods? If so, show the method, including the directions and distances to other public land survey corners used as evidence or used for proportioning the corner location.

NO

I, **Donald Barnes**, hereby certify that the corner location as identified by the corner code index was determined by me under my direction and control and that this U.S. Public Land Survey Monument Record is correct and complete to the best of my knowledge and belief.

Seal

*Donald Barnes*  
Emboss

SHEET 1 OF 2

July 22, 2008

CORNER CODE **R-13(2)**