
## ninimum) U.S.

## PUBLIC LAND SURVEY MONUMENT RECORD

For Public Land Survey Corners in: T. \_/N., R. \_/2\_E

WI ADMINISTRATIVE CODE A-E 7.08 REQUIREMENT

CORNER CODE INDEX

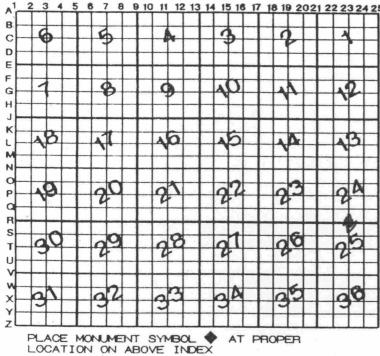

BEC	017	TWP
ROCK	COUNTY	wr

IF AVAILABLE ROCK COUNTY COORDINATES PERFERRED

North \_\_ East Hor. Datum \_\_\_\_\_ Vert. Datum \_ LATITUDE ELLIPS. HT. LONGITUTE

BASED ON THE FOLLOWING CONTROL:

GPS (X) \_\_ TRAVERSE (X) \_\_

**♦ CORNER MONUMENT** 

O WITNESS MONUMENT

Ö BASED BEAFINGS ARE

(a)

	2000	
	SHEET C	2
FIELD BOOKPAGE #	SHEET C	)F
SHOW A PLAN VIEW DRAWING DEPICTING THE CORNER MONUMENT	AND SURROUNDING	
PHYSICAL FEATURES, INCLUDING THE EXCAVATION AREA AND DEPTH		
PLANNING & ZONING COMMITTEE ADOPTED THE ABOVE FORM ON 12/2/1982		

CORNER CODE R-23(1

## BE592

- (B) Describe any record evidence, monument evidence, occupational evidence, testimonial evidence or any other material evidence you considered, and whether the monument was found or placed.
- ORIG SURVEY SET QUARTER SECTION POST & RAISED A MOUND OF EARTH & SOD 4' SQUARE & 2 1/2 FEET HIGH. CALLS FOR 2652.54' TO SE & SW CORNERS OF SEC 24.
- CALDWELL "PERRIGO PLACE" BK 7 PG 42 CALLS FOR THE SOUTH 1910 LINE OF SEC 24.
- HEEBINK SUB "PERRIGO PLACE ADDITION" BK 7 PG 59. CALLS FOR 1911 THE SOUTH LINE OF SEC 24 AND WEST LINE OF SEC 24. STATES NOTHING ABOUT CORNER. CALLS FOR AN ANGLE OF 89-58-30 AT SW COR SEC 24 FROM W 1/4 COR TO ALONG SOUTH LINE OF SEC 24. CALLS FROM THE SW COR SEC 24 A LIMESTONE MON N89-58-30E 3,188.52. THE ROW LINE AND CALLS TO THE SECTION CORNER INDICATES A STRAIGHT LINE BETWEEN THE SW & SE CORNERS OF SEC 24.
- 1917 BATTERMAN CITY OF BELOIT NOTES. ANGLE OF 90-24 LOOKING SOUTH TO WEST,
- SHIMEALL #4253 CALLS FOR AN ANGLE OF 90-01-30 AT THE SE 1952 COR SEC 24 FROM THE S 1/4 COR SEC 24 TO THE E 1/4 COR SEC 24.
- BARNES R-23 RESTORED CORNER THROUGH ACCEPTANCE OF 1998 OBLITERATED EVIDENCE LOCATION. PLACED CORNER MIDWAY ON LINE WITH SW AND SE CORNERS OF SEC 24. THIS IS IN HARMONY WITH FOUND PROPERTY CORNERS AND RECORD ANGLES AT THE SW, SE, AND N 1/4 CORNERS OF SEC 24. DID NOT PLACE A MONUMENT.
- KREBS CSM VOL 22 PG 292 SEC COR. FROM COUNTY TIES S89-35-1999 13E 2664.77 TO SE COR SEC 24.
- 2000 HOULE CSM VOL 24 PG 16 COMPUTED FROM TIES, S89-13-13E 2664.77 TO SE COR SEC 24
- 2002 LEUENBERGER CSM VOL 25 PG 431, VOL 25 PG 213, VOL 25 PG 81, CSM VOL 25 PG 73. COMPUTED FROM COUNTY TIES. S89-35-13E 2664.77 TO SE COR SEC 25

PLACED STEEL SURVEY SPIKE AT INTERSECTION OF DISTANCES AND ANGLES OF EXISTING TIES. N89-35-13W 2664.76 TO SW COR SEC 24 & S89-35-13E 2664.77 TO SE COR SEC 24. ANGLES: @ SW COR SEC 24 FROM W 1/4 COR SEC 24 TO S 1/4 COR SEC 24 89-58-32 (HEEBINK 89-58- $^{\circ}$ 30),  $^{\circ}$  S  $^{\prime}$ 4 COR SEC 24 FROM S  $^{\prime}$ 4 COR SEC 25 TO SW COR SEC 25 90-08-35 (1917 BATTERMAN 90-24), @ SE COR SEC 24 FROM S 1/4 COR SEC 24 TO E 1/4 COR SEC 24 90-01-10 (1952 SHIMEALL 90-01-30)

C) Was the corner restored through acceptance of (1) an obliterated evidence location, or, (2) a found perpetuated location?

ACCEPTED POSITION AS DETERMINED FROM TIES.

D) Describe any material discrepancy between the location of the corner as restored or reestablished and the location of that corner as previously restored or reestablished by distance and direction. Show the discrepancy on the plan view drawing under (a), above. Show the distances between the corner as previously restored or reestablished and (1) the corner as restored or reestablished, and (2) to at least 4 of the witness monuments shown on the drawing in (a), above.

I, Donald Barnes, hereby certify that the corner location as identified by the corner code index was determined by me under my direction and control and that this U.S. Public Land Survey Monument Record is correct and complete to the best of my knowledge and belief.

Donald Barnes Emboss 0-T 30, 2003

SHEET 1 F 2

CORNER CODE R-23(1)

