Paper weight-110# (minimum)

Black nonfading ink required

# U.S. PUBLIC LAND SURVEY MONUMENT RECORD


For Public Land Survey Corners In:

WI ADMINISTRATIVE CODE A-E 7.08 REQUIREMENT

EV 10/23/2004 USMONREC.DWO

T. 4 N. R. 11 E. 4th P.M.

CORNER CODE INDEX

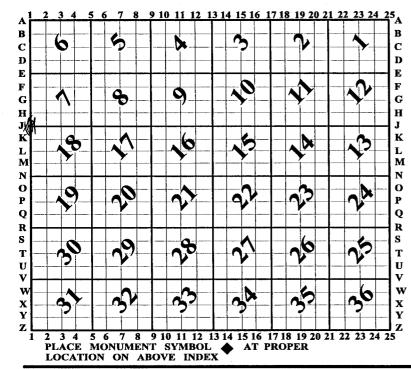

## PORTER TWP

IF AVAILABLE ROCK COUNTY COORDINATES PERFERRED

North	Elev.
East	····
Hor. Datum	Vert. Datum
LATITUDE	ELLIPS. HT.
LONGITUDE	
NAD83(91)	NETWORK ADJ. YR
GPS (X)	TRAVERSE (X)
BASED ON THE	FOLLOWING CONTROL:

**◆ CORNER MONUMENT** 

WITNESS MONUMENT

BEARINGS ARE BASED ON:

(a)

FIELD BOOK \_\_\_\_\_ PAGE # \_\_\_\_\_ OF \_\_\_\_\_ OF SHOW A PLAN VIEW DRAWING DEPICTING THE CORNER MONUMENT AND SURROUNDING PHYSICAL FEATURES, INCLUDING THE EXCAVATION AREA AND DEPTH.
PLANNING & ZONING COMMITTEE ADOPTED THIS FORM ON 12/2/1982

CORNER CODE \_\_\_\_\_\_\_ ( )

(B) Describe any record evidence, monument evidence, occupational evidence, testimonial evidence or any other material evidence you considered, and whether the monument was found or placed.

- 1833 (SEP) BRINK & MULLETT T4N R1DE VAR 8-15 NORTH ON EAST SIDE OF SECTION 13
  - 1393.92 BUR DAK 16 IN DIAMETER
  - 2640.0 SET QUARTER SECTION POST BURR OAK 24 N10W 120.78'; BURR OAK 16 S9W 219.12'
  - 2772.0 ENTER PRAIRIE
  - 3762.0 ROAD @ EAST
  - 5280.00 SET POST CORNER SECTIONS 12 & 13 IN PRAIRIE AND MADE A MOUND LAND ROLLING SECOND RATE FIRST 1/2 TIMBERED WITH WHITE BLACK AND BUR OAK LAST 1/2 PRAIRIE
- 1833 (SEP) BRINK & MULLETT T4N R1DE VAR 8-15 NORTH ON EAST SIDE OF SECTION 12
  - 2640.0 SET QUARTER SECTION POST IN PRAIRIE AND MADE MOUND
  - 5280.00 SET POST CORNER SECTIONS 1 & 12 IN PRAIRIE AND MADE MOUND LAND ROLLING PRAIRIE SECOND RATE
- 1833 (NOV 4) HARRISON WEST 7 & 18 T4N R11E 4TH MER.
  - 2640.0 QUARTER SEC COR. SET POST & RAISED A MOUND OF EARTH & SODS
  - 5192.88 W BDY 132' NORTH OF POST. SET A POST & RAISED A MOUND
- 1833 ORIG GOV PLAT NW COR SEC 18 PORTER TWP IS 122.00'
  NORTH OF NE COR SEC 13 UNION TWP
- 1833 (OCT) HARRISON EAST ON RAND. BET SECS 12 & 13 T4N R1 DE
  - 1452 BROOK 3.3' CRS N.E.
  - 2640 SET TEMPY 1/4 SEC COR
  - 5188.92 INT. E BDY 46.2' NORTH OF POST LAND ROLLING 1ST RATE PRAIRIE.

WEST COR WEST BET SEC 12 & 13

- 2627.46 QUARTER SEC COR {SET POST & RAISED MOUND OF EARTH & SOD
- 2594.46 PENCELED IN BELOW 2627.46
- 5188.92 SEC COR
- 1870 RUGER (SEP) REMONUMENTATION PG 106 SOUTH ON EAST LINE OF NE1/4 SEC 12 IN A

VAR 6-30; OFFSET EAST 10.89'AT

2657.16 INTERSECTED QUARTER LINE 10.56' EAST OF QUARTER CORNER. FOUND OLD STAKE AT CORNER

SOUTH ON EAST LINE OF SE 1/4 SEC 12 ON A VAR 6-20; OFFSET EAST 15.84'

- 2662.44 INTERSECTED SOUTH BOUNDARY LINE 7.59 EAST OF CORNER. COR VAR 6-31 [RUGER PLACED CUT LIMESTONES]
- 1870 RUGER (SEP) REMONUMENTATION PG 102 EAST ON NORTH
  LINE OF NW 1/4 SEC 13 ON A VAR 6-25'
  OFFSET NORTH 16.50'AT
  - 2614.48 INTERSECTED QUARTER LINE AT QUARTER CORNER FOUND REMAINS OF OLD STAKE AT CORNER COR. VAR 6-46

EAST ON NORTH LINE OF NE 1/4 SEC 13 (T4N R1OE) ON A VAR 6-50'; OFFSET SOUTH 5.61' AT

- 2597.10 INTERSECTED EAST BOUNDARY LINE 3.96' NORTH OF CORNER. FOUND OLD STAKE SURROUNDED BY LIMESTONE AT CORNER. COR VAR 6-38
- 1870 RUGER (SEP) REMONUMENTATION PG 103 SOUTH ON EAST LINE OF NE 1/4 SEC 13 (T4N R10E) ON A VAR 6-55; OFFSET EAST 7.26 AT

SHEET 1 OF 2

CORNER CODE J-1(1)

Dull Baces 3/18/2009

#### PO541 SWCORSEC7

2661.12 INTERSECTED QUARTER LINE AT QUARTER CORNER. FOUND OLD STAKE AT CORNER. ALSO FOUND STUMPS OF BOTH BEARING TREES. COR

VAR 7-05 SEPTEMBER 1, 1870

SOUTH ON EAST LINE OF SE 1/4 SEC 13 ON A VAR 7-00' OFFSET WEST 3.30'; OFFSET WEST 9.24' AT

2657.16 INTERSECTED SOUTH BOUNDARY LINE 10.89'??
WEST OF CORNER COR. VAR 6-53'

- 1909 KERCH VOL 3 PG 51 SE COR SEC 12 UNION TWP FD MON 2668.0 TO E 1/4 COR SEC 12, INTERIOR CORNERS IN THE SE 1/4 OF SEC 12 WERE MONUMENTED WITH PIPES.
- 1952 SUNNY #3576 SHOWS SE COR SEC 12 A STONE @ FENCE INT. & 146.4 SOUTH OF E/W FENCE THAT IS IN PORTER TWP.
- 1976 BARNES VOL 5 PG 123 SE COR SEC 12 UNION TWP. FD CUT STONE MON 0.5 DEEP @ FENCE INT. REFERENCED SAME. @ S 1/16TH COR OF THE SE 1/4 OF SEC 12, MR. DON SPOONER STATED HE FOUND A METAL PIPE AT THE COR. HE CHAINED IT OFF AND BULLDOZED THE OLD FENCE LINE. HE THEN RESET THE PIPE VERY DEEXP AND PLACED THE FENCE POST ON TOP OF IT.
- 1985 BARNES VOL 6 PG 346 SHOWS REC. DISTANCES.
- 1986 BARNES VOL 6 PG 360 STATES NOTHING ABOUT MON. S89-19-21E 2542.52 TO N 1/4 COR SEC 18, SO-51-50W 132.00 TO FD LS @ NE COR SEC 13, NO-50-54E 2533.17 TO FD LS @ E 1/4 COR SEC 12, SO-27-42W 2698.97 TO W 1/4 COR SEC 7
- 1986 BARNES J-1 SOO-51-50W 132.00 TO CUT LIMESTONE @ NE COR SEC 13. REF. SAME. WEST SIDE OF N/S FENCE, 21' SOUTH OF E/W FENCE. DID NOT FIND ANYTHING. SET 3/8X26 REPOD.
- 1988 BARNES VOL 6 PG 387 STATES NOTHING ABOUT MON. S89-19-21E 2542.52 TO S 1/4 COR SEC 7, SOO-51-34W 132.02 TO SE COR SEC 12, NOO-50-54E 2533.17 TO E 1/4 COR SEC
- 1993 COMBS #9871 FD STONE @ NE COR SEC 13 UNION TWP. N89-34-10W ALONG SEC LINE

### I USED MY 1986 OBSERVATIONS TO MY SET REROD.

C) Was the corner restored through acceptance of (1) an obliterated evidence location, or, (2) a found perpetuated location?

## ACCEPTED REROD

- D) Describe any material discrepancy between the location of the corner as restored or reestablished and the location of that corner as previously restored or reestablished by distance and direction. Show the discrepancy on the plan view drawing under (a), above. Show the distances between the corner as previously restored or reestablished and (1) the corner as restored or reestablished, and (2) to at least 4 of the witness monuments shown on the drawing in (a), above.
- (E) Was the corner reestablished through lost corner proportionate methods? If so, show the method, including the directions and distances to other public land survey corners used as evidence or used for proportioning the corner location.
- I, **Donald Barnes**, hereby certify that the corner location as identified by the corner code index was determined by me under my direction and control and that this U.S. Public Land Survey Monument Record is correct and complete to the best of my knowledge and belief.

SHEET 2 OF 2

CORNER CODE J-1(1)

A.E. 7.08 REQUIREMENT

18/2009