

Paper weight-110# (minimum)

Black nonfading ink required

U.S. PUBLIC LAND SURVEY MONUMENT RECORD

For Public Land Survey Corners In:
T. 4 N. R. 11 E. 4th P.M.
CORNER CODE INDEX

WI ADMINISTRATIVE CODE A-E 7.08 REQUIREMENT
REV 10/23/2004 USMONREC.DWG

PORTER TWP
ROCK COUNTY WI

IF AVAILABLE
ROCK COUNTY COORDINATES PREFERRED

A	1	2	3	4	5	6	7	8	9	10	11	12	13	14	15	16	17	18	19	20	21	22	23	24	25	A
B		6				5				4					3					2					1	B
C																										C
D																										D
E																										E
F																										F
G																										G
H																										H
J																										J
K																										K
L																										L
M																										M
N																										N
O																										O
P																										P
Q																										Q
R																										R
S																										S
T																										T
U																										U
V																										V
W																										W
X																										X
Y																										Y
Z																										Z

North _____ Elev. _____

East _____

Hor. Datum _____ Vert. Datum _____

LATITUDE _____ ELLIPS. HT. _____

LONGITUDE _____

NAD83(91) _____ NETWORK ADJ. YR _____

GPS (X) _____ TRAVERSE (X) _____

BASED ON THE FOLLOWING CONTROL:

PLACE MONUMENT SYMBOL AT PROPER LOCATION ON ABOVE INDEX

CORNER MONUMENT

WITNESS MONUMENT

BEARINGS ARE BASED ON:-----

FIELD BOOK _____ PAGE # _____

SHEET 1 OF 3

SHOW A PLAN VIEW DRAWING DEPICTING THE CORNER MONUMENT AND SURROUNDING PHYSICAL FEATURES, INCLUDING THE EXCAVATION AREA AND DEPTH.

PLANNING & ZONING COMMITTEE ADOPTED THIS FORM ON 12/2/1982

CORNER CODE X-1(1)

PO614

W1/4CORSEC31

(B) Describe any record evidence, monument evidence, occupational evidence, testimonial evidence or any other material evidence you considered, and whether the monument was found or placed.

- 1833 (SEP) BRINK & MULLETT T4N R10E VAR 8-15 NORTH ON EAST SIDE OF SECTION 36
2640.0 SET QUARTER SECTION POST WHITE OAK 16 S75W 267.96'; BUR OAK 6 N 1 1/2 W 339.24'
2904.0 LEAVE MARSH AND ENTER TIMBER
3432.0 LEAVE TIMBER AND ENTER MARSH
4785.0 LEAVE MARSH AND ENTER TIMBER
5280.0 SET POST CORNER SEC 25 & 36 BUR OAK 14 S47W 49.50'; BUR OAK 14 N66W 45.54' LAND ROLLING SECOND RATE EXCEPT MARSH TIMBER BUR WHITE AND BLACK OAK.
- 1833 ORIG GOV PLAT NW COR SEC 31 PORTER TWP IS 16.50' NORTH OF NE COR SEC 36 UNION TWP
- 1867 LOCKE VOL 1 PG 301 & #5277 E 1/4 COR SEC 36 UNION TWP FD REMAINS OF B. TREES-SET OAK STAKE WITH HARD HEAD ON N. S.E. & W IN EDGE OF DITCH. VAR 7-55' 2650.56 TO SE COR SEC 36, VAR 7-40' 2647.92 TO NE COR SEC 36 & VAR 7-00' 2605.35 TO CENTER OF SEC 36.
- 1870 RUGER (SEP) REMONUMENTATION NOTES. NORTH ON EAST LINE OF SE 1/4 SEC 36 ON A VAR 7-21 OFFSET WEST 8 LKS (5.28')
2652.54') INTERSECTED QUARTER LINE 1 LK (.66') WEST OF QUARTER COR. FOUND STAKE SURROUNDED BY HARD HEAD STONES SET BY LOCKE AT CORNER. ALSO FOUND REMAINS OF STUMPS OF BEARING TREES COR VAR 7-28.
NORTH ON EAST LINE OF NE 1/4 SEC 36 ON A VAR 7-12 OFFSET EAST 13 LKS (8.58')
2651.88') INTERSECTED NORTH BOUNDARY LINE 7.92' EAST OF CORNER. COR VAR 7-11. (PLACED CUT LIMESTONE)
- 1874 RUGER VOL 2 PG 165 & #3652 FOUND STONE MONUMENT AT E 1/4 CORNER OF SECTION 36 UNION TWP. SET STAKE SURROUNDED WITH 3 HH AT W 1/4 CORNER OF SECTION 31 PORTER TWP. STAKE IS 11.22' NORTH OF E 1/4 CORNER OF SECTION 36 UNION TWP. 2660.79 TO NW & 2660.79 TO SW COR OF SEC 31. W 1/4 COR IS 2599.41' TO CENTER OF SECTION 31 & 5253.27' TO E 1/4 CORNER OF SEC 31 PORTER TWP.
- 1980 BARNES VOL 6 PG 27 DUG VERY LARGE HOLE 3' DEEP WITH BACKHOE AND FOUND NOTHING. DUG BY HAND AT THE W 1/4 CORNER OF SEC 31 PORTER TWP AND FOUND 3 PIECES OF 1"X4" CUT LIMESTONE SCATTERED AROUND THE CENTER OF THE HOLE AS SHOWN IN THE DRAWING. FOUND LARGE WOOD POST 15" DEEP AND REMAINS OF OLD BARB WIRE. PLACED G-1 MONUMENT IN CENTER OF POST ACCEPTED WOOD POST. SET G-1 MONUMENT IN MIDDLE OF POST. THE DIFFERENCES IN VARIANCE IN BEARINGS BETWEEN THE NE CORNER TO THE E 1/4 CORNER AND THE E 1/4 CORNER TO THE SE CORNERS OF SECTION 36 ARE:
LOCKE 0-15'
RUGER 0-17'
NEW BEARINGS 0-17'
- 1981 BARNES VOL 6 PG 27 SHOWS RECORD DISTANCES. SHOWS COR NORTH OF E 1/4 COR SEC 36 UNION TWP
- 1994 KARNS VOL 6 PG 440 FD POST S0-29-09W 11.22 TO E 1/4 COR SEC 36, S00-26-25W 2667.85 TO SW COR SEC 31
- 1994 BARNES X-25 & X-1 SHOWS LIMITS OF A VARY LARGE 3' DEEP HOLE @ THE E 1/4 COR SEC 36 & THE W 1/4 COR SEC 31. PLACED ALUM. MON 15" DEEP @ THE E 1/4 COR SEC 36 & REFERENCED SAME. PLACED G-1 MON 15" DEEP IN WOOD POST @ W 1/4 COR SEC 31 PORTER TWP & REFERENCED SAME. W 1/4 COR SEC 31 IS NO-27-21W 11.22 FROM THE E

SHEET 1 OF 3
CORNER CODE X-1(1)

Donald Barnes
3-18-2009

PO614 W1/4CORSEC31

1/4 COR SEC 36.

DUG VERY LARGE HOLE 3' DEEP WITH BACKHOE AND FOUND NOTHING. DUG BY HAND AT THE W 1/4 COR SEC 31 PORTER TWP & FD 3 PIECES OF 1"X4" CUT LIMESTONE SCATTERED AROUND THE CENTER OF THE HOLE AS SHOWN IN THE DRAWING. FD LARGE WOOD POST 15" DEEP AND REMAINS OF OLD BARB WIRE. PLACED G-1 MON IN CENTER OF POST. RESTORED E 1/4 COR SEC 36 THROUGH ACCEPTANCE OF OBLITERATED EVIDENCE LOCATION. PLACED ALUM. MON. 15" DEEP ON LINE WITH THE W 1/4 COR OF SEC 31 PORTER TWP AND THE SE COR OF SEC 36 UNION TWP AT RUGER'S 1874 DISTANCE OF 11.22'. THE DIFFERENCES IN VARIANCE IN BEARINGS BETWEEN THE NE COR TO THE E 1/4 COR & THE E 1/4 COR E 1/4 COR TO SE COR OF SEC 36 ARE: LOCKE 0-15'; RUGER 0-17'; & NEW BEARING 0-17'

2001 COMBS #7957 ALUM @ E 1/4 COR SEC 36 UNION TWP. 5241.61 TO STONE @ W 1/4 COR SEC 36.

2001 COMBS #14244 ALUM @ E 1/4 COR SEC 36 UNION TWP. 5241.61 TO STONE @ W 1/4 COR SEC 36.

I USED MY 1994 OBSERVATIONS

C) Was the corner restored through acceptance of (1) an obliterated evidence location, or, (2) a found perpetuated location?

ACCEPTED RECORD MONUMENTS.


D) Describe any material discrepancy between the location of the corner as restored or reestablished and the location of that corner as previously restored or reestablished by distance and direction. Show the discrepancy on the plan view drawing under (a), above. Show the distances between the corner as previously restored or reestablished and (1) the corner as restored or reestablished, and (2) to at least 4 of the witness monuments shown on the drawing in (a), above.

NONE

(E) Was the corner reestablished through lost corner proportionate methods? If so, show the method, including the directions and distances to other public land survey corners used as evidence or used for proportioning the corner location.

NO

I, **Donald Barnes**, hereby certify that the corner location as identified by the corner code index was determined by me under my direction and control and that this U.S. Public Land Survey Monument Record is correct and complete to the best of my knowledge and belief.

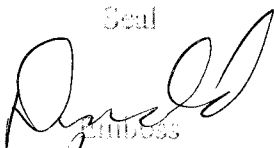Seal


Barnes


3-18-2009

SHEET 2 OF 3

CORNER CODE

X-1(1)

A.E. 7.08 REQUIREMENT

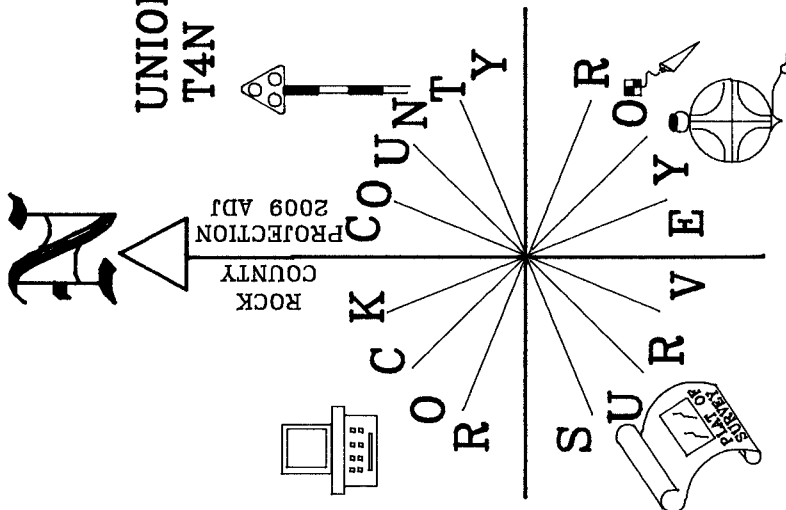

UNION TWP
T4N R10E

PORTER TWP
T4N R11E

CORN FIELD

W 1/4 COR
SEC 31

E 1/4 COR
SEC 36

LIMITS OF 15" DEEP HOLE

LIMITS OF CORN FIELD

LIMITS OF 3' DEEP HOLE

MEADOW

- G-1 MON 15" DEEP IN WOOD POST
- W 1/4 COR SEC 31 PORTER TWP
- ALUM. MON. 15" DEEP
- E 1/4 COR SEC 36 UNION TWP
- 3/4X24 REROD 20" DEEP WITH MAGNET
- 3/4X24 REROD 20" DEEP

EMBOSSSED SEAL
Donald Barnes

3-18-2009

SHEET 3 OF 3

X-1(1)

NOT TO SCALE

MAG TWP FB #4 PG 38,39,41,42