

~~U.S. PUBLIC LAND SURVEY MONUMENT RECORD~~


For Public Land Survey Corners in the
T. 4 N., R. 11 E.

CORNER CODE INDEX

	1	2	3	4	5	6	7	8	9	10	11	12	13	14	15	16	17	18	19	20	21	22	23	24	25
A																									
B																									
C	6																								
D																									
E																									
F																									
G	7																								
H																									
I																									
J																									
K																									
L	18																								
M																									
N																									
O																									
P	19																								
Q																									
R																									
S																									
T	30																								
U																									
V																									
W																									
X	31																								
Y																									
Z																									

PLACE MONUMENT SYMBOL (◆) AT PROPER LOCATION ON ABOVE INDEX

EXAMPLE

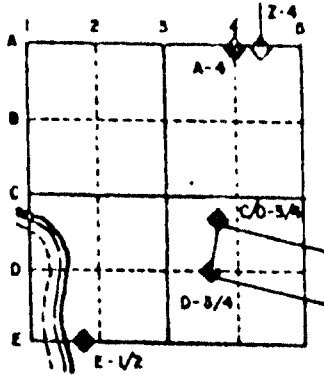

PORTER TWP
ROCK COUNTY WI

IF AVAILABLE
STATE PLANE COORDINATES

North (Y) 328,706.68 Elevation (Z) _____
 East (X) 445,464.50 Zone _____
 Hor. Datum COUNTY Vert. Datum _____

◆ CORNER MONUMENT

○ WITNESS MONUMENT

BEARINGS ARE BASED ON:

MICROFILMED

SHEET ___ OF ___

CORNER CODE: A11(1)

(B) Describe any record evidence, monument evidence, occupational evidence, testimonial evidence or any other material evidence you considered, and whether the monument was found or placed.

1874 RUGER VOL 2 PG 129 ESTABLISHED CORNER FROM SECTION CORNERS. SET HH 26X13X7 & PUT LIMESTONE ON EAST & HH ON WEST. CALLS FOR CORNER TO BE 68.31' EAST OF THE S 1/4 CORNER, 2569.82' TO THE CENTER OF SECTION 4, & 1302.84 TO THE N 1/16th CORNER OF THE NE 1/4 AND THE N 1/16th CORNER OF THE NW 1/4 OF SECTION 4. BY THE VARIANCE HE CALLS FOR THE CORNER TO BE ON A STRAIGHT LINE BETWEEN THE NE & NW CORNERS OF SECTION 4.

1973 LEE VOL 5 PG 45 DUG AND FOUND HH WITH FLAT LIMESTONE STANDING ON E & W 1' DEEP. REFERENCED SAME.

1985 WEIR A-11 I FOUND THE R/R SPIKE & 2 REMAINING TIES AT THE N 1/4 CORNER OF SECTION 4, T4N R11E, AS TIED BY H. LEE AND SHOWN ON HIS ROCK COUNTY TIE SHEET IN VOL 5, P 4 DATED APRIL 3, 1973. I SET ADDITIONAL TIE POINTS AS SHOWN. DANE COUNTY ROAD RECORDS INDICATE THAT MCGINNIS ROAD IS CENTERED ON THE N/S 1/4 LINE OF SECTION 33, T5N R11E. I USED AN EXTENSION OF THE LINE FROM THE NORTHEAST CORNER OF SECTION 4, T4N, R11E THROUGH THE NORTH 1/4 CORNER OF SAID SECTION 4 TO THE INTERSECTION WITH THE CENTERLINE OF MCGINNIS ROAD TO ESTABLISH THE SOUTH 1/4 CORNER OF SAID SECTION 33. STATES THE S 1/4 CORNER OF SECTION 33 (1" IRON PIPE) T5N R11E IS 71.10 WEST.

FOUND R/R SPIKE.

C) Was the corner restored through acceptance of (1) an obliterated evidence location, or, (2) a found perpetuated location?
ACCEPTED FOUND SPIKE AT THE NORTH QUARTER OF SECTION 4.

D) Describe any material discrepancy between the location of the corner as restored or reestablished and the location of that corner as previously restored or reestablished by distance and direction. Show the discrepancy on the plan view drawing under (a), above. Show the distances between the corner as previously restored or reestablished and (1) the corner as restored or reestablished, and (2) to at least 4 of the witness monuments shown on the drawing in (a), above.

(E) Was the corner reestablished through lost corner proportionate methods? If so, show the method, including the directions and distances to other public land survey corners used as evidence or used for proportioning the corner location.

I, Donald Barnes, hereby certify that the corner points as identified by the corner code index were, in a field survey on, Sep 16, 1993, established, re-established, monumented, re-monumented, recovered or restored as expressed below and in conformance with the regulations and rules as required in the current manual of survey instructions of the United States Department of Interior, Bureau of Land Management.

Seal
Donald Barnes
Nov 12, 1993


COUNTY SURVEYOR FILING DATA
Date of computer entry _____
Date microfilmed _____
Number of included sheets 1
CORNER CODE

AFFIX YOUR LAND SURVEYOR SEAL

A11(1)


MCGINNIS RD

FB#3 PG 47

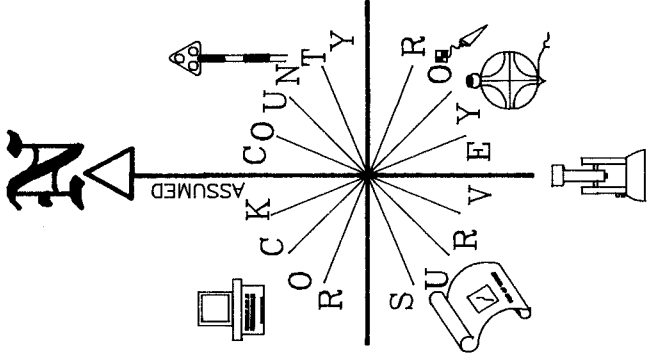

Donald Barnes
 Nov 12/1993

STEBBINSVILLE

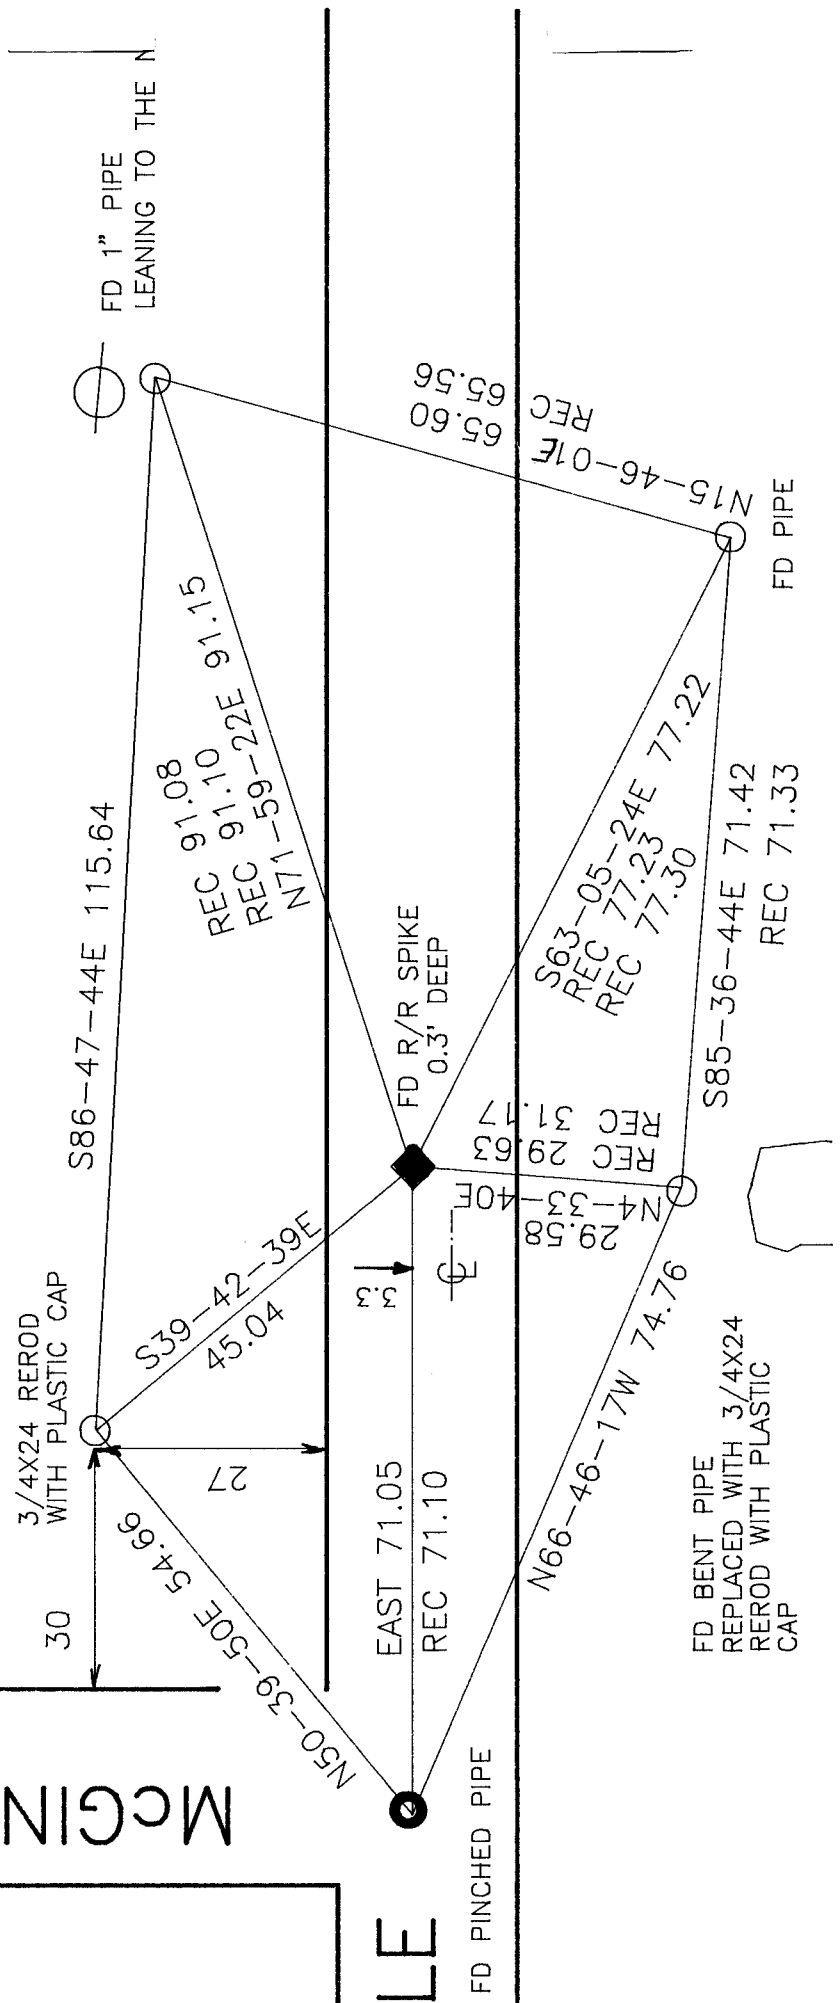

20F 2

A 11 (1)