Paper weight-110# (minimum)

Black nonfading ink required

LAND U.S. PUBLIC SURVEY MONUMENT RECORD


For Public Land Survey Corners In:

WI ADMINISTRATIVE CODE A-E 7.08 REQUIREMENT

REV 10/23/2004 USMONREC.DWG

T. 4 N. R. 11 E. 4th P.M.

CORNER CODE INDEX

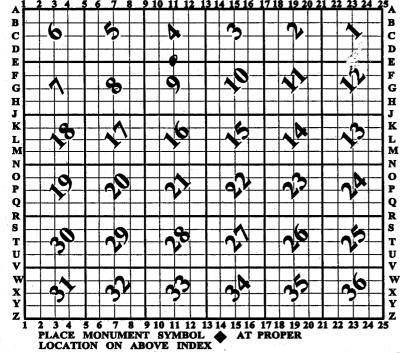

PORTER ROCK COUNTY WI

IF AVAILABLE ROCK COUNTY COORDINATES PERFERRED

Elev. North East

Hor. Datum _____ Vert. Datum

LATITUDE ELLIPS. HT.

LONGITUDE

__NETWORK ADJ. YR_ NAD83(91) _

GPS (X) TRAVERSE (X) _ BASED ON THE FOLLOWING CONTROL:

O WITNESS MONUMENT

◆ CORNER MONUMENT

(a)

BEARINGS ARE BASED ON:

+ 1 · .			· · · · · · · · · · · · · · · · · · ·			-
HITTI D. DOOLS	5.4.675 #	•				
FIELD BOOK			· · · · · · · · · · · · · · · · · · ·	SHEET	_ OF .	
	W DRAWING DEPICTING			RROUNDING		
and the second s	RES, INCLUDING THE E					
PLANNING & ZO	NING COMMITTEE ADOPI	TED THIS FORM ON 12/2	2/1982		1.0	
					///	. \

CORNER CODE 2 //())

P0526

S1/4CORSEC4

(B) Describe any record evidence, monument evidence, occupational evidence, testimonial evidence or any other material evidence you considered, and whether the monument was found or placed.

1833 HARRISON (OCT/NOV) TAN R11E 4TH MER. EAST BET. SECS.

2640.0 TEMPY 1/4 SEC COR.

2871.0 CREEK 19.8' CREEK 19.8' CRS N.E.

5304.42 INT. E BDY 39.60' SOUTH OF POST LAND ROLLING 2^{ND} RATE TIMBER ?? RED & BURR OAK ?? ??? ??? OF WEEDS

WEST COR WEST BET 4 & 9

2652.21 QUARTER SEC. COR. RED OAK 12 N41E 17.82; RED OAK 12 S69E 34.98'.

- 1874 RUGER VOL 2 PG 129. USED TO SUBDIVIDE SECTION 4.
 FOUND STAKE ALSO N.E. BT AND STUMP OF SE BT. CALLS
 FOR 2607.66' FROM CENTER TO W 1/4 CORNER AND
 2594.79 FROM CENTER TO E 1/4 CORNERS OF SECTION 4.
- 1993 BARNES E-11 DUG & FOUND NOTHING. INSTALLED POLY MONUMENT AND YELLOW CARSONITE. RESTORED CORNER THROUGH ACCEPTANCE OF OBLITERATED EVIDENCE LOCATION. USED E/W FENCE TO CONTROL N/S LOCATION. THE E/W LOCATION WAS DETERMINED BY PROJECTING THE NORTH QUARTER CORNER AND CENTER OF SECTION 4. THIS WAS IN HARMONY WITH THE ORIGINAL CALL DISTANCE OF 219' TO THE CREEK.
- 1993 SCHROEDER #10051 STATES NOTHING ABOUT MON. NB9-50-08E 1317.60 TO POB, SB9-32-23W 1028.70 ALONG SOUTH LINE OF SECTION,
- 1995 LATHROP #9359 ALUM. MON EAST 2647.74 TO ALUM @ SE COR SEC 4, NO-16-50E 2663.91 TO ALUM @ CENTER SEC 4.
- 1999 NORTHROP #7419 ALUM MON. NOO-07-12E 2670.06 TO ALUM @ CEN SEC 4, N89-50-08E 2647.76 TO ALUM MON @ SE COR SEC 4.
- 2004 BAKER #14776 ALUM. MON NOO-07-12E 2664.06 TO ALUM @ CEN OF SEC 4, N89-50-08E 2647.76 TO ALUM @ SE COR SEC 4.
- 2008 SANDSNES MAP # FD ROCK COUNTY ALUM MON REPRESENTING THE SOUTH 1/4 COR SEC 4. N89-50-08E 2647.76 TO FD ALUM @ SE COR SEC 4 & NOO-07-08E 2664.00 TO FD ALUM @ CENTER OF SEC 4.

USED MY 1993 DBSERVATIONS

C) Was the corner restored through acceptance of (1) an obliterated evidence location, or, (2) a found perpetuated location?

ACCEPTED POLY MON OF REC.

- D) Describe any material discrepancy between the location of the corner as restored or reestablished and the location of that corner as previously restored or reestablished by distance and direction. Show the discrepancy on the plan view drawing under (a), above. Show the distances between the corner as previously restored or reestablished and (1) the corner as restored or reestablished, and (2) to at least 4 of the witness monuments shown on the drawing in (a), above.
- I, **Donald Barnes**, hereby certify that the corner location as identified by the corner code index was determined by me under my direction and control and that this U.S. Public Land Survey Monument Record is correct and complete to the best of my knowledge and belief.

In Id Baine

SHEET 1 OF 2

CORNER CODE E-11(1)

A.E. 7.08 REQUIREMENT

