



- (b.) Describe any record evidence, monument evidence, occupational evidence, testimonial evidence or any other material evidence you considered, and whether the monument was found or placed.
- 1875 RUGER VOL 2 PG 144 FOUND OLD FENCE POST HOLE AT CORNER ALSO FOUND WHERE STUMPS OF BT HAD BEEN DUG OUT SET HH 27X20X13
- 1877 RUGER VOL 2 PG 229 REFERS TO SURVEY ON PAGE 144
- 1878 RUGER VOL 2 PG 240 NOTES HH 27X2X3
- 1928 NORTHRUP VOL 5 PG 443 DISTANCES TO CORNER BUT STATES NOTHING ABOUT CORNER

(c.) Was the corner restored through acceptance of (1) an obliterated evidence location, or, (2) a found perpetuated location?

(d.) Describe any material discrepancy between the location of the corner as restored or reestablished and the location of that corner as previously restored or reestablished by distance and direction. Show the discrepancy on the plan view drawing under (a), above. Show the distances between the corner as previously restored or reestablished and (1) the corner as restored or reestablished, and (2) to at least 4 of the witness monuments shown on the drawing in (a), above.

(e.) Was the corner reestablished through lost corner proportionate methods? If so, show the method, including the directions and distances to other public land survey corners used as evidence or used for proportioning in determining the corner location.

I, Donald Barnes, hereby certify that the corner points as identified by the corner code index were, in a field survey on July 21 1987, established, re-established, monumented, re-monumented, recovered or restored as expressed below and in conformance with the regulations and rules as required in the current manual of survey instructions of the United States Department of Interior, Bureau of Land Management.

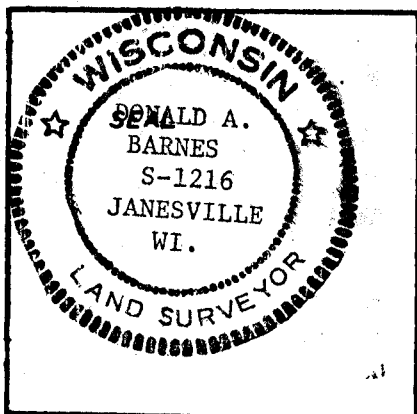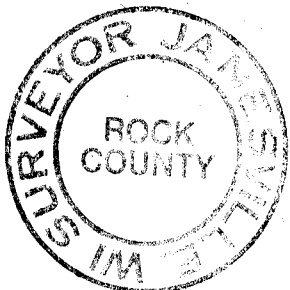

COUNTY SURVEYOR FILING DATA

Date of Computer Entry _____

Date Received _____

Date Microfilmed _____

Treasurer's Receipt No. _____

Number of Included Sheets _____

CORNER CODE _____

AFFIX YOUR LAND SURVEYOR SEAL.

A15