
## RECORD SURVEY MONUMENT LAND U.S. PUBLIC

For Public Land Survey Corners in the T. 3 N., R/2 E

## CORNER CODE INDEX

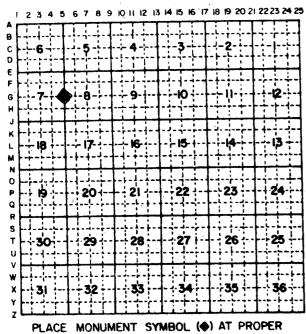

LOCATION ON ABOVE INDEX

EXAMPLE

JANESVILLE TWP ROCK COUNTY

IF AVAILABLE STATE PLANE COORDINATES

Eleve. (z)892,7 North (Y) 270, 125, 59


East (X) 2,238,619,28 Zone

Hor. Datum 897.7 Vert. Datum

270,123,16 2,238,619,41

(a.)

CORNER MONUMENT Fd LARGE Nail PLACED POLYMON O WITNESS MONUMENT

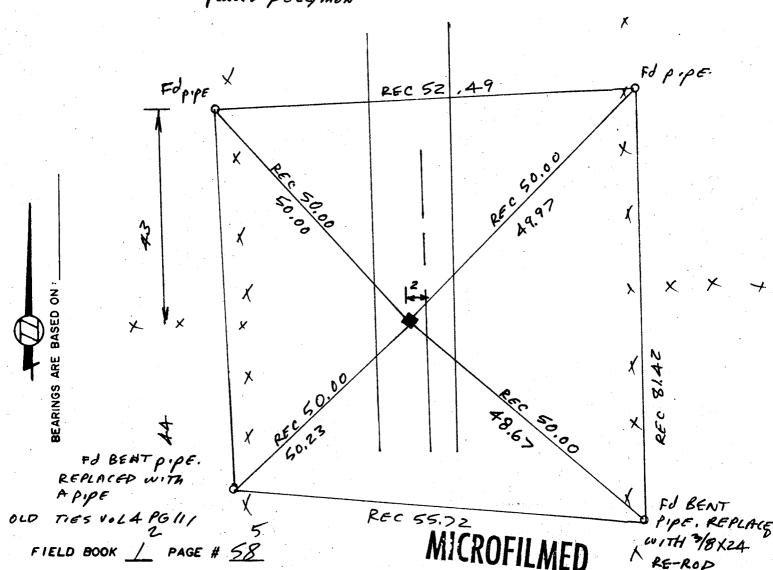

SHOW A PLAN VIEW DRAWING DEPICTING THE CORNER MONUMENT AND SURROUNDING AND DEPTH. THE CORNER MONUMENT SHALL HAVE THE FOLLOWING CHARACTERISTICS: 1) HAVE POINTS, 2) IF BROKEN, LEAVE A PERMANENTLY MAGNETIZED REMNANT AT THE ORIGINAL POINT. 3) MUST BE EXTENDABLE. 4) THE CAP IS INSCRIBED - ROCK COUNTY SURVEY MONUMENT - PENALTY FOR DISTURBING MARKER. 5) OR AN EXISTING CUT LIMESTONE. AN IRON PIPE 1 x 4'0" (MINIMUM) MAY BE USED IN AREAS WHERE GROUND WATER IS WITHIN ONE FOOT OF THE SURFACE. IF THE CORNER IS OCCUPIED BY AN IMPROVEMENT (MANHOLE, BURIED CABLE, ETC.) ANY DURABLE, DISTINCT MONUMENT MAY BE USED. CORNERS SHALL BE REFERENCED WITH AT LEAST 4 DURABLE WITNESS MONUMENTS. WITNESS MONUMENTS SHALL BE MADE OF CONCRETE, NATURAL STONE; IRON OR OTHER EQUALLY DURABLE MATERIAL, EXCEPT WOOD. DESCRIBE THE CORNER AND THE WITNESS MONUMENTS.

CORNER CODE:



(b.) Describe any record evidence, monument evidence, occupational evidence, testimonial evidence or any other material evidence you considered, and whether the monument was found or placed.

1861 RUGER VOL 1 PG 159 SET LIME STONE 16X6X4. SHOWS IT ON LINE & MIDWAY BETWEEN THE NE AND SE CORNERS OF SECTION 7 SHOWS IT ON LINE & MIDWAY BETWEEN

1864 LOCKE VOL 1 PG 215 FOUND LIME STONE SET BY RUGER. PUT ABOVE IT 6 OR 8 LIME STONES IN A HEAP

1884 RUGER VOL 2 PG 386 FOUND LIME STONE & REMAINS OF STUMP OF N.E. BT 1925 ? VOL 3 PG 136 FOUND OLD MONUMENT. SHOWS THAT THE SECTION LINE WAS USED TO ESTABLISH 3 ROD HIGHWAY

1961 BATTERMAN JR. VOL 4 PG 111 FOUND REMAINS OF 16X6X4 LIME STONE SURROUNDED BY 7 STONES

FOUND LARGE NAIL THAT IS HARMONY WITH THE REFERENCE TIES

(c.) Was the corner restored through acceptance of (1) an obliterated evidence location, or, (2) a found perpetuated location?

PERPETUATED LOCATION. FOUND ACCEPTED

(d.) Describe any material discrepancy between the location of the corner as restored or reestablished and the location of that corner as previously restored or reestablished by distance and direction. Show the discrepancy on the plan view drawing under (a), above. Show the distances between the corner as previously restored or reestablished and (1) the corner as restored or reestablished, and (2) to at least 4 of the witness monuments shown on the drawing in (a), above.

Was the corner reestablished through lost corner proportionate methods? If so, show the method, including the directions and distances to other public land survey corners used as evidence or used for proportioning in determining the corner location,

, hereby certify that the corner points the corner code index were, in a field survey on T16 1986 , established, re-established, monumented, re-monumented recovered or restored as expressed below and in conformance with the regulations and rules as required in the current manual of survey instructions of the United States Department of Interior, Bureau of Land Management.





COUNTY SURVEYOR FILING DATA
Date of Computer Entry
Date Received
Date Microfilmed
Treasurer's Receipt No.
Number of Included Sheets

AFFIX YOUR LAND SURVEYOR SEAL. CODE 6