

U.S. PUBLIC LAND SURVEY MONUMENT RECORD

For Public Land Survey Corners in the


T. 3 N., R. 12 E.

CORNER CODE INDEX

	1	2	3	4	5	6	7	8	9	10	11	12	13	14	15	16	17	18	19	20	21	22	23	24	25	
A																										
B																										
C	6																									
D																										
E																										
F																										
G																										
H	7	8	9	10	11	12																				
J																										
K																										
L	18	17	16	15	14	13																				
M																										
N																										
O																										
P	19	20	21	22	23	24																				
Q																										
R																										
S	30	29	28	27	26	25																				
T																										
U																										
V																										
W																										
X	31	32	33	34	35	36																				
Y																										
Z																										

PLACE MONUMENT SYMBOL (◆) AT PROPER LOCATION ON ABOVE INDEX

EXAMPLE

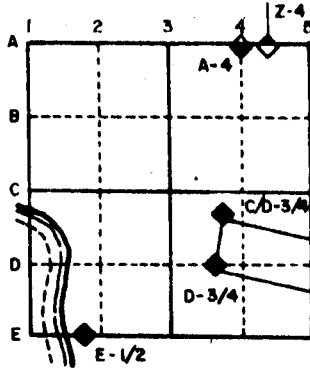

JANESVILLE TWP
ROCK COUNTY WI

IF AVAILABLE
STATE PLANE COORDINATES

North (Y) 264,821.10 Eleve. (Z) _____
 East (X) 2,238,679.80 Zone _____
 Hor. Datum _____ Vert. Datum _____
 555 WPL 264,818.67
 2,238,679.09

(a.)


◆ CORNER MONUMENT

PLACED 5' WHITE PLASTIC T POST ON SOUTH SIDE OF C.1

○ WITNESS MONUMENT

1/2 X 24" RE ROD

BEARINGS ARE BASED ON:

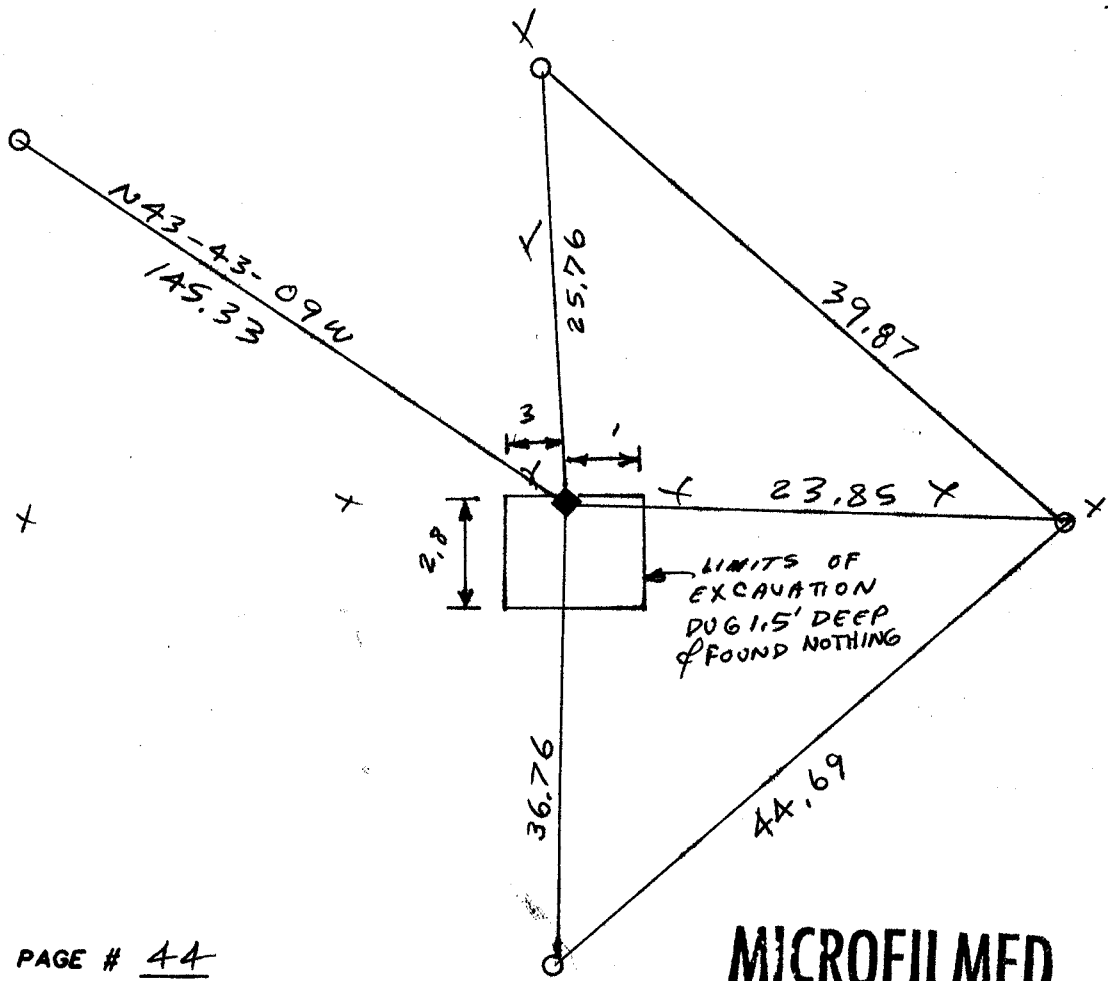

FIELD BOOK 2 PAGE # 44

MICROFILMED

SHOW A PLAN VIEW DRAWING DEPICTING THE CORNER MONUMENT AND SURROUNDING PHYSICAL FEATURES, INCLUDING THE EXCAVATION AREA AND DEPTH. THE CORNER MONUMENT SHALL HAVE THE FOLLOWING CHARACTERISTICS: 1) HAVE AT LEAST TWO PREDETERMINED BREAK-OFF POINTS. 2) IF BROKEN, LEAVE A PERMANENTLY MAGNETIZED REMNANT AT THE ORIGINAL POINT. 3) MUST BE EXTENDABLE. 4) THE CAP IS INSCRIBED: ROCK COUNTY SURVEY MONUMENT - PENALTY FOR DISTURBING MARKER. 5) OR AN EXISTING CUT LIMESTONE. AN IRON PIPE 1 1/2" X 4'0" (MINIMUM) MAY BE USED IN AREAS WHERE GROUND WATER IS WITHIN ONE FOOT OF THE SURFACE. IF THE CORNER IS OCCUPIED BY AN IMPROVEMENT (MANHOLE, BURIED CABLE, ETC.) ANY DURABLE, DISTINCT MONUMENT MAY BE USED. CORNERS SHALL BE REFERENCED WITH AT LEAST 4 DURABLE WITNESS MONUMENTS. WITNESS MONUMENTS SHALL BE MADE OF CONCRETE, NATURAL STONE, IRON OR OTHER EQUALLY DURABLE MATERIAL, EXCEPT WOOD. DESCRIBE THE CORNER AND THE WITNESS MONUMENTS.

CORNER CODE: LS

- (b) Describe any record evidence, monument evidence, occupational evidence, testimonial evidence or any other material evidence you considered, and whether the monument was found or placed.
- 1860 RUGER VOL 1 PG 130 USED THE CORNER TO SUBDIVIDE SECTION 18 BUT STATED NOTHING ABOUT CORNER
- 1868 LOCKE VOL 1 PG 308 FOUND STUMPS OF BTS
- 1871 RUGER VOL 2 PG 54 FOUND STUMPS OF BOTH BTS & WHERE CORNER HAD BEEN DUG OUT SET HH 18X8X6 SURROUNDED BY 4 HH
- 1886 RUGER VOL 2 PG 273 USED TO SUBDIVIDE SECTION 18. STATED NOTHING ABOUT CORNER
- 1970 BATTERMAN JR. VOL 4 PG 430 FOUND STONE. ALSO FOUND LIMESSTONE AT THE 1/16th CORNER TO THE EAST.
- 1976 COMBS PLAT OF SURVEY CALLS FOR A C&I.

I FOUND A CAST IRON MONUMENT

1976 COMBS PLAT OF SURVEY CALLS FOR C&I


- (c) Was the corner restored through acceptance of (1) an obliterated evidence location, or, (2) a found perpetuated location?

ACCEPTED FOUND PERPETUATED LOCATION

- (d) Describe any material discrepancy between the location of the corner as restored or reestablished and the location of that corner as previously restored or reestablished by distance and direction. Show the discrepancy on the plan view drawing under (a), above. Show the distances between the corner as previously restored or reestablished and (1) the corner as restored or reestablished, and (2) to at least 4 of the witness monuments shown on the drawing in (a), above.

- (e) Was the corner reestablished through lost corner proportionate methods? If so, show the method, including the directions and distances to other public land survey corners used as evidence or used for proportioning in determining the corner location.

I, _____, hereby certify that the corner points as identified by the corner code index were, in a field survey on _____, established, re-established, monumented, re-monumented, recovered or restored as expressed below and in conformance with the regulations and rules as required in the current manual of survey instructions of the United States Department of Interior, Bureau of Land Management.

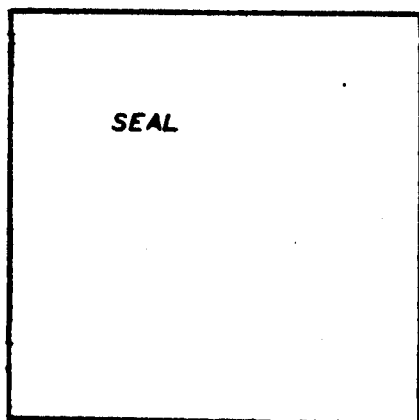

COUNTY SURVEYOR FILING DATA

Date of Computer Entry _____

Date Received _____

Date Microfilmed _____

Treasurer's Receipt No. _____

Number of Included Sheets _____

AFFIX YOUR LAND SURVEYOR SEAL.

CORNER CODE 25