

U.S. PUBLIC LAND SURVEY MONUMENT RECORD

For Public Land Survey Corners in:

WI ADMINISTRATIVE CODE A-E 7.08 REQUIREMENT

T. 3 N., R. 12 E. 4th P.M.

CORNER CODE INDEX

JANESVILLE TWP

ROCK COUNTY, WI

IF AVAILABLE
ROCK COUNTY COORDINATES REFERRED

1	2	3	4	5	6	7	8	9	10	11	12	13	14	15	16	17	18	19	20	21	22	23	24	25
A	6	5	4	3	2	1																		
B																								
C	7	8	9	10	11	12																		
D																								
E																								
F	13	14	15	16	17	18																		
G																								
H																								
I	19	20	21	22	23	24																		
J																								
K																								
L																								
M																								
N	25	26	27	28	29	30																		
O																								
P																								
Q																								
R																								
S																								
T																								
U																								
V																								
W																								
X																								
Y																								
Z																								

North _____ Elev. _____

East _____

Hor. Datum _____ Vert. Datum _____

LATITUDE _____ ELLIPS. HT. _____

LONGITUDE _____

ELLIPS. DATUM _____

NAD83(91) _____ COUNTY _____ LIST _____

GPS (X) _____ TRAVERSE (X) _____


BASED ON THE FOLLOWING CONTROL:

PLACE MONUMENT SYMBOL \blacklozenge AT PROPER LOCATION ON ABOVE INDEX

\blacklozenge CORNER MONUMENT
FD, 3/4" DIA. ROD

\bullet WITNESS MONUMENT
 \bullet FD, 3/4" DIA. ROD.
 \bullet FD, 1/2" INSIDE DIA. IRON PIPE

BEARINGS ARE BASED ON: E. LINE, NE 1/4 OF SEC. 22 (ASSUMED N. 01° 28' 20" E)

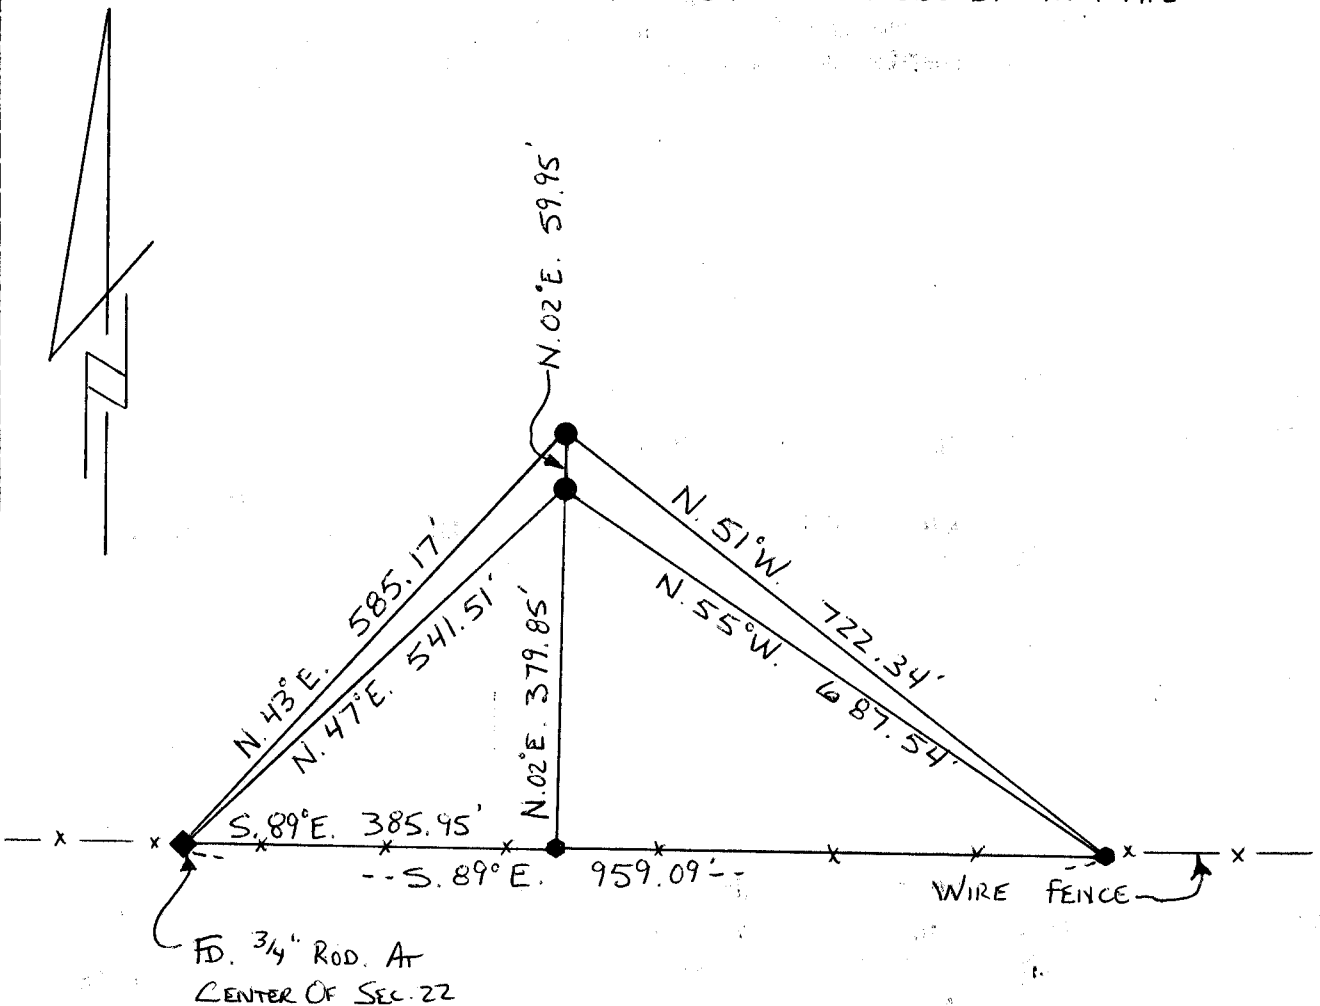

FIELD BOOK _____ PAGE # _____ SHEET _____ OF _____

SHOW A PLAN VIEW DRAWING DEPICTING THE CORNER MONUMENT AND SURROUNDING PHYSICAL FEATURES, INCLUDING THE EXCAVATION AREA AND DEPTH.

PLANNING & ZONING COMMITTEE ADOPTED THE ABOVE FORM ON 12/2/1982

CORNER CODE P 15

B) Describe any record evidence, monument evidence, occupational evidence, testimonial evidence or any other material evidence you considered, and whether the monument was found or placed.

On a Plat Of Survey by Richard L. Thom, dated July 20, 1977, Mr. Thom shows that he set a 1" pin at the center of Section 22. On C.S.M. No. 935213, by Richard L. Thom, recorded on Feb. 3, 1981 in Vol. 10, Pg. 205 of Certified Surveys, Card 68, Image 735, Mr. Thom shows that he set a 3/4" at the center of Section 22. The 3/4" rod I found and show on this Monument Record fits Mr. Thom's recorded position.

C) Was the corner restored through acceptance of (1) an obliterated evidence location, or, (2) a found perpetuated location?

Found perpetuated location.

D) Describe any material discrepancy between the location of the Corner as restored or reestablished and the location of that corner as previously restored or reestablished by distance and direction. Show the discrepancy on the plan view drawing under (a), above. Show the distances between the corner as previously restored or reestablished and (1) the corner as restored or reestablished, and (2) to at least 4 of the witness monuments shown on the drawing in (a), above.

No discrepancy.


E) Was the corner reestablished through lost corner proportionate methods? If so, show the method, including the directions and distances to other public land survey corners used as evidence or used for proportioning the corner location.

No.

I, *Mark T. Krizan*, hereby certify that the corner location as identified by the corner code index was determined by me under by direction and control and that this U.S. Public Land Survey Monument Record is correct and complete to the best of my knowledge and belief.

seal

emboss/stamped

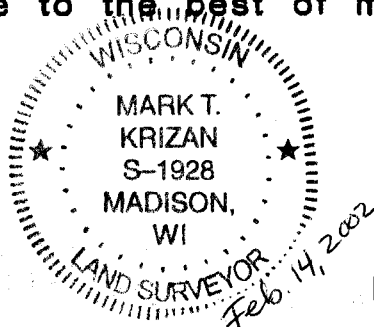

Number of included sheets _____

A-E 7.08 REQUIREMENT

CORNER CODE

P15