

# U.S. PUBLIC LAND SURVEY MONUMENT RECORD

For Public Land Survey Corners in the


T. 3 N., R. 12 E.

## CORNER CODE INDEX

	1	2	3	4	5	6	7	8	9	10	11	12	13	14	15	16	17	18	19	20	21	22	23	24	25
A																									
B																									
C	6																								
D		5																							
E			4																						
F				3																					
G					2																				
H																									
I																									
J	7																								
K		8																							
L			9																						
M				10																					
N					11																				
O						12																			
P	13																								
Q		14																							
R			15																						
S				16																					
T					17																				
U						18																			
V							19																		
W								20																	
X									21																
Y										22															
Z											23														
												24													
													25												
														26											
															27										
																28									
																	29								
																		30							
																			31						
																				32					
																					33				
																						34			
																							35		
																								36	

PLACE MONUMENT SYMBOL (◆) AT PROPER LOCATION ON ABOVE INDEX

### EXAMPLE

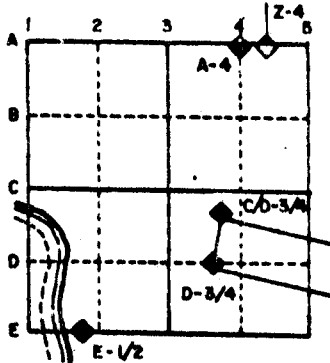

JANESVILLE TWP  
ROCK COUNTY WI

### IF AVAILABLE STATE PLANE COORDINATES

North (Y) \_\_\_\_\_ Eleve. (Z) \_\_\_\_\_  
 East (X) \_\_\_\_\_ Zone \_\_\_\_\_  
 Hor. Datum \_\_\_\_\_ Vert. Datum \_\_\_\_\_

o.)

◆ CORNER MONUMENT

○ WITNESS MONUMENT

BEARINGS ARE BASED ON:

MICROFILMED

SHEET \_\_\_ OF \_\_\_

CORNER CODE: X 13

# PRESERVATION OF LANDMARKS

BOOK \_\_\_\_\_ PAGE 5

SECTION 59,635(7) WISCONSIN STATUTES  
 COUNTY ROCK

TOWN JANESVILLE


HIGHWAY ST.H. 11

SECTION NO. 34


T. 3 N., R. 12 E.

TYPE OF LANDMARK 3/4" IRON PIN

LOCATION INDICATED ON SKETCH X

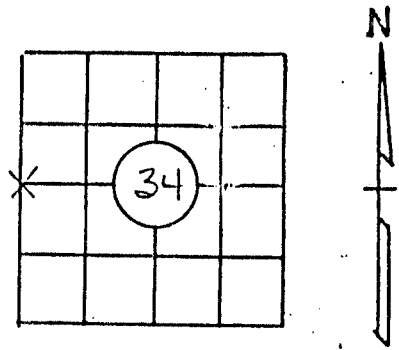

LOCATION SKETCH

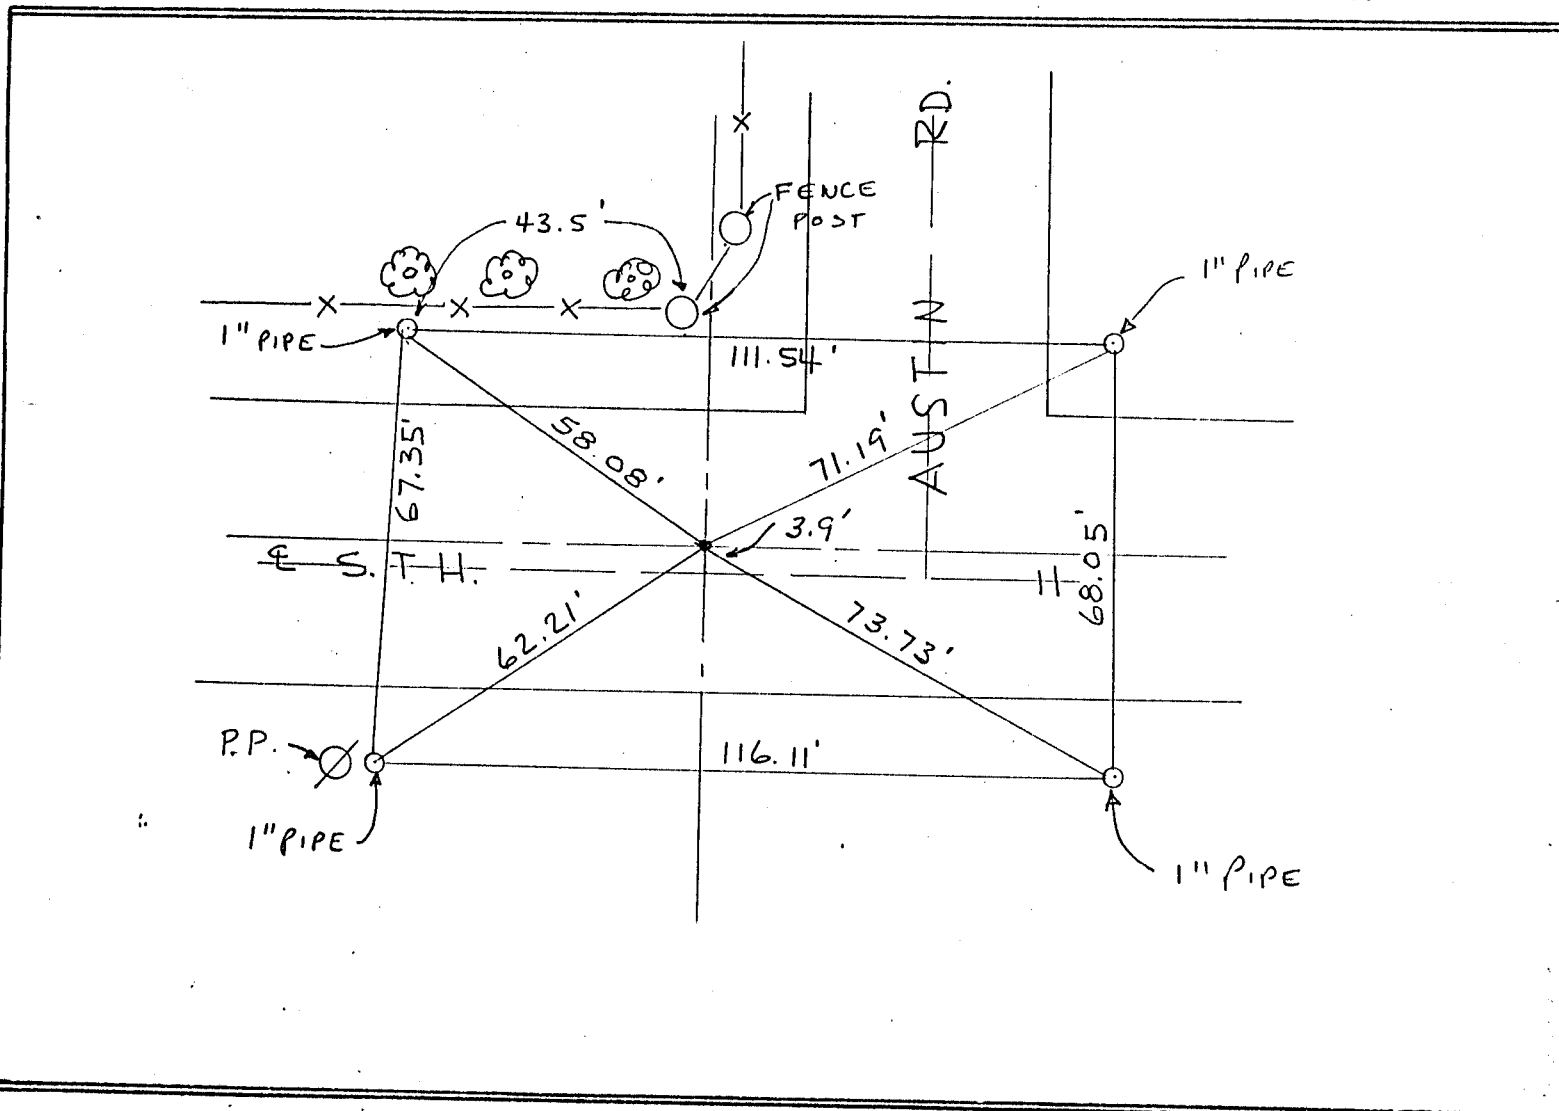

Located and referenced by: R7B 3-11, 1970  
 Field notes recorded 3-11, 1970 in Book 152 on Page 25  
 Copy sent to County Surveyor's Office \_\_\_\_\_, 19\_\_\_\_  
 Drawn by: \_\_\_\_\_

150  
 X13