



(b.) Describe any record evidence, monument evidence, occupational evidence, testimonial evidence or any other material evidence you considered, and whether the monument was found or placed.



- 1866 LOCKE VOL 1 PG 250 FOUND STUMPS OF BT & OLD STAKE SET GRAY HH 16X10X7
- 1868 LOCKE VOL PG FOUND STUMPS OF BT & STONE SET BY SELF. STONE IN END OF FENCE RUNNING EAST
- 1964 BATTERMAN JR. VOL 4 PG 207 DUG LARGE HOLE 20X15X3 AND FOUND NOTHING
- 1970 BATTERMAN JR. VOL 4 PG 430 SET 1" PIPE FROM EXISTING MONUMENTS. SHOWS STONE AT W<sup>1</sup>/<sub>4</sub> CORNER, LIMESTONE AT 1/16th CORNER TO THE EAST, & SPIKE SET BY SHIMEALL AT THE CENTER.
- 1981 BARNES VOL 6 PG 133 FOUND 1" PIPE & SHOWS DISTANCES BY HURD, COMBS, THOM.
- 1981 BARNES VOL 6 PG 136 PLACED ALUMINUM MONUMENT

(c.) Was the corner restored through acceptance of (1) an obliterated evidence location, or, (2) a found perpetuated location?

(d.) Describe any material discrepancy between the location of the corner as restored or reestablished and the location of that corner as previously restored or reestablished by distance and direction. Show the discrepancy on the plan view drawing under (a), above. Show the distances between the corner as previously restored or reestablished and (1) the corner as restored or reestablished, and (2) to at least 4 of the witness monuments shown on the drawing in (a), above.

(e.) Was the corner reestablished through lost corner proportionate methods? If so, show the method, including the directions and distances to other public land survey corners used as evidence or used for proportioning in determining the corner location.

I, Donald Barnes, hereby certify that the corner points as identified by the corner code index were, in a field survey on April 3, 1987, established, re-established, monumented, re-monumented, recovered or restored as expressed below and in conformance with the regulations and rules as required in the current manual of survey instructions of the United States Department of Interior, Bureau of Land Management.

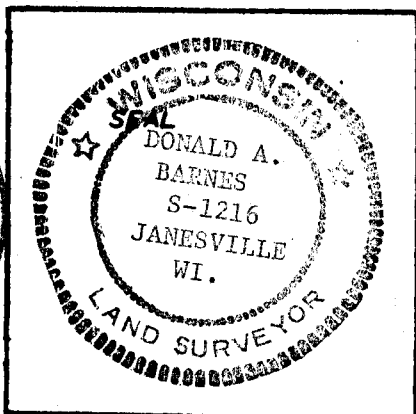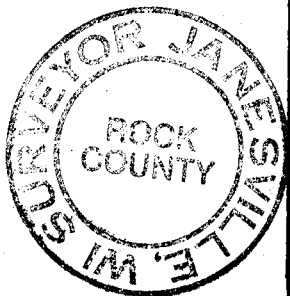

COUNTY SURVEYOR FILING DATA

Date of Computer Entry \_\_\_\_\_

Date Received \_\_\_\_\_

Date Microfilmed \_\_\_\_\_

Treasurer's Receipt No. \_\_\_\_\_

Number of Included Sheets \_\_\_\_\_

AFFIX YOUR LAND SURVEYOR SEAL. CORNER CODE 49