



(b.) Describe any record evidence, monument evidence, occupational evidence, testimonial evidence or any other material evidence you considered, and whether the monument was found or placed.

IN 1958 THE WI DEPARTMENT OF TRANSPORTATION DUG & FOUND THE CUT LIMESTONE & REFERENCED IT WITH WOOD HUBS. THE DESIGN PLANS RECORD THE ORIGINAL GROUND ELEVATION AS 831' AND THE DESIGN ELEVATION AS 835'.


- 1) 1863 LOCKE ESTABLISHED THE CORNER ON LINE WITH THE NW & NE CORNERS OF SECTION 32 AT MID POINT.
- 2) 1871 RUGER FOUND THE CORNER AND REPLACED IT WITH A CUT LIMESTONE. HIS FIELD NOTES INDICATES A DISTANCE OF 2665.74' FROM THE NW TO N 1/4 CORNERS OF SECTION 32 AND A DISTANCE OF 2667.72' FROM THE N 1/4 TO THE NE CORNERS OF SECTION 32. HIS VAR ALSO INDICATES THAT THE CORNER WAS NOT ON LINE WITH THE NW & NE CORNERS OF SECTION 32.
- I ESTABLISHED THE CORNER ON LINE WITH THE NW & NE CORNERS OF SECTION 32 AT MID POINT. THIS IS IN HARMONY WITH LOCKE'S DISTANCE TO THE SOUTH QUARTER CORNER SECTION 32.

(c.) Was the corner restored through acceptance of (1) an obliterated evidence location, or, (2) a found perpetuated location?


no

(d.) Describe any material discrepancy between the location of the corner as restored or reestablished and the location of that corner as previously restored or reestablished by distance and direction. Show the discrepancy on the plan view drawing under (a), above. Show the distances between the corner as previously restored or reestablished and (1) the corner as restored or reestablished, and (2) to at least 4 of the witness monuments shown on the drawing in (a), above.

(e.) Was the corner reestablished through lost corner proportionate methods? If so, show the method, including the directions and distances to other public land survey corners used as evidence or used for proportioning in determining the corner location.

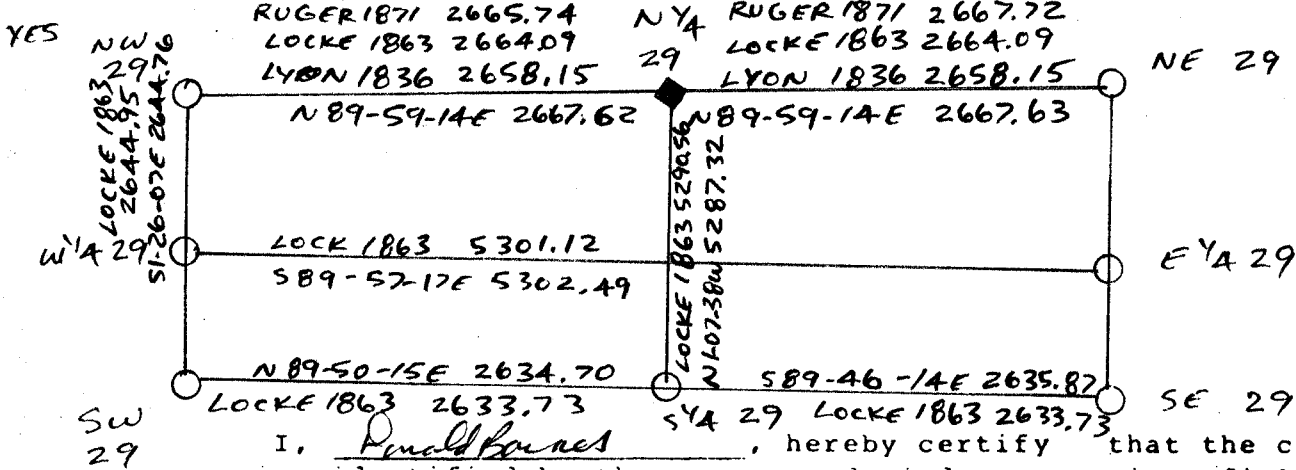

I, Ronald Barnes, hereby certify that the corner points as identified by the corner code index were, in a field survey on May 19 1986, established, re-established, monumented, re-monumented recovered or restored as expressed below and in conformance with the regulations and rules as required in the current manual of survey instructions of the United States Department of Interior, Bureau of Land Management.

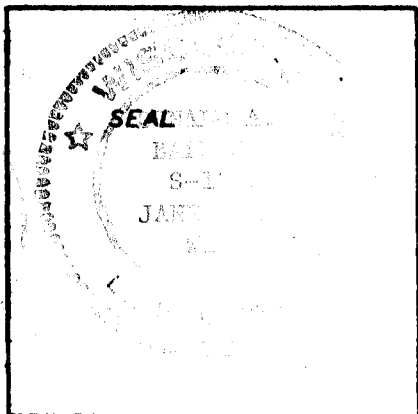

COUNTY SURVEYOR FILING DATA

Date of Computer Entry \_\_\_\_\_

Date Received \_\_\_\_\_

Date Microfilmed \_\_\_\_\_

Treasurer's Receipt No. \_\_\_\_\_

Number of Included Sheets \_\_\_\_\_

AFFIX YOUR LAND SURVEYOR SEAL. CORNER CODE 7(1)