

U.S. PUBLIC LAND SURVEY MONUMENT RECORD


For Public Land Survey Corners in the
T. 2 N., R. 13 E.

CORNER CODE INDEX

	1	2	3	4	5	6	7	8	9	10	11	12	13	14	15	16	17	18	19	20	21	22	23	24	25
A																									
B																									
C	6																								
D		5																							
E			4																						
F				3																					
G					2																				
H																									
I																									
J	7																								
K		6																							
L			5																						
M				4																					
N					3																				
O						2																			
P							1																		
Q	8																								
R		7																							
S			6																						
T				5																					
U					4																				
V						3																			
W							2																		
X								1																	
Y	9																								
Z		8																							

PLACE MONUMENT SYMBOL (◆) AT PROPER LOCATION ON ABOVE INDEX

EXAMPLE

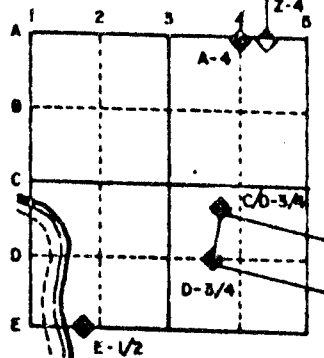

LA PRAIRIE TWP
ROCK COUNTY WI


IF AVAILABLE
STATE PLANE COORDINATES

North (Y) _____ Eleve. (Z) _____
 East (X) _____ Zone _____
 Hor. Datum _____ Vert. Datum _____


e.)

◆ CORNER MONUMENT

○ WITNESS MONUMENT

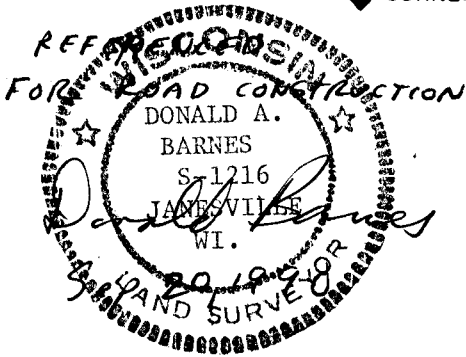

BEARINGS ARE BASED ON: ASSUMED

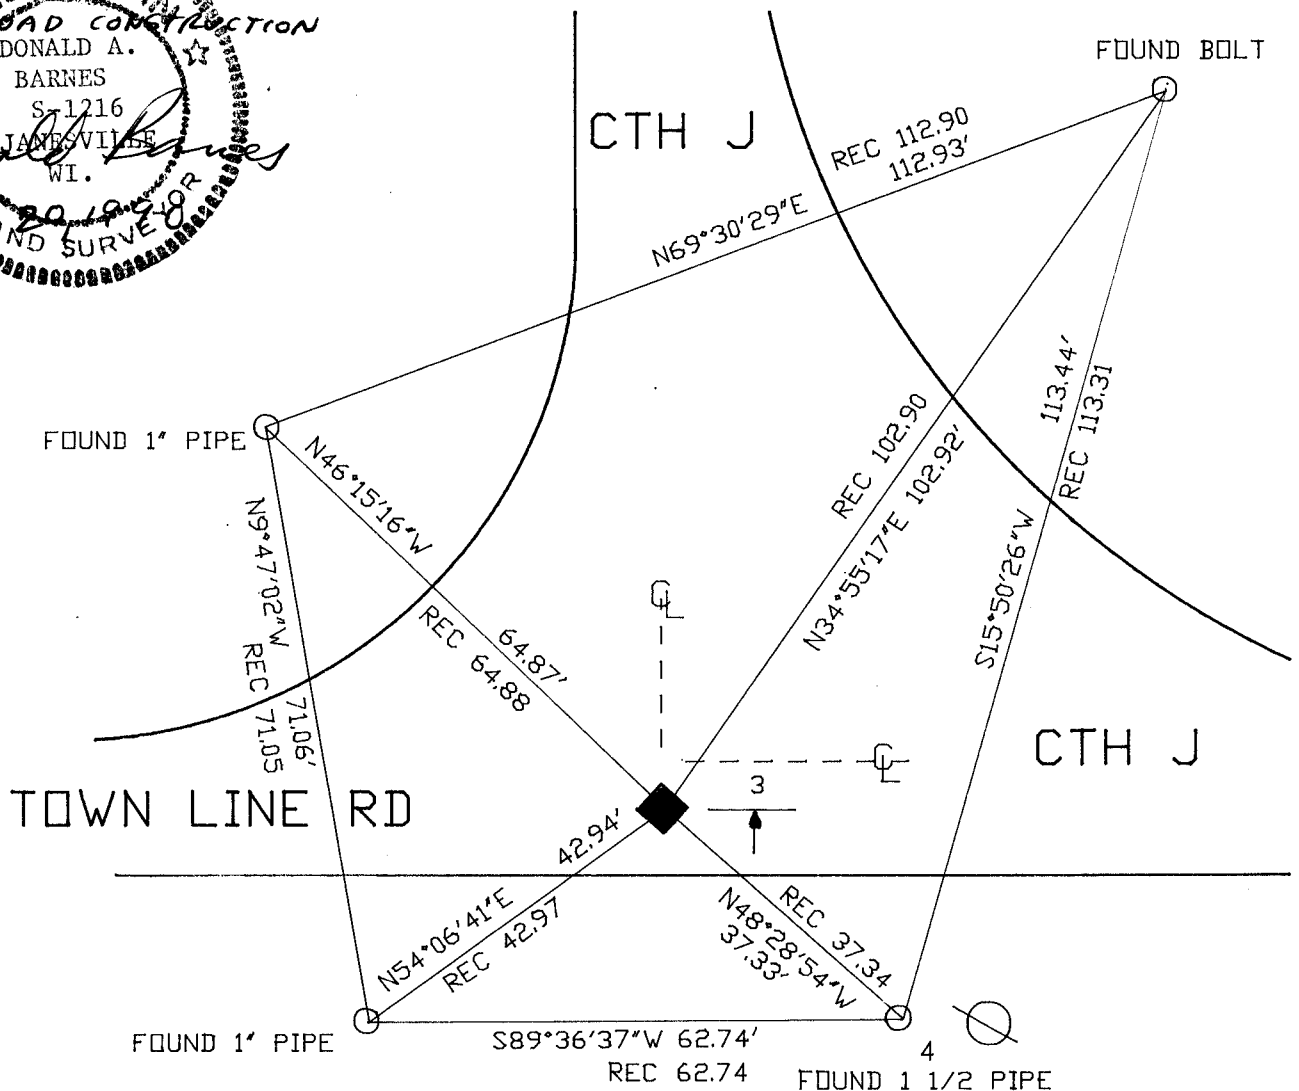

FIELD BOOK #3 PG 60

MICROFILMED

SHEET ___ OF ___

CORNER CODE: 29 (2)