

(b.) Describe any record evidence, monument evidence, occupational evidence, testimonial evidence or any other material evidence you considered, and whether the monument was found or placed.

1968 BATTERMAN JR. VOL 4 PG 387 DRAWING INDICATES THAT IT IS THE INTERSECTION OF THE QUARTER LINES.
1985 BARNES U.S. PUBLIC LAND SURVEY MONUMENT RECORD. FOUND PIPE AS RECORDED IN VOL 4 PG 387. PIPE IS WITHIN .1 N/S & .1 E/W OF THE INTERSECTION OF THE 1/4 LINES. REPLACED PIPE WITH POLY MONUMENT.

FOUND WOOD HUB THAT D.O.T CREW PLACED


(c.) Was the corner restored through acceptance of (1) an obliterated evidence location, or, (2) a found perpetuated location?

ACCEPTED FOUND MONUMENT

(d.) Describe any material discrepancy between the location of the corner as restored or reestablished and the location of that corner as previously restored or reestablished by distance and direction. Show the discrepancy on the plan view drawing under (a), above. Show the distances between the corner as previously restored or reestablished and (1) the corner as restored or reestablished, and (2) to at least 4 of the witness monuments shown on the drawing in (a), above.

(e.) Was the corner reestablished through lost corner proportionate methods? If so, show the method, including the directions and distances to other public land survey corners used as evidence or used for proportioning in determining the corner location.

I, Donald Barnes, hereby certify that the corner points as identified by the corner code index were, in a field survey on JUNE 5 1989, established, re-established, monumented, re-monumented, recovered or restored as expressed below and in conformance with the regulations and rules as required in the current manual of survey instructions of the United States Department of Interior, Bureau of Land Management.

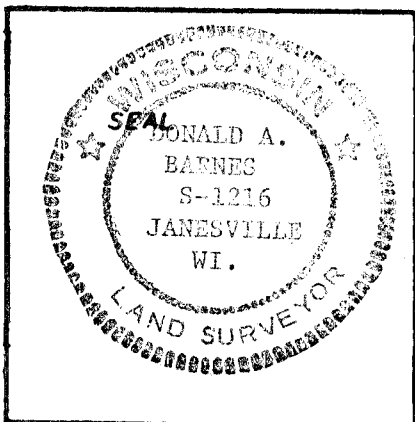

COUNTY SURVEYOR FILING DATA

Date of Computer Entry _____

Date Received _____

Date Microfilmed _____

Treasurer's Receipt No. _____

Number of Included Sheets _____

CORNER CODE L3(1)

AFFIX YOUR LAND SURVEYOR SEAL.

