
PUBLIC LAND

SURVEY

MONUMENT RECORD

For Public Land Survey Corners in: T._N., R.___E

CORNER CODE INDEX

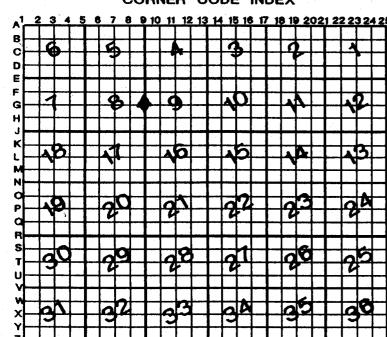

WI ADMINISTRATIVE CODE A-E 7.08 REQUIREMENT

NEWARK TWP ROCK COUNTY WI

IF AVAILABLE ROCK COUNTY COORDINATES PERFERRED

North Elev.

Hor. Datum _____ Vert. Datum

LONGITUTE ____

GPS (X) ___ TRAVERSE (X)

BASED ON THE FOLLOWING CONTROL:

♦CORNER MONUMENT

LOCATION ON ABOVE INDEX

O WITNESS MONUMENT

Ö BEARINGS ARE BASED

(a)

Fd or x po 163

OBSERVATION Sheet 591

FIELD BOOK _____PAGE #

SHEET .

SHOW A PLAN VIEW DRAWING DEPICTING THE CORNER MONUMENT AND SURROUNDING PHYSICAL FEATURES, INCLUDING THE EXCAVATION AREA AND DEPTH.

PLANNING & ZONING COMMITTEE ADOPTED THE ABOVE FORM ON 12/2/1982

corner code G9 (1

NE536

(B)Describe any record evidence, monument evidence, occupational evidence, testimonial evidence or any other material evidence you considered, and whether the monument was found or placed.

1834 MILLER

PG 29

NORTH BETWEEN 8 & 9

1320 LEAVE MARSH

1749 BUR OAK 16 IN DIAMETER

2600.4 BUR OAK 12 IN DIAMETER

2640 SET 1/4 SEC POST. BUR OAK 14 N31W 24.42' BUR OAK 14 S15E 28.38'

3876.84 HICKORY 12 IN DIAMETER

4676.1 WHITE OAK 20 IN DIAMETER

5045.04 BUR OAK 12 IN DIAMETER

5280 SET POST COR OF SEC 4,5,8,9

BUR OAK 12 S32E 11.88'; BUR OAK 12 N25W 85.8' LAND SLIGHTLY ROLLING 2ND RATE TIMBER OAK & HICKORY

1871 COLLINS REMONUMENTATION

PG 183 NORTH BETWEEN 8 & 9 VARIATION 6

2652.54 INTERSECT 1/4 LINE 21.12' EAST OF CORNER. SET 1/4 STONE BY WITNESS TREE AND STUMP CORRECTED VARIATION 5-32

CONTINUED NORTH VARIATION 5-50

5308.38 INTERSECT SECTION LINE 6.6' EAST OF CORNER. SET STONE FOR CORNER OF 4,5,8,9 IN PLACE OF STAKE AGREEING WITH STUMPS OF WITNESS TREES. CORRECTED VARIATION 5-41

1882 HOLMES VOL 2 PG 348 CALLS FOR MON BUT STATES NOTHING ABOUT IT. 2641.32 TO CENTER OF SEC 9 & 5282.64 TO E 1/4 COR SEC 9

1963 BATTERMAN VOL 4 PG 163 SET MON. BOX OVER 1" PIPE. FD CUT STONE MON. & REFERENCED SAME.

1989 BARNES VOL 6 PG 401 FD PIPE IN MON. BOX S0-40-57E 2664.15 TO ERRONEOUS COR AT SW COR SEC 9, S0-39-12E 2654.00 TO SW COR SEC 9, & ANGLE OF 91-25-46 @ SW COR SEC 9 FROM W 1/4 COR TO S 1/4 CORNERS OF SEC 9.

1989 BARNES G-9 FD 1" PIPE IN MON. BOX & EXISTING REFERENCE TIES.

FD 1" PIPE IN MON. BOX @ CENTER OF N/S PVMT & 3' NORTH OF CENTER OF E/W PVMT.

C) Was the corner restored through acceptance of (1) an obliterated evidence location, or, (2) a found perpetuated location?

ACCEPTED FOUND PERPETUATED LOCATION

- D) Describe any material discrepancy between the location of the corner as restored or reestablished and the location of that corner as previously restored or reestablished by distance and direction. Show the discrepancy on the plan view drawing under (a), above. Show the distances between the corner as previously restored or reestablished and (1) the corner as restored or reestablished, and (2) to at least 4 of the witness monuments shown on the drawing in (a), above.
- (E) Was the corner reestablished through lost corner proportionate methods? If so, show the method, including the directions and distances to other public land survey corners used as evidence or used for proportioning the corner location.
- I, Donald Barnes, hereby certify that the corner location as identified by the corner code index was determined by me under my direction and control and that this U.S. Public Land Survey Monument Record is correct and complete to the best of my knowledge and belief.

seal

Number of included sheets 1

emboss
29-01

CORNER CODE G-9(1)