

# U.S. PUBLIC LAND SURVEY MONUMENT RECORD

For Public Land Survey Corners in:

WI ADMINISTRATIVE CODE A-E 7.08 REQUIREMENT

T. 1N., R. 11E

### CORNER CODE INDEX

A	1	2	3	4	5	6	7	8	9	10	11	12	13	14	15	16	17	18	19	20	21	22	23	24	25
B																									
C	6																								
D																									
E																									
F																									
G	7																								
H																									
I																									
J																									
K																									
L	18																								
M																									
N																									
O																									
P	19																								
Q																									
R																									
S																									
T	30																								
U																									
V																									
W																									
X	31																								
Y																									
Z																									

NEWARK TWP  
ROCK COUNTY WI

IF AVAILABLE  
ROCK COUNTY COORDINATES PREFERRED

North \_\_\_\_\_ Elev. \_\_\_\_\_

East \_\_\_\_\_

Hor. Datum \_\_\_\_\_ Vert. Datum \_\_\_\_\_

LATITUDE \_\_\_\_\_ ELLIPS. HT. \_\_\_\_\_

LONGITUDE \_\_\_\_\_

GPS (X) \_\_\_\_\_ TRAVERSE (X) \_\_\_\_\_

BASED ON THE FOLLOWING CONTROL:

PLACE MONUMENT SYMBOL  AT PROPER LOCATION ON ABOVE INDEX

CORNER MONUMENT

WITNESS MONUMENT

(a)

BEARINGS ARE BASED ON:

OBSERVATION sheet 415

FIELD BOOK \_\_\_\_\_ PAGE # \_\_\_\_\_

SHEET \_\_\_\_\_ OF \_\_\_\_\_

SHOW A PLAN VIEW DRAWING DEPICTING THE CORNER MONUMENT AND SURROUNDING PHYSICAL FEATURES, INCLUDING THE EXCAVATION AREA AND DEPTH.

PLANNING & ZONING COMMITTEE ADOPTED THE ABOVE FORM ON 12/2/1982

CORNER CODE N 9 (1)

NE565

(B) Describe any record evidence, monument evidence, occupational evidence, testimonial evidence or any other material evidence you considered, and whether the monument was found or placed.

- 1834 MILLER *EAST RANDOM BETWEEN SECS 17 & 20*
- 330 ENTER MARSH C S.E.
- 2112 LEAVE SAME
- 5272.74 SEC LINE 13.2' NORTH OF POST LAND 2ND RATE  
*WEST CORRECTED BETWEEN SECS 17 & 20*
- 2636.04 SET 1/4 SEC POST YELLOW OAK 5 IN N20E 30.36'; BUR OAK 22  
S30W 9.24'
- 5272.74 SEC COR  
*NORTH BETWEEN 16 & 17*
- 172.92 BUR OAK 14 IN
- 313.5 CREEK 6.6 S.E.
- 2640 SET 1/4 SEC POST IN CREEK BOTTOM. TOO WET TO MOUND
- 5280 SET POST CORNER OF SEC 8,9,15,17  
BUR OAK 12 IN S79E 366.96', YELLOW OAK 10 IN N82-30E 288.42'  
LAND MARSHY & POOR 2ND RATE, ASPEN WILLOW U.G.  
*EAST RANDOM BETWEEN SECS 16 & 21*
- 211.2 CREEK S 6.6'
- 858 LEAVE CREEK BOTTOM
- 3696 MARSH (CIRCULAR)
- 4620 LEAVE SAME
- 5264.82 INTERSECT SEC LINE 5.94' SOUTH OF POST  
LAND GENTLY ROLLING 2ND RATE TIMBER OAK & HICKORY OAK &  
HAZEL U.G. (UNDER GROWTH)  
*WEST CORRECTED BETWEEN SECS 16 & 21*
- 2632.08 SET 1/4 SEC POST BUR OAK 16 N6W 31.68; BUR OAK 12 S77E 40.26'
- 2921.82 YELLOW OAK 14 IN DIA
- 3806.22 BUR OAK 15 IN DIA
- 5264.82 SEC COR  
*NORTH BETWEEN SECS 20 & 21*
- 462 ENTER MARSH CR E
- 2244 LEAVE SAME
- 2640 SET 1/4 SEC POST YELLOW OAK 28 N34W 30.36'; YELLOW OAK 8 S56E  
83.16'
- 2844.6 YELLOW OAK 28 IN DIA.
- 4260.96 BUR OAK 15 IN DIA
- 5280 COR OF SECS 16,17, 20, & 21. A BUR OAK 20 IN DIAMETER LAND 2ND  
RATE WITH MARSHY SPOTS THINLY TIMBERED
- 1871 COLLINS. FIELD NOTES *PG 191 EAST BETWEEN 17 & 20 VAR 7*
- 2651.88 SET 1/4 STONE IN LINE WITH FENCES NORTH & SOUTH BY  
ROOTS OF WITNESS TREES. CONTINUED EAST VARIATION 8-15
- 5305.74 SECTION CORNER NOV 1, 1871  
*PG 181 NORTH BETWEEN 16 & 17 VARIATION 4-45*
- 313.5 CREEK
- 2638.68 SET 1/4 STONE IN MARSH IN LINE WITH FENCES EAST AND  
WEST AND ON WEST SIDE OF NORTH AND SOUTH DITCH.  
*CONTINUED NORTH VARIATION 5-30*
- 5293.86 INTERSECT SECTION LINE 5.94' EAST OF CORNER. SET  
STONE FOR CORNER OF 8,9,16,17 BY STUMP OF WITNESS  
TREE. CORRECTED VARIATION 5-22  
*PG 180 EAST BETWEEN 16 & 21 VARIATION 4-45*
- 231 CREEK
- 2638.02 INTERSECT 1/4 LINE 4.62' NORTH OF CORNER SET 1/4 STONE IN PLACE  
OF STAKE AND STONES. CORRECTED VARIATION 4-51  
*CONTINUED EAST VARIATION 4-30*

Donald Baines  
6-29-01

SHEET 1 OF 2

N9(1)

2636.04 SET 1/4 STONE BY STUMPS OF WITNESS TREES

CONTINUED NORTH VARIATION 5-45

5270.1 INTERSECT SECTION LINE 11.22' WEST OF CORNER. SET STONE FOR CORNER OF 16,17 20,21 IN PLACE OF STUMP OF CORNER TREE. CORRECTED VARIATION 6-0

1989 BARNES VOL 6 PG 401 2637.34 TO S 1/4 COR SEC 16, 2653.28 TO S 1/4 COR SEC 17, 2637.76 TO W 1/4 COR SEC 16, 2633.15 TO W 1/4 COR SEC 21, ANGLE OF 90-55-46 @ SW COR SEC 16 FROM W 1/4 TO S 1/4 CORNERS OF SEC 16, ANGLE OF 89-12-54 @ SW COR SEC 16 FROM N 1/4 TO W 1/4 CORNERS OF SEC 21, ANGLE OF 88-44-14 @ NE COR SEC 20 FROM E 1/4 TO N 1/4 CORNERS OF SEC 21, & ANGLE OF 91-07-06 @ SE COR SEC 17 FROM S 1/4 TO E 1/4 CORNERS OF SEC 17.

1989 BARNES N-9 DUG A FOUR FEET DEEP HOLE AND FOUND NOTHING. THERE WAS NO BLACK DIRT IN THE HOLE. EXCAVATION AND SURROUNDING LAND INDICATES THAT THE MONUMENT WAS PROBABLY DESTROYED BY ROAD CONSTRUCTION. I PLACED AN ALUMINUM MONUMENT AT THE CORNER. I USED COLLINS DISTANCES TO THE S 1/4 AND W 1/4 CORNERS OF SECTION 16 AND THE NW AND E 1/4 CORNERS OF SECTION 20 FOR PRORATION. COR IS 1.5' NORTH OF CENTER OF PVMT.

1997 HOULE CSM 20-351 2637.33 TO S 1/4 COR SEC 16

USED MY 1989 OBSERVATIONS FOR TOWNSHIP REMONUMENTATION PROJECT.

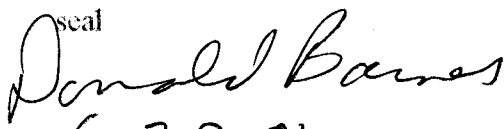
*C) Was the corner restored through acceptance of (1) an obliterated evidence location, or, (2) a found perpetuated location?*

ACCEPTED ALUM. MON. AS PERPETUATED LOCATION.

*D) Describe any material discrepancy between the location of the corner as restored or reestablished and the location of that corner as previously restored or reestablished by distance and direction. Show the discrepancy on the plan view drawing under (a), above. Show the distances between the corner as previously restored or reestablished and (1) the corner as restored or reestablished, and (2) to at least 4 of the witness monuments shown on the drawing in (a), above.*

*(E) Was the corner reestablished through lost corner proportionate methods? If so, show the method, including the directions and distances to other public land survey corners used as evidence or used for proportioning the corner location.*

I, Donald Barnes, hereby certify that the corner location as identified by the corner code index was determined by me under my direction and control and that this U.S. Public Land Survey Monument Record is correct and complete to the best of my knowledge and belief.

seal  
  
6-29-01

emboss

SHEET 2 OF 2

CORNER CODE **N-9(1)**

A-E 7.08 REQUIREMENT