

PUBLIC LAND SURVEY MONUMENT RECORD


For Public Land Survey Corners in the

T. 1 N., R. 13 E.

CORNER CODE INDEX

	1	2	3	4	5
A					
B	6	5	4	3	2
C					
D					
E					
F					
G	7	8	9	10	11
H					
I					
J					
K					
L	16	17	18	15	14
M					
N					
O					
P	19	20	21	22	23
Q					
R					
S					
T	24	25	26	27	28
U					
V					
W					
X					
Y	29	30	31	32	33
Z					
	34	35	36		

EXAMPLE

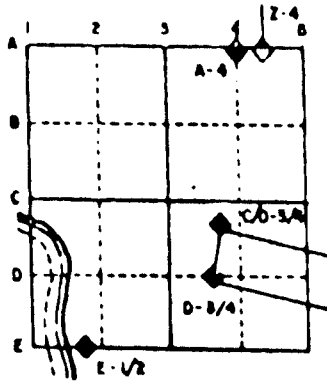

TURTLE TWP
ROCK COUNTY WI

IF AVAILABLE
STATE PLANE COORDINATES

North (Y) 227,423.87 Elev. (Z) _____

East (X) 509,393.40 Zone _____

Hor. Datum COUNTY Vert. Datum _____

PLACE MONUMENT SYMBOL (◆) AT PROPER LOCATION ON ABOVE INDEX

◆ CORNER MONUMENT

○ WITNESS MONUMENT

BEARINGS ARE BASED ON:

TU 526

(B) Describe any record evidence, monument evidence, occupational evidence, testimonial evidence or any other material evidence you considered, and whether the monument was found or placed.

- 1836 LYON SET QUARTER SECTION POST B OAK 19 N11E 194 & BUR OAK 20 S85E 213. CALLS FOR 2635.05 TO SE & SW CORNERS OF SECTION 4.
- 1840 TERRITORIAL RD RECORDS. CORNER IS 26.4' E OF N/S CENTER OF ROAD.
- 1882 HOLMES VOL 2 PG 356 CEDAR STAKE L.S. ON TOP USED TO SUBDIVIDE SEC 9 5305.08 TO S 1/4 COR SEC 9, 2619.54 TO CENTER OF SECTION 9.
- 1882 LEE VOL 2 PG 368 DROVE RED CEDAR STAKE PUT A L.S. ON TOP. 2617.56 TO CENTER 9. USED TO SUBDIVIDE SEC 9. 2647.10 FROM CENTER TO E 1/4 CORNERS SEC 9 & 2659.14 FROM CENTER TO W 1/4 CORNERS OF SECTION 9.
- 18?? RUGER VOL 2 PG 522 RED CEDAR STAKE L.S. ON TOP OF STAKE & L.S. ON TOP OF L.S. 2647.26 TO SE 4 & 2658.48 TO CENTER OF SEC 4.
- 1919 BATTERMAN VOL 3 PG 80 FOUND 2" GAS PIPE SURROUNDED BY 3 L.S. 5312.25 TO S 1/4 COR SEC 9. GP IS 8'3" EAST OF LINE BETWEEN N 1/4 & S 1/4 CORNERS OF SECTION 9.
- 1964 BATTERMAN VOL 4 PG 203 FOUND PIN SET BY SHIMEALL & REFERENCED SAME.
- 1964 BATTERMAN VOL 4 PG 204 PIN.

FOUND NAIL OVER PIN AND REFERENCE PIPES.

C) Was the corner restored through acceptance of (1) an obliterated evidence location, or, (2) a found perpetuated location?
ACCEPTED FOUND MONUMENT.

D) Describe any material discrepancy between the location of the corner as restored or reestablished and the location of that corner as previously restored or reestablished by distance and direction. Show the discrepancy on the plan view drawing under (a), above. Show the distances between the corner as previously restored or reestablished and (1) the corner as restored or reestablished, and (2) to at least 4 of the witness monuments shown on the drawing in (a), above.

(E) Was the corner reestablished through lost corner proportionate methods? If so, show the method, including the directions and distances to other public land survey corners used as evidence or used for proportioning the corner location.
NO

I, Donald Barnes, hereby certify that the corner points as identified by the corner code index were, in a field survey on, _____, 199____, established, re-established, monumented, re-monumented, recovered or restored as expressed below and in conformance with the regulations and rules as required in the current manual of survey instructions of the United States Department of Interior, Bureau of Land Management.

COUNTY SURVEYOR FILING DATA

Date of computer entry _____

Date microfilmed _____

Number of included sheets _____

CORNER CODE _____

seal

Donald Barnes
6/12/95

EMBOSS LAND SURVEYOR SEAL

E11

