

PUBLIC LAND SURVEY MONUMENT RECORD

For Public Land Survey Corners in the


T. 1N., R. 13E.

CORNER CODE INDEX

	1	2	3	4	5	6	7	8	9	10	11	12	13	14	15	16	17	18	19	20	21	22	23	24	25
A																									
B																									
C	6	5	4	3	2																				
D																									
E																									
F																									
G	7	8	9	10	11	12																			
H																									
I																									
J																									
K																									
L	16	17	18	19	20	21																			
M																									
N																									
O																									
P	19	20	21	22	23	24																			
Q																									
R																									
S																									
T	30	29	28	27	26	25																			
U																									
V																									
W																									
X																									
Y	31	32	33	34	35	36																			

PLACE MONUMENT SYMBOL (◆) AT PROPER LOCATION ON ABOVE INDEX

EXAMPLE

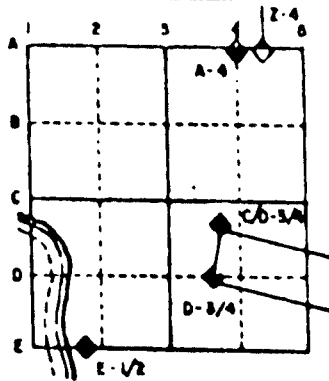

TURTLE TWP
ROCK COUNTY WI

IF AVAILABLE
STATE PLANE COORDINATES

North (Y) 200,853.46 Elev. (Z) _____

East (X) 509,424.25 Zone _____

Hor. Datum COUNTY Vert. Datum _____

◆ CORNER MONUMENT
Fd ALUM MON

○ WITNESS MONUMENT

Fd TIES IN VOL 5 pg 45A

BEARINGS ARE BASED ON:

TU626

(B) Describe any record evidence, monument evidence, occupational evidence, testimonial evidence or any other material evidence you considered, and whether the monument was found or placed.

1833 LYONS SET POST FOR 1/4 SEC. CORNER IN SAID P???. BUR OAK 12 N9W 428 & BUR OAK 9 N6E 432.

1978 BARNES DUG & FOUND NOTHING. SET ALUM. MON. ON LINE WITH CONCRETE MON. TO THE EAST & SW COR SEC 33 & AT SIGNLE PROP DISTANCE FROM THE SW CORNER SEC 33 & S 1/4 COR SEC 36. REFERENCED SAME. MON IS 2' NORTH OF E/W FENCE & 12' WEST OF N/S FENCE.

1978 BARNES VOL 5 PG 456 2642.90 TO SW COR SEC 33, 2642.9 TO SE COR SEC 33, 827.92 TO N 1/4 COR SEC 1, AN ANGLE OF 179-58-58 AT S 1/4 COR SEC 33 FROM SW COR SEC 33 TO THE SE COR SEC 33.

1979 BARNES VOL 5 PG 539 2642.9 TO S S1/4 COR SEC 33, ANGLE OF 179-58-58 AT N 1/4 COR4 SEC 1 FROM S 1/4 COR SEC 33 TO SE COR SEC 33, 827.96 TO N 1/4 COR SEC 1. FOUND ALUM MON.

1991 BATTERMAN VOL 6 PG 413 2642.87 TO SW COR SEC 33 & AN ANGLE OF 179-51-01 AT SW COR SEC 33 FROM S 1/4 COR SEC 33 TO NE COR SEC 3.

C) Was the corner restored through acceptance of (1) an obliterated evidence location, or, (2) a found perpetuated location?

ACCEPTED FOUND PERPETUATED LOCATION.

D) Describe any material discrepancy between the location of the corner as restored or reestablished and the location of that corner as previously restored or reestablished by distance and direction. Show the discrepancy on the plan view drawing under (a), above. Show the distances between the corner as previously restored or reestablished and (1) the corner as restored or reestablished, and (2) to at least 4 of the witness monuments shown on the drawing in (a), above.

(E) Was the corner reestablished through lost corner proportionate methods? If so, show the method, including the directions and distances to other public land survey corners used as evidence or used for proportioning the corner location.

NO

I, Donald Barnes, hereby certify that the corner points as identified by the corner code index were, in a field survey on, 1994, established, re-established, monumented, re-monumented, recovered or restored as expressed below and in conformance with the regulations and rules as required in the current manual of survey instructions of the United States Department of Interior, Bureau of Land Management.

COUNTY SURVEYOR FILING DATA

seal

Date of computer entry _____

Date microfilmed _____

Number of included sheets _____
CORNER CODE



EMBOSS LAND SURVEYOR SEAL

A-E 7.08 REQUIREMENT

3/12/95

211