

PUBLIC LAND SURVEY MONUMENT RECORD

For Public Land Survey Corners in the


T. 1 N., R. 13 E.

CORNER CODE INDEX

1	2	3	4	5	6	7	8	9	10	11	12	13	14	15	16	17	18	19	20	21	22	23	24	25
A																								
B	6	5	4	3	2																			
C																								
D	7	8	9	10	11	12																		
E																								
F																								
G	16	17	18	19	20	21	22	23	24															
H																								
I																								
J																								
K																								
L																								
M																								
N																								
O																								
P	29	28	27	26	25																			
Q																								
R																								
S																								
T																								
U																								
V																								
W																								
X																								
Y																								
Z																								

PLACE MONUMENT SYMBOL (●) AT PROPER LOCATION ON ABOVE INDEX

EXAMPLE

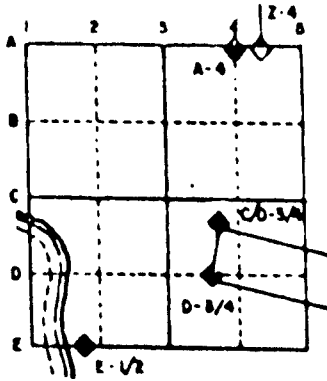

TURTLE TWP
ROCK COUNTY WI

IF AVAILABLE
STATE PLANE COORDINATES



North (Y) 232,520.80 Elev. (Z) _____
East (X) 528,008.58 Zone _____
Hor. Datum COUNTY Vert. Datum _____

◆ CORNER MONUMENT

○ WITNESS MONUMENT

BEARINGS ARE BASED ON:

E 1/4 COR
SEC 36

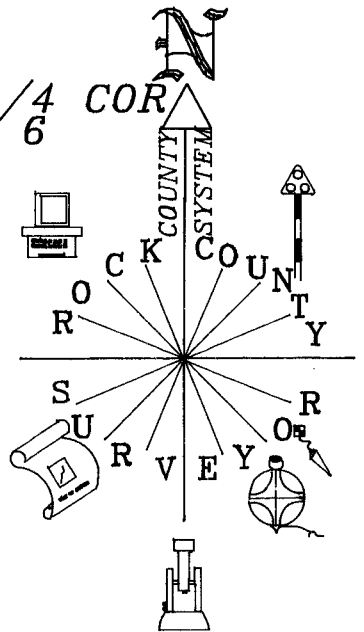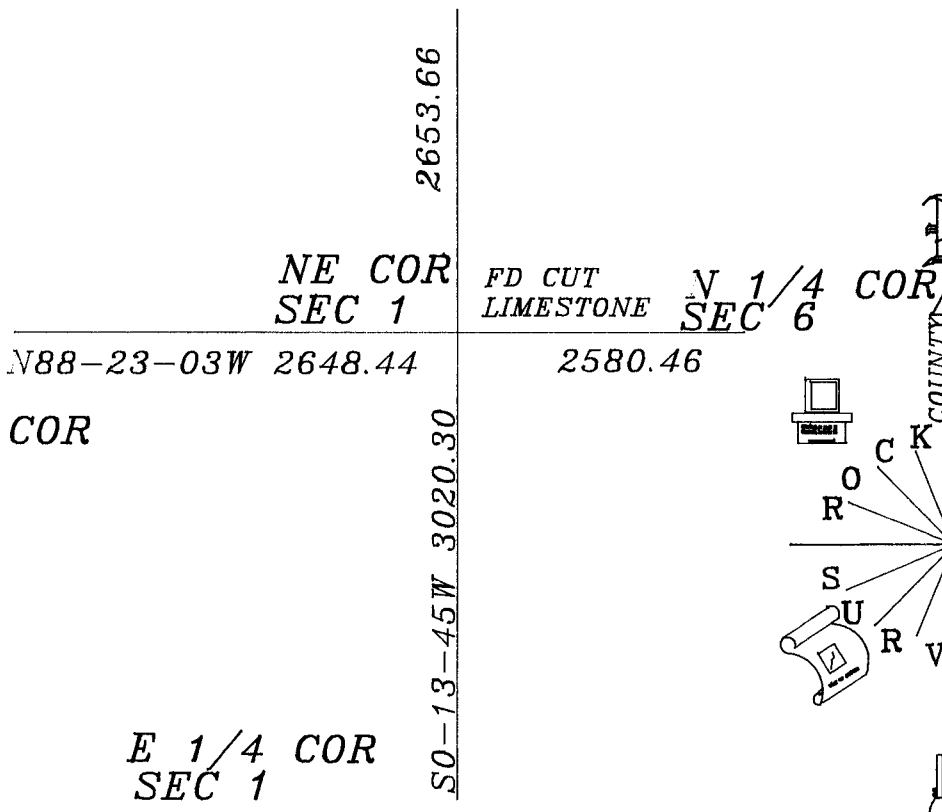

SHEET _____ OF _____

A 25

CORNER CODE:

(B) Describe any record evidence, monument evidence, occupational evidence, testimonial evidence or any other material evidence you considered, and whether the monument was found or placed.

- 1835 ORIGINAL PLAT CALLS FOR 3003 TO E 1/4 COR SEC 1.
- 1860 RUGER SET LIMESTONE 24X11X8 SURROUNDED BY 4 LIMESTONES. 2652.21 TO W 1/4 COR SEC 31, 2580.27 TO S 1/4 COR SEC 31.
- 1867 LOCKE VOL 1 PG 298 FOUND CORNER AS SET BY RUGER. 2613.76 TO S 1/4 COR SEC 31.
- 1867 LOCKE VOL 1 PG 294 FOUND CORNER AS SET BY RUGER.
- 1871 RUGER REMONUMENTATION NOTES. INTERSECTED EAST BOUNDARY LINE 12.54' NORTH OF CORNER. FOUND REMAINS OF OLD STAKE & LIMESTONE AT CORNER. COR VAR 4-27. CALLS FOR 2619.70 TO S 1/4 COR SEC 36, 2651.55 TO E 1/4 COR SEC 36.
- 1881 HOLMES VOL 2 PG 344 CALLS FOR A MONUMENT BUT STATES NOTHING ABOUT IT. 2648.36 TO N 1/4 COR SEC 1, 1324.18 TO S 1/16TH COR THAT IS TO THE WEST.
- 1970 BATTERMAN VOL 4 PG 476 FOUND SQUARE LIMESTONE AT TOWNSHIP CORNER. WEST OF N/S FENCE & NORTH OF E/W FENCE LINE.
- 1980 BARNES VOL 6 PG 47 FOUND CUT LIMESTONE. 2580.46 TO N 1/4 COR SEC 6.
- 1981 BARNES CLINTON TWP PROJECT CALLS FOR 3020.41 TO E 1/4 COR SEC 1 & 2580.46 TO N 1/4 COR SEC 6.
- 1986 BARNES LA PRAIRIE TWP PROJECT CALLS FOR 2653.66 TO E 1/4 COR SEC 36.

FOUND CUT LIMESTONE N88-23-03W 2648.44 TO N 1/4 COR SEC 1 & S0-13-45W 3020.30 TO E 1/4 COR SEC 1.

C) Was the corner restored through acceptance of (1) an obliterated evidence location, or, (2) a found perpetuated location?
ACCEPTED FOUND PERPETUATED LOCATION.

D) Describe any material discrepancy between the location of the corner as restored or reestablished and the location of that corner as previously restored or reestablished by distance and direction. Show the discrepancy on the plan view drawing under (a), above. Show the distances between the corner as previously restored or reestablished and (1) the corner as restored or reestablished, and (2) to at least 4 of the witness monuments shown on the drawing in (a), above.

(E) Was the corner reestablished through lost corner proportionate methods? If so, show the method, including the directions and distances to other public land survey corners used as evidence or used for proportioning the corner location.
NO

I, Donald Barnes, hereby certify that the corner points as identified by the corner code index were, in a field survey on, 1994, established, re-established, monumented, re-monumented, recovered or restored as expressed below and in conformance with the regulations and rules as required in the current manual of survey instructions of the United States Department of Interior, Bureau of Land Management.

seal

Donald Barnes
7/12/95

EMBOSS LAND SURVEYOR SEAL

COUNTY SURVEYOR FILING DATA

Date of computer entry _____

Date microfilmed _____

Number of included sheets _____
CORNER CODE

A-E 7.08 REQUIREMENT

A25