

# PUBLIC LAND SURVEY MONUMENT RECORD

For Public Land Survey Corners in the


T. 1 N., R. 13 E.

## CORNER CODE INDEX

	1	2	3	4	5	6	7	8	9	10	11	12	13	14	15	16	17	18	19	20	21	22	23	24	25
A																									
B																									
C																									
D																									
E																									
F																									
G																									
H																									
I																									
J																									
K																									
L																									
M																									
N																									
O																									
P																									
Q																									
R																									
S																									
T																									
U																									
V																									
W																									
X																									
Y																									
Z																									

PLACE MONUMENT SYMBOL (◆) AT PROPER LOCATION ON ABOVE INDEX

### EXAMPLE

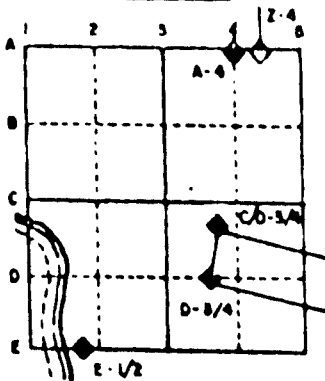

TURTLE TWP  
ROCK COUNTY WI

IF AVAILABLE  
STATE PLANE COORDINATES

North (Y) 229,500.53 Elev. (Z) \_\_\_\_\_  
 East (X) 527,996.51 Zone \_\_\_\_\_  
 Hor. Datum COUNTY Vert. Datum \_\_\_\_\_

◆ CORNER MONUMENT

○ WITNESS MONUMENT

BEARINGS ARE BASED ON:

W 1/4 COR SEC 1 N87-37-03W 5304.17

NE COR SEC 1

NO-13-45E 3020.30


FD CONC MON  
E 1/4 COR SEC 1

S46-15-11W 3684.08

S 1/4 COR SEC 1

SE COR SEC 1

SO-16-41W 2649.48

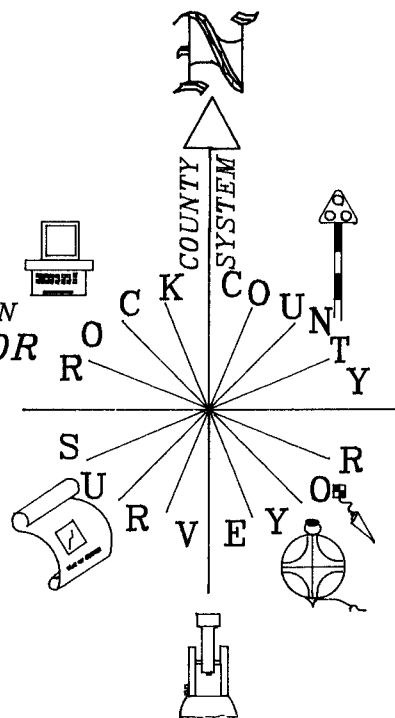

SHEET \_\_\_\_\_ OF \_\_\_\_\_

C25

CORNER CODE: \_\_\_\_\_

(B) Describe any record evidence, monument evidence, occupational evidence, testimonial evidence or any other material evidence you considered, and whether the monument was found or placed.

- 1867 LOCKE VOL 1 PG 294 FOUND STAKE. SUBDIVIDED SEC 1.
- 19?? KERCH VOL 6 PG 414 FOUND SOME EVIDENCE OF OLD CORNER IN LINE OF FENCES EAST & NORTH. SET HH 24X18X12 SURROUNDED BY 4HH & 1 LIMESTONE. 2650.1 TO SE COR SEC 1, 2635.6 TO R/R TRACKS, & ANGLE OF 90-06 FROM SE COR SEC 1 TO FENCE POST AT CENTER OF SEC 1.
- 1970 BATTERMAN VOL 4 PG 476 FOUND HH & LIMESTONE BY FENCE CORNER A HH 24X18X12 ON ITS' SIDE. SET CONCRETE MONUMENT. REC 2650. TO SE COR SEC 1.
- 1971 LEE VOL 4 PG 529 SEE VOL 4 PG 476. 1332.41 TO N 1/16TH COR OF THE SW 1/4 SEC 6 & REC 2650 TO SE COR SEC 1.
- 197? WIDOT VOL 6 PG 55&120 FOUND CONCRETE MON. NAD 27 N/S 211,187.94;E/W 2,297,944.61
- 1981 BARNES CLINTON TWP PROJECT 2649.51 TO SE COR SEC 1 & 3020.41 TO NE COR SEC 1.

FOUND CONCRETE MONUMENT.

C) Was the corner restored through acceptance of (1) an obliterated evidence location, or, (2) a found perpetuated location?  
ACCEPTED FOUND PERPETUATED LOCATION.

D) Describe any material discrepancy between the location of the corner as restored or reestablished and the location of that corner as previously restored or reestablished by distance and direction. Show the discrepancy on the plan view drawing under (a), above. Show the distances between the corner as previously restored or reestablished and (1) the corner as restored or reestablished, and (2) to at least 4 of the witness monuments shown on the drawing in (a), above.

(E) Was the corner reestablished through lost corner proportionate methods? If so, show the method, including the directions and distances to other public land survey corners used as evidence or used for proportioning the corner location.  
NO

I, Donald Barnes, hereby certify that the corner points as identified by the corner code index were, in a field survey on, 1994, established, re-established, monumented, re-monumented, recovered or restored as expressed below and in conformance with the regulations and rules as required in the current manual of survey instructions of the United States Department of Interior, Bureau of Land Management.

seal  
*Donald Barnes*  
7/15/95

COUNTY SURVEYOR FILING DATA

Date of computer entry \_\_\_\_\_

Date microfilmed \_\_\_\_\_

Number of included sheets \_\_\_\_\_

CORNER CODE

EMBOSS LAND SURVEYOR SEAL

A-E 7.08 REQUIREMENT