

PUBLIC LAND SURVEY MONUMENT RECORD


For Public Land Survey Corners in the

T. 1 N., R. 13 E

**CORNER CODE INDEX**

	1	2	3	4	5	6
A						
B						
C	6					
D		5				
E			4			
F				3		
G					2	
H						
I						
J						
K						
L	7					
M		6				
N			5			
O				4		
P					3	
Q						2
R						
S						
T						
U						
V						
W						
X						
Y						
Z						

**EXAMPLE**

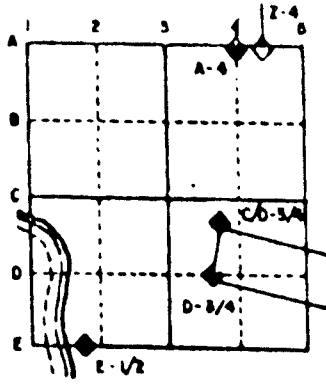

TURTLE TWP  
ROCK COUNTY WI

IF AVAILABLE  
 STATE PLANE COORDINATES

North (Y) 216,241.40 Elev. (Z) \_\_\_\_\_  
 East (X) 527,940.85 Zone \_\_\_\_\_  
 Hor. Datum COUNTY Vert. Datum \_\_\_\_\_

PLACE MONUMENT SYMBOL (◆) AT PROPER LOCATION ON ABOVE INDEX

◆ CORNER MONUMENT

○ WITNESS MONUMENT

BEARINGS ARE BASED ON:

(B) Describe any record evidence, monument evidence, occupational evidence, testimonial evidence or any other material evidence you considered, and whether the monument was found or placed.

- 1835 BRINK (TWP LINE) SET POST CORNER SECTIONS 13 & 24 BUR OAK 13 S154W 54.12' & BUR OAK 14 N82W 172.92'
- 1836 LYON (CLINTON TWP FIRST PART OF APRIL) INTERSECTED RANGE LINE 97.68' NORTH OF POST. CALLS FOR 2521.86 TO S 1/4 COR SEC 18.
- 1836 LYON (TURTLE TWP LAST PART OF APRIL) INTERSECTED RANGE LINE 48.84' NORTH OF POST. CALLS FOR 2653.86 TO S 1/4 COR SEC 13.
- 1859 RUGER VOL 1 PG 94 2649.24 VAR 7-36 TO W 1/4 COR SEC 18 & 2532.64 VAR 6-44 TO S 1/4 COR SEC 18.
- 1867 LOCKE VOL 1 PG 283 AT SE COR SEC 13 FOUND STUMPS OF BT & OLD STAKE. SET STAKE SURROUNDED BY 3 HHs. AT SW COR 18 FOUND BTS & OLD STAKE 3.63' NORTH OF SE COR SEC 13, 2644.12 VAR 7-08 TO E 1/4 COR SEC 25, E 1/4 COR SEC 24 ON LINE WITH NE & SE CORNERS SEC 24.
- 1868 LOCKE VOL 1 PG 324 SEE SEC 24 TURTLE.
- 1914 COLDWELL VOL 3 PG 73 2658 TO E 1/4 COR SEC 13.
- 1971 LEE VOL 4 PG 516 DUG & FOUND HH 12X12X6 1.5' DEEP. SET CI WITH HH ON EAST SIDE & FLAT SANDSTONE ON WEST SIDE 2639.98 TO E 1/4 COR SEC 24.
- 1980 BARNES VOL 6 PG 81. FOUND CI MONUMENT. 2536.70 TO S 1/4 COR SEC 18, 2666.01 TO E 1/4 COR SEC 13, 2640.11 TO E 1/4 COR SEC 24.

FOUND CAST IRON MONUMENT.

C) Was the corner restored through acceptance of (1) an obliterated evidence location, or, (2) a found perpetuated location?

ACCEPTED FOUND PERPETUATED LOCATION.

D) Describe any material discrepancy between the location of the corner as restored or reestablished and the location of that corner as previously restored or reestablished by distance and direction. Show the discrepancy on the plan view drawing under (a), above. Show the distances between the corner as previously restored or reestablished and (1) the corner as restored or reestablished, and (2) to at least 4 of the witness monuments shown on the drawing in (a), above.

(E) Was the corner reestablished through lost corner proportionate methods? If so, show the method, including the directions and distances to other public land survey corners used as evidence or used for proportioning the corner location.

NO

I, Donald Barnes, hereby certify that the corner points as identified by the corner code index were, in a field survey on, 1994, established, re-established, monumented, re-monumented, recovered or restored as expressed below and in conformance with the regulations and rules as required in the current manual of survey instructions of the United States Department of Interior, Bureau of Land Management.

seal

*Donald Barnes*  
7/14/95

EMBOSS LAND SURVEYOR SEAL

COUNTY SURVEYOR FILING DATA

Date of computer entry \_\_\_\_\_

Date microfilmed \_\_\_\_\_

Number of included sheets \_\_\_\_\_  
CORNER CODE \_\_\_\_\_

A-E 7.08 REQUIREMENT

N 25