

PUBLIC LAND SURVEY MONUMENT RECORD

For Public Land Survey Corners in the


T. 1 N., R. 13 E.

CORNER CODE INDEX

	1	2	3	4	5	6
A						
B	6	5	4	3	2	
C						
D						
E						
F						
G	7	8	9	10	11	12
H						
I						
J						
K						
L	13	14	15	16	17	18
M						
N						
O						
P	19	20	21	22	23	24
Q						
R						
S						
T	25	26	27	28	29	30
U						
V						
W						
X	31	32	33	34	35	36
Y						
Z						

PLACE MONUMENT SYMBOL (◆) AT PROPER LOCATION ON ABOVE INDEX

EXAMPLE

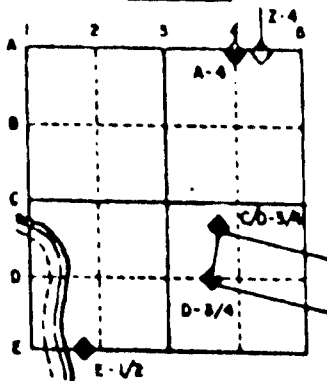

TURTLE TWP
ROCK COUNTY WI

IF AVAILABLE
STATE PLANE COORDINATES

North (Y) 205,650.49 Elev. (Z) _____

East (X) 527,928.34 Zone _____

Hor. Datum COUNTY Vert. Datum _____

◆ CORNER MONUMENT

○ WITNESS MONUMENT

Fd ALUM MON

Fd TIES IN VOL 5 pg 15

BEARINGS ARE BASED ON:

(B) Describe any record evidence, monument evidence, occupational evidence, testimonial evidence or any other material evidence you considered, and whether the monument was found or placed.

- 1835 BRINK SET POST CORNER SECTIONS 25 & 36. BLACK OAK 8 S48 1/2W .47
BUR OAK 10 N58 1/2W .70
- 1961 BATTERMAN VOL 4 PG 85 R/R SPIKE & REFERENCED SAME
- 1974 LEE VOL 5 PG 15 SET ALUM. MON. & REFERENCED SAME. 2640.00 TO W
1/4 COR SEC 31.
- 1977 BARNES VOL 5 PG 335 2650.09 TO W 1/4 COR SEC 30.
- 1977 BARNES VOL 5 PG 338 FOUND ALUM. MON. PUT 4" RISER ON MON.
- 1979 BARNES VOL 5 PG 533 CALLS FOR THE FOLLOWING SCHROEDER'S
MEASUREMENTS: 2656.60 TO S 1/4 COR SEC 25, ANGLE OF 91-59 FROM E
1/4 TO N 1/4 COR SEC 36, & AN ANGLE OF 88-08-53 AT THE E 1/4 COR
SEC 36 FROM THE W 1/4 COR SEC 36 TO THE NE COR OF SEC 36.
- 1980 BARNES VOL 6 PG 78. CALLS FOR THE FOLLOWING SCHROEDER'S
MEASUREMENTS: 2656.60 TO S 1/4 COR SEC 25 & 2650.06 TO E 1/4 COR
SEC 25.

FOUND ALUM MON & TIES IN VOL 5 PG 15

C) Was the corner restored through acceptance of (1) an obliterated evidence location, or, (2) a found perpetuated location?
ACCEPTED FOUND PERPETUATED LOCATION.

D) Describe any material discrepancy between the location of the corner as restored or reestablished and the location of that corner as previously restored or reestablished by distance and direction. Show the discrepancy on the plan view drawing under (a), above. Show the distances between the corner as previously restored or reestablished and (1) the corner as restored or reestablished, and (2) to at least 4 of the witness monuments shown on the drawing in (a), above.

(E) Was the corner reestablished through lost corner proportionate methods? If so, show the method, including the directions and distances to other public land survey corners used as evidence or used for proportioning the corner location.
NO

I, Donald Barnes, hereby certify that the corner points as identified by the corner code index were, in a field survey on, 1994, established, re-established, monumented, re-monumented, recovered or restored as expressed below and in conformance with the regulations and rules as required in the current manual of survey instructions of the United States Department of Interior, Bureau of Land Management.

seal



EMBOSS LAND SURVEYOR SEAL

COUNTY SURVEYOR FILING DATA

Date of computer entry _____

Date microfilmed _____

Number of included sheets _____
CORNER CODE

A-E 7.08 REQUIREMENT

7/12/95

V25