

# PUBLIC LAND SURVEY MONUMENT RECORD

For Public Land Survey Corners in the


T. 1 N., R. 13 E

## CORNER CODE INDEX

	1	2	3	4	5	6	7	8	9	10	11	12	13	14	15	16	17	18	19	20	21	22	23	24	25
A																									
B	6																								
C		5																							
D			4																						
E				3																					
F					2																				
G	7																								
H		6																							
I			5																						
J				4																					
K					3																				
L	8																								
M		7																							
N			6																						
O				5																					
P					4																				
Q						3																			
R							2																		
S								1																	
T	19																								
U		18																							
V			17																						
W				16																					
X					15																				
Y						14																			
Z							13																		
								12																	
									11																
										10															
											9														
												8													
													7												
														6											
															5										
																4									
																	3								
																		2							
																			1						

PLACE MONUMENT SYMBOL (●) AT PROPER LOCATION ON ABOVE INDEX

### EXAMPLE

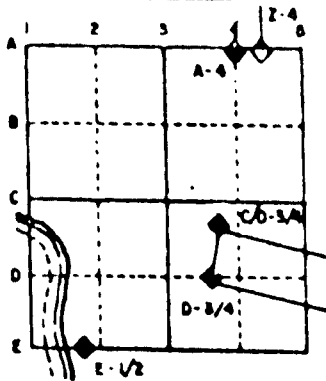

TURTLE TWP  
ROCK COUNTY WI

IF AVAILABLE  
STATE PLANE COORDINATES

North (Y) 208,300.56 Elev. (Z) \_\_\_\_\_  
 East (X) 527,930.06 Zone \_\_\_\_\_  
 Hor. Datum COUNTY Vert. Datum \_\_\_\_\_

◆ CORNER MONUMENT  
*Fd ALUM MON*

○ WITNESS MONUMENT

*Fd TIES IN VOL 5 pg 337*

BEARINGS ARE BASED ON:

(B) Describe any record evidence, monument evidence, occupational evidence, testimonial evidence or any other material evidence you considered, and whether the monument was found or placed.

1869 LEE VOL 1 PG 349 FOUND OLD STAKE. SET BUR OAK STAKE SURROUNDED BY 4 HH. 2654.52 VAR 4-15 TO CENTER OF SEC 25, 5307.06 TO W 1/4 COR SEC 25, & 2647.92 TO NE COR SEC 25.

1977 BARNES VOL 5 PG 335 2650.09 TO NE COR SEC 25 & 2650.09 TO SE COR SEC 25.

1977 BARNES VOL 5 PG 337 SET ALUM. MON. CORNER IS IN OLD EXCAVATION. REFERENCED SAME. CORNER IS 2' EAST OF N/S CENTER OF PAVEMENT.

1980 BARNES VOL 6 PG 78 FOUND ALUM MON. 2650.06 TO SE COR SEC 25, 2650.01 TO NE COR SEC 25, 5315.3 TO W 1/4 COR SEC 25. ANGLE FROM SE TO NE 180-00-30.

FOUND ALUM MON & TIES IN VOL 5 PG 337

C) Was the corner restored through acceptance of (1) an obliterated evidence location, or, (2) a found perpetuated location?  
ACCEPTED FOUND PERPETUATED LOCATION.

D) Describe any material discrepancy between the location of the corner as restored or reestablished and the location of that corner as previously restored or reestablished by distance and direction. Show the discrepancy on the plan view drawing under (a), above. Show the distances between the corner as previously restored or reestablished and (1) the corner as restored or reestablished, and (2) to at least 4 of the witness monuments shown on the drawing in (a), above.

(E) Was the corner reestablished through lost corner proportionate methods? If so, show the method, including the directions and distances to other public land survey corners used as evidence or used for proportioning the corner location.

NO

I, Donald Barnes, hereby certify that the corner points as identified by the corner code index were, in a field survey on, 1994, established, re-established, monumented, re-monumented, recovered or restored as expressed below and in conformance with the regulations and rules as required in the current manual of survey instructions of the United States Department of Interior, Bureau of Land Management.

COUNTY SURVEYOR FILING DATA

Date of computer entry \_\_\_\_\_

Date microfilmed \_\_\_\_\_

Number of included sheets \_\_\_\_\_

CORNER CODE

seal

*Donald Barnes*

*7/14/95*

EMBOSS LAND SURVEYOR SEAL

A-E 7.08 REQUIREMENT