Paper weight- 32# 25% Rag Ledger (minimum)


Black nonfading introduced

UBLIC MONUMENT RECORD

SURVEY

For Public Land Survey Corners in the T. 1N., R. 13 E

, CORNER CODE INDEX

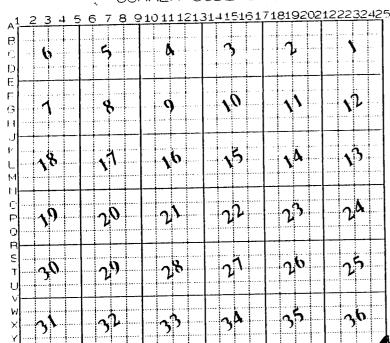

TURTLE ROCK COUNTY WI

IF AVAILABLE ROCK COUNTY COORDINATES PERFERRED

North 200, 370, 29 Elev.

East 527,922,44

Hor. Datum <u>COUNTY</u> Vert. Datum ____

GPS (X) ____

TRAVERSE (X) X

BASED ON THE FOLLOWING CONTROL:

PLACE MONUMENT SYMBOL & LOCATION ON ABOVE INDEX AT PROPER

OCORNER MONUMENT

O WITHESS MONUMENT

(a)

BEARINGS ARE BASED ON:__

Fd ALUM MON.

Fd TIES IN VOL 5 Pg 15.

SHEET ____OF

PLAINING & ZONING COMMITTEE ADOPTED THE ABOVE FORM ON 12/2/1982 WI ADMINISTRATIVE CODE A-E 7.08 REQUIREMENT

CORNER CODE

- (B) Describe any record evidence, monument evidence, occupational evidence, testimonial evidence or any other material evidence you considered, and whether the monument was found or placed.
- 1833 LYONS SET POST ON A PIECE OF FLAT BUR OAK LAND FOR CORNER TO SECS 36 OF T1N R13E & SEC 31 OF T1N R14E OF THE 4TH PRINCIPAL MERIDIAN. BUR OAK 18 N18W 132 & BUR OAK 15 N41 1/2E 144.
- 1838 DEC 27 SPALDING FIELD NOTES PG 867. NORTH BETWEEN SECTIONS 4 & 5 T46N R3E OF 3RD P.M. VAR 6-20E. AT 2697.42' INTERSECTED NORTH BOUNDARY OF THE STATE OF ILLINOIS 1139.82 WEST OF THE CORNER TO SECTION 31 & 36 TIN R14E OF THE 4TH P.M. IN THE WI TERRITORY & AT SAID INTERSECTION SET A POST FOR CORNER TO SEC 4 & 5 T46N R3E. WHICH POST BURR OAK 6" DIAMETER BEARS S73E 109.56' & BUR OAK 16" DIAMETER BEARS S30 1/4W 42.9'/
- 1861 HOBART VOL 1 PG 157 BL OAK 11 N37 1/2W 85. 2646.60 TO S 1/4 COR SEC 36.
- 1974 LEE VOL 5 PG 15 SET ALUM MON & REFERENCED SAME. 2638.89 TO S 1/4
- COR SEC 31 & 2640.16 TO E 1/4 COR SEC 36.
 1979 BARNES VOL 5 PG 533 2646.88 TO S 1/4 COR SEC 36, 2640.00 TO E 1/4 COR SEC 36, AN ANGLE OF 88-02-30 FROM THE S 1/4 COR SEC 36 TO THE E 1/4 COR SEC 36, & AN ANGLE OF 179-30 AT THE S 1/4 COR SEC 36 FROM THE SE COR SEC 36 TO THE SW COR SEC 36.

FOUND ALUM. MON. AND TIES IN VOL 5 PG 15.

- Was the corner restored through acceptance of (1) an obliterated evidence location, or, (2) a found perpetuated location? ACCEPTED FOUND PERPETUATED LOCATION.
- Describe any material discrepancy between the location of the corner as restored or reestablished and the location of that corner as previously restored or reestablished by distance and direction. Show the discrepancy on the plan view drawing under (a), above. Show the distances between the corner as previously restored or reestablished and (1) the corner as restored or reestablished, and (2) to at least 4 of the witness monuments shown on the drawing in (a), above.
- Was the corner reestablished through lost corner proportionate methods? If so, show the method, including the directions and distances to other public land survey corners used as evidence or used for proportioning the corner location. NO
- I, Donald Barnes, hereby certify that the corner points as identified by the corner code index were, in a field survey on, 1994, established, re-established, monumented, re-monumented, recovered or restored as expressed below and in conformance with the regulations and rules as required in the current manual of survey instructions of the United States Department of Interior, Bureau of Land Management.

	COUNTY SURVEYOR FILING DATA
Devold Barrel	Date of computer entry
	Date microfilmed
	Number of included sheets
1114195	CORNER CODE

EMBOSS LAND SURVEYOR SEAL