

PUBLIC LAND SURVEY MONUMENT RECORD

For Public Land Survey Corners in the


T. 1N., R. 13E

CORNER CODE INDEX

	1	2	3	4	5	6	7	8	9	10	11	12	13	14	15	16	17	18	19	20	21	22	23	24	25
A																									
M																									
L																									
D																									
E																									
F																									
G																									
H																									
J																									
K																									
L																									
M																									
N																									
U																									
P																									
Q																									
H																									
S																									
T																									
U																									
V																									
W																									
X																									
Y																									
Z																									

PLACE MONUMENT SYMBOL (●) AT PROPER LOCATION ON ABOVE INDEX

EXAMPLE

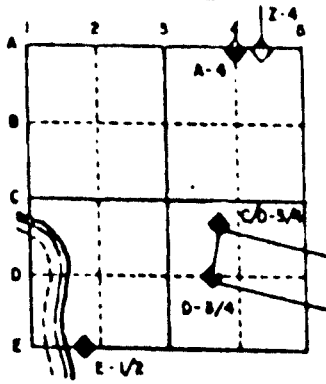

TURTLE TWP
ROCK COUNTY WI

IF AVAILABLE
STATE PLANE COORDINATES

North (Y) 203,010,25 Elev. (Z) _____
East (X) 527,925,58 Zone _____
Hor. Datum COUNTY Vert. Datum _____

◆ CORNER MONUMENT

○ WITNESS MONUMENT

Ed TIES IN VOL 5 pg 15

BEARINGS ARE BASED ON:

(B) Describe any record evidence, monument evidence, occupational evidence, testimonial evidence or any other material evidence you considered, and whether the monument was found or placed.

- 1835 BRINK YELLOW OAK 16IN DIAMETER, BUR OAK 10 S59 1/2W .82 & BUR OAK 12 N65W 1.99.
- 1861 HOBART VOL 1 PG 157 2656.5 TO CENTER OF SEC 36 & 5303.1 TO W 1/4 COR SEC 36.
- 1974 BARNES VOL 5 PG 15 FOUND 1" PIPE & REFERENCED SAME 2640.000 TO NE 36 & 2640.16 TO SE COR SEC 36.
- 1979 BARNES VOL 5 PG 533 CALLS FOR THE FOLLOWING MEASUREMENTS BY SCHROEDERS: 2651.54 TO CENTER OF SEC 36, 88-08-53 AT E 1/4 COR SEC 36 FROM CENTER TO NE COR SEC 36, 91-51-07 AT E 1/4 COR SEC 36 FROM SE COR SEC 36 TO CENTER OF SEC 36.
- 1981 BARNES VOL 6 PG 141 REPLACED 1X24 IRON ROD WITH ALUM MON.

FOUND ALUM MON. & REFERENCED TIES IN VOL 5 PG 15.

C) Was the corner restored through acceptance of (1) an obliterated evidence location, or, (2) a found perpetuated location?
ACCEPTED FOUND PERPETUATED LOCATION.

D) Describe any material discrepancy between the location of the corner as restored or reestablished and the location of that corner as previously restored or reestablished by distance and direction. Show the discrepancy on the plan view drawing under (a), above. Show the distances between the corner as previously restored or reestablished and (1) the corner as restored or reestablished, and (2) to at least 4 of the witness monuments shown on the drawing in (a), above.

(E) Was the corner reestablished through lost corner proportionate methods? If so, show the method, including the directions and distances to other public land survey corners used as evidence or used for proportioning the corner location.
NO

I, Donald Barnes, hereby certify that the corner points as identified by the corner code index were, in a field survey on, 1994, established, re-established, monumented, re-monumented, recovered or restored as expressed below and in conformance with the regulations and rules as required in the current manual of survey instructions of the United States Department of Interior, Bureau of Land Management.

seal
Donald Barnes
7/12/95

EMBOSS LAND SURVEYOR SEAL

COUNTY SURVEYOR FILING DATA

Date of computer entry _____

Date microfilmed _____

Number of included sheets _____

CORNER CODE

A-E 7.08 REQUIREMENT

X 25