

U.S. PUBLIC LAND SURVEY MONUMENT RECORD

For Public Land Survey Corners In: WI ADMINISTRATIVE CODE A-E 7.08 REQUIREMENT

T. 1 N. - R. 14 E. of the 4th P.M.

CORNER CODE INDEX

(PLACE "◆" SYMBOL AT PROPER PLSS CORNER LOCATION)

A	1	2	3	4	5	6	7	8	9	10	11	12	13	14	15	16	17	18	19	20	21	22	23	24	25	A
B																										B
C	6																									C
D																										D
E																										E
F																										F
G	7																									G
H																										H
I																										I
J																										J
K	18	17																								K
L																										L
M																										M
N																										N
O																										O
P	19	20																								P
Q																										Q
R																										R
S																										S
T	30	29																								T
U																										U
V																										V
W																										W
X	31	32																								X
Y																										Y
Z																										Z
	1	2	3	4	5	6	7	8	9	10	11	12	13	14	15	16	17	18	19	20	21	22	23	24	25	

CLINTON TWP
ROCK COUNTY WI

COORDINATES

(GNSS DERIVED VIA WISCORS)

NORTHING: 204940.79 ELEV:




EASTING: 559716.31

Hor. Datum: WCCS-ROCK, (NA2011)

Vertical Datum: NAVD 88

(a) LEGEND

- – BRASS DISK MONUMENT INSIDE OF PVC TUBE FOUND
- ⊙ – CONCRETE MONUMENT WITH ALUMINUM CAP FOUND

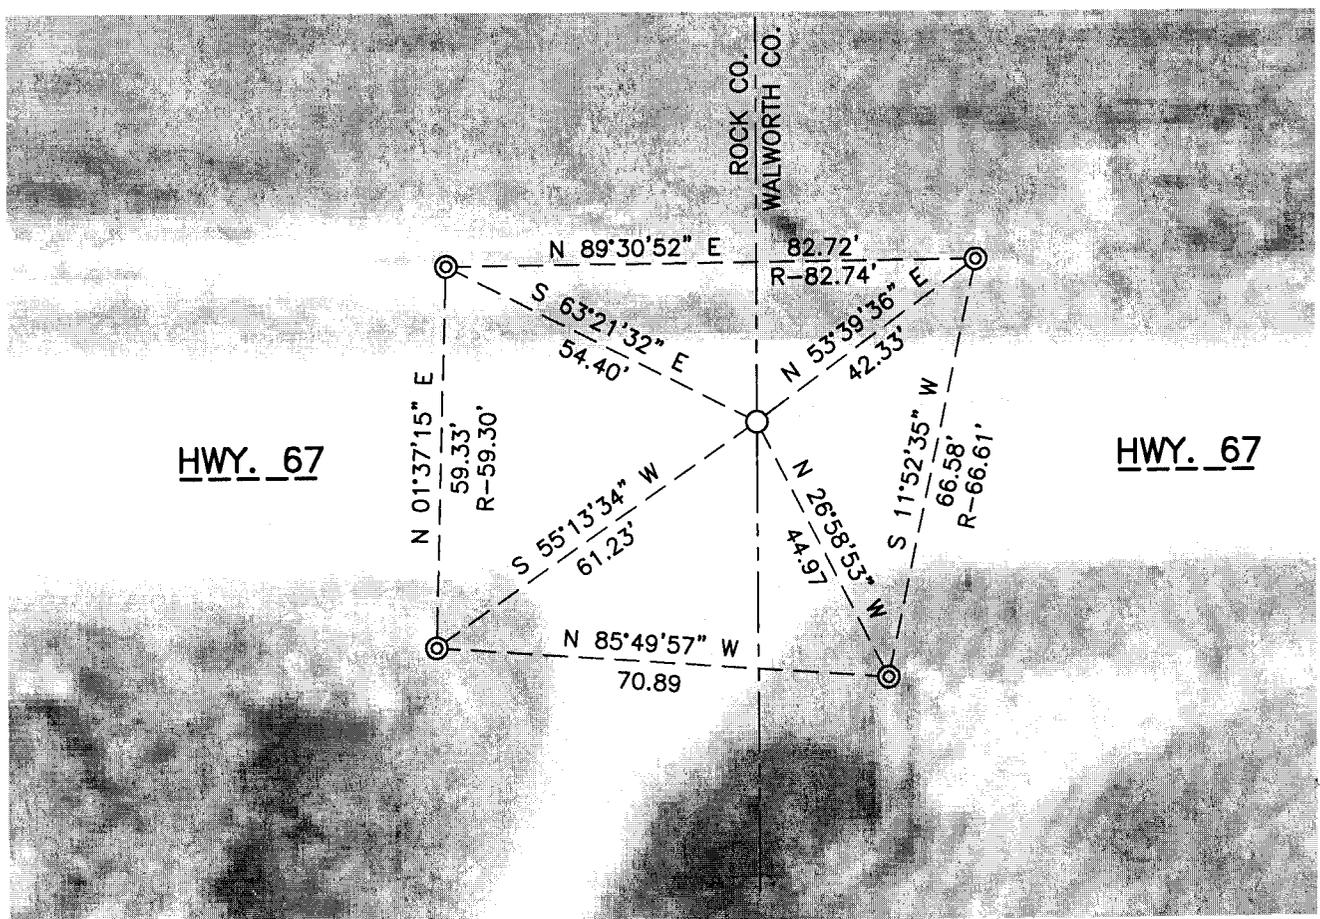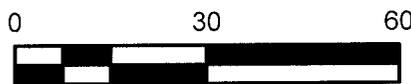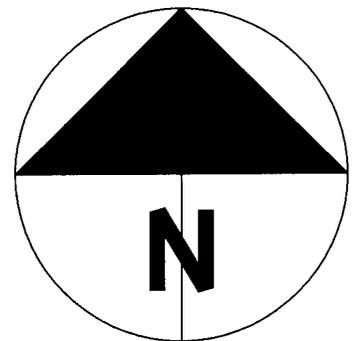

B) Describe any record evidence, monument evidence, occupational evidence, testimonial evidence or any other material evidence you considered, and whether the monument was found or placed.

In advance of Hwy. 67 resurfacing, (Hwy. 140 – Walworth County line), I set control and surveyed existing monuments, (exposed), and witnesses throughout the project. At this location, I recovered the section corner monument and four witness monuments from a tie sheet, (V-25(2)), prepared by Leland Kreblin on June 25, 1994.

Post construction I re-visited the corner and there was an extension of some kind placed above the PVC tube I previously found. The monument still exists 6-8" below finished grade. This tie-sheet is produced to show my tie dimensions and to publish the WCCS-Rock (NA2011) coordinate values.

C) Was the corner restored through acceptance of (1) an obliterated evidence location, or, (2) a found perpetuated location?

Corner exists as found.

D) Describe any material discrepancy between the location of the corner as restored or reestablished and the location of that corner as previously restored or reestablished by distance and direction. Show the discrepancy on the plan view drawing under (a), above. Show the distances between the corner as previously restored or reestablished and (1) the corner as restored or reestablished, and (2) to at least 4 of the witness monuments shown on the drawing in (a), above.

Any discrepancies are noted on the face of the map with the most recently filed tie-sheets distances noted with an "R". Absent the "R" distance to a found monument, assume I match the existing tie-sheet distance. Bearing discrepancies are not noted.

(E) Was the corner reestablished through lost corner proportionate methods? If so, show the method, including the directions and distances to other public land survey corners used as evidence or used for proportioning the corner location.

N/A

I, **Jason R. Houle**, hereby certify that the corner location as identified by the corner code index was determined by me under my direction and control and that this U.S. Public Land Survey Monument Record is correct and complete to the best of my knowledge and belief.

CORNER CODE: V-25(3)
(A.E. 7.08 REQUIREMENT)

