

U.S. PUBLIC LAND SURVEY MONUMENT RECORD

For Public Land Survey Corners in the


T. ___ N., R. ___ E.

CORNER CODE INDEX

	1	2	3	4	5	6	7	8	9	10	11	12	13	14	15	16	17	18	19	20	21	22	23	24	25
A																									
B																									
C	6																								
D																									
E																									
F																									
G	7																								
H																									
I																									
J																									
K																									
L	18																								
M																									
N																									
O																									
P	19																								
Q																									
R																									
S																									
T	30																								
U																									
V																									
W																									
X	31																								
Y																									
Z																									

PLACE MONUMENT SYMBOL (◆) AT PROPER LOCATION ON ABOVE INDEX

EXAMPLE

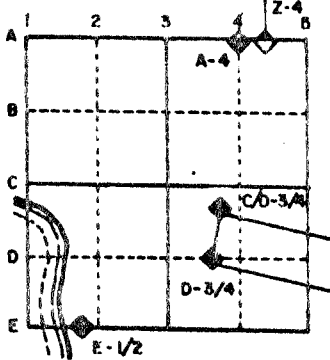

_____ TWP
ROCK COUNTY WI

IF AVAILABLE
STATE PLANE COORDINATES

North (Y) _____ Eleve. (Z) _____
 East (X) _____ Zone _____
 Hor. Datum _____ Vert. Datum _____

a.)

◆ CORNER MONUMENT

○ WITNESS MONUMENT

BEARINGS ARE BASED ON:

SHEET ___ OF ___

CORNER CODE: _____

15

Rock
LA. PRAIRIE

NONE

X

5

2 1/2, 13

6"x6" Concrete GRND. Control Mon.

LOCATION INDICATION ON SECTION 1

LOCATION SEARCH

Fd. 6"x6" GRND. Control Mon. marked F258, 1956
on N.S. Center Section Line approx.
where shown.

MAY 6
1985

This space for copy of field notes or ties to the above described monument

Field notes or roughs filed in book no. NOTES pp 10

City of JANESVILLE Rock

Created or established by T.H. RICHARD 7-8-58

County Clerk's Office County (Title)

Received for record

EGH

B/c 7