

# U.S. PUBLIC LAND SURVEY MONUMENT RECORD


For Public Land Survey Corners in the  
T. 2 N., R. 11 E.

## CORNER CODE INDEX

|   |   |   |   |    |    |    |    |    |    |    |    |    |    |    |    |    |    |    |    |    |    |    |    |    |    |
|---|---|---|---|----|----|----|----|----|----|----|----|----|----|----|----|----|----|----|----|----|----|----|----|----|----|
|   | 1 | 2 | 3 | 4  | 5  | 6  | 7  | 8  | 9  | 10 | 11 | 12 | 13 | 14 | 15 | 16 | 17 | 18 | 19 | 20 | 21 | 22 | 23 | 24 | 25 |
| A |   |   |   |    |    |    |    |    |    |    |    |    | ◆  |    |    |    |    |    |    |    |    |    |    |    |    |
| B |   |   |   |    |    |    |    |    |    |    |    |    |    |    |    |    |    |    |    |    |    |    |    |    |    |
| C | 6 |   |   |    |    |    |    |    |    |    |    |    |    |    |    |    |    |    |    |    |    |    |    |    |    |
| D |   | 5 |   |    |    |    |    |    |    |    |    |    |    |    |    |    |    |    |    |    |    |    |    |    |    |
| E |   |   | 4 |    |    |    |    |    |    |    |    |    |    |    |    |    |    |    |    |    |    |    |    |    |    |
| F |   |   |   | 3  |    |    |    |    |    |    |    |    |    |    |    |    |    |    |    |    |    |    |    |    |    |
| G |   |   |   |    | 2  |    |    |    |    |    |    |    |    |    |    |    |    |    |    |    |    |    |    |    |    |
| H | 7 |   |   |    |    |    |    |    |    |    |    |    |    |    |    |    |    |    |    |    |    |    |    |    |    |
| I |   | 8 |   |    |    |    |    |    |    |    |    |    |    |    |    |    |    |    |    |    |    |    |    |    |    |
| J |   |   | 9 |    |    |    |    |    |    |    |    |    |    |    |    |    |    |    |    |    |    |    |    |    |    |
| K |   |   |   | 10 |    |    |    |    |    |    |    |    |    |    |    |    |    |    |    |    |    |    |    |    |    |
| L |   |   |   |    | 11 |    |    |    |    |    |    |    |    |    |    |    |    |    |    |    |    |    |    |    |    |
| M |   |   |   |    |    | 12 |    |    |    |    |    |    |    |    |    |    |    |    |    |    |    |    |    |    |    |
| N |   |   |   |    |    |    | 13 |    |    |    |    |    |    |    |    |    |    |    |    |    |    |    |    |    |    |
| O |   |   |   |    |    |    |    | 14 |    |    |    |    |    |    |    |    |    |    |    |    |    |    |    |    |    |
| P |   |   |   |    |    |    |    |    | 15 |    |    |    |    |    |    |    |    |    |    |    |    |    |    |    |    |
| Q |   |   |   |    |    |    |    |    |    | 16 |    |    |    |    |    |    |    |    |    |    |    |    |    |    |    |
| R |   |   |   |    |    |    |    |    |    |    | 17 |    |    |    |    |    |    |    |    |    |    |    |    |    |    |
| S |   |   |   |    |    |    |    |    |    |    |    | 18 |    |    |    |    |    |    |    |    |    |    |    |    |    |
| T |   |   |   |    |    |    |    |    |    |    |    |    | 19 |    |    |    |    |    |    |    |    |    |    |    |    |
| U |   |   |   |    |    |    |    |    |    |    |    |    |    | 20 |    |    |    |    |    |    |    |    |    |    |    |
| V |   |   |   |    |    |    |    |    |    |    |    |    |    |    | 21 |    |    |    |    |    |    |    |    |    |    |
| W |   |   |   |    |    |    |    |    |    |    |    |    |    |    |    | 22 |    |    |    |    |    |    |    |    |    |
| X |   |   |   |    |    |    |    |    |    |    |    |    |    |    |    |    | 23 |    |    |    |    |    |    |    |    |
| Y |   |   |   |    |    |    |    |    |    |    |    |    |    |    |    |    |    | 24 |    |    |    |    |    |    |    |
| Z |   |   |   |    |    |    |    |    |    |    |    |    |    |    |    |    |    |    | 25 |    |    |    |    |    |    |
|   |   |   |   |    |    |    |    |    |    |    |    |    |    |    |    |    |    |    |    | 26 |    |    |    |    |    |
|   |   |   |   |    |    |    |    |    |    |    |    |    |    |    |    |    |    |    |    |    | 27 |    |    |    |    |
|   |   |   |   |    |    |    |    |    |    |    |    |    |    |    |    |    |    |    |    |    |    | 28 |    |    |    |
|   |   |   |   |    |    |    |    |    |    |    |    |    |    |    |    |    |    |    |    |    |    |    | 29 |    |    |
|   |   |   |   |    |    |    |    |    |    |    |    |    |    |    |    |    |    |    |    |    |    |    |    | 30 |    |
|   |   |   |   |    |    |    |    |    |    |    |    |    |    |    |    |    |    |    |    |    |    |    |    |    | 31 |
|   |   |   |   |    |    |    |    |    |    |    |    |    |    |    |    |    |    |    |    |    |    |    |    |    | 32 |
|   |   |   |   |    |    |    |    |    |    |    |    |    |    |    |    |    |    |    |    |    |    |    |    |    | 33 |
|   |   |   |   |    |    |    |    |    |    |    |    |    |    |    |    |    |    |    |    |    |    |    |    |    | 34 |
|   |   |   |   |    |    |    |    |    |    |    |    |    |    |    |    |    |    |    |    |    |    |    |    |    | 35 |
|   |   |   |   |    |    |    |    |    |    |    |    |    |    |    |    |    |    |    |    |    |    |    |    |    | 36 |

PLACE MONUMENT SYMBOL (◆) AT PROPER  
LOCATION ON ABOVE INDEX

### EXAMPLE

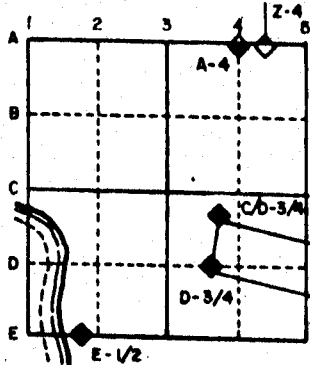

PLYMOUTH TWP  
ROCK COUNTY WI

IF AVAILABLE  
STATE PLANE COORDINATES

North (Y) \_\_\_\_\_ Eleve. (Z) \_\_\_\_\_  
 East (X) \_\_\_\_\_ Zone \_\_\_\_\_  
 Hor. Datum \_\_\_\_\_ Vert. Datum \_\_\_\_\_

- (a)       CORNER MONUMENT       WITNESS MONUMENT





BEARINGS ARE BASED ON:

FIELD BOOK \_\_\_\_\_ PAGE # \_\_\_\_\_

## MICROFILMED

SHOW A PLAN VIEW DRAWING DEPICTING THE CORNER MONUMENT AND SURROUNDING PHYSICAL FEATURES, INCLUDING THE EXCAVATION AREA AND DEPTH. THE CORNER MONUMENT SHALL HAVE THE FOLLOWING CHARACTERISTICS: 1) HAVE AT LEAST TWO PREDETERMINED BREAK-OFF POINTS. 2) IF BROKEN, LEAVE A PERMANENTLY MAGNETIZED REMNANT AT THE ORIGINAL POINT. 3) MUST BE EXTENDABLE. 4) THE CAP IS INSCRIBED: ROCK COUNTY SURVEY MONUMENT - PENALTY FOR DISTURBING MARKER. 5) OR AN EXISTING CUT LIMESTONE. AN IRON PIPE 1 1/2" x 4'0" (MINIMUM) MAY BE USED IN AREAS WHERE GROUND WATER IS WITHIN ONE FOOT OF THE SURFACE. IF THE CORNER IS OCCUPIED BY AN IMPROVEMENT (MANHOLE, BURIED CABLE, ETC.) ANY DURABLE, DISTINCT MONUMENT MAY BE USED. CORNERS SHALL BE REFERENCED WITH AT LEAST 4 DURABLE WITNESS MONUMENTS. WITNESS MONUMENTS SHALL BE MADE OF CONCRETE, NATURAL STONE, IRON OR OTHER EQUALLY DURABLE MATERIAL, EXCEPT WOOD. DESCRIBE THE CORNER AND THE WITNESS MONUMENTS.

CORNER CODE:  
A 13 (2)

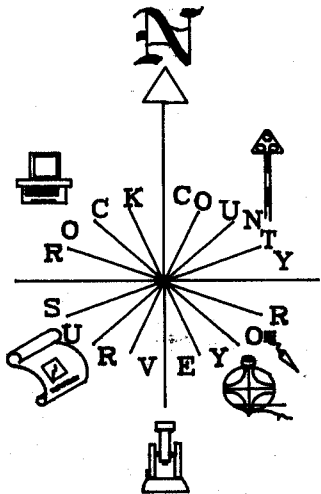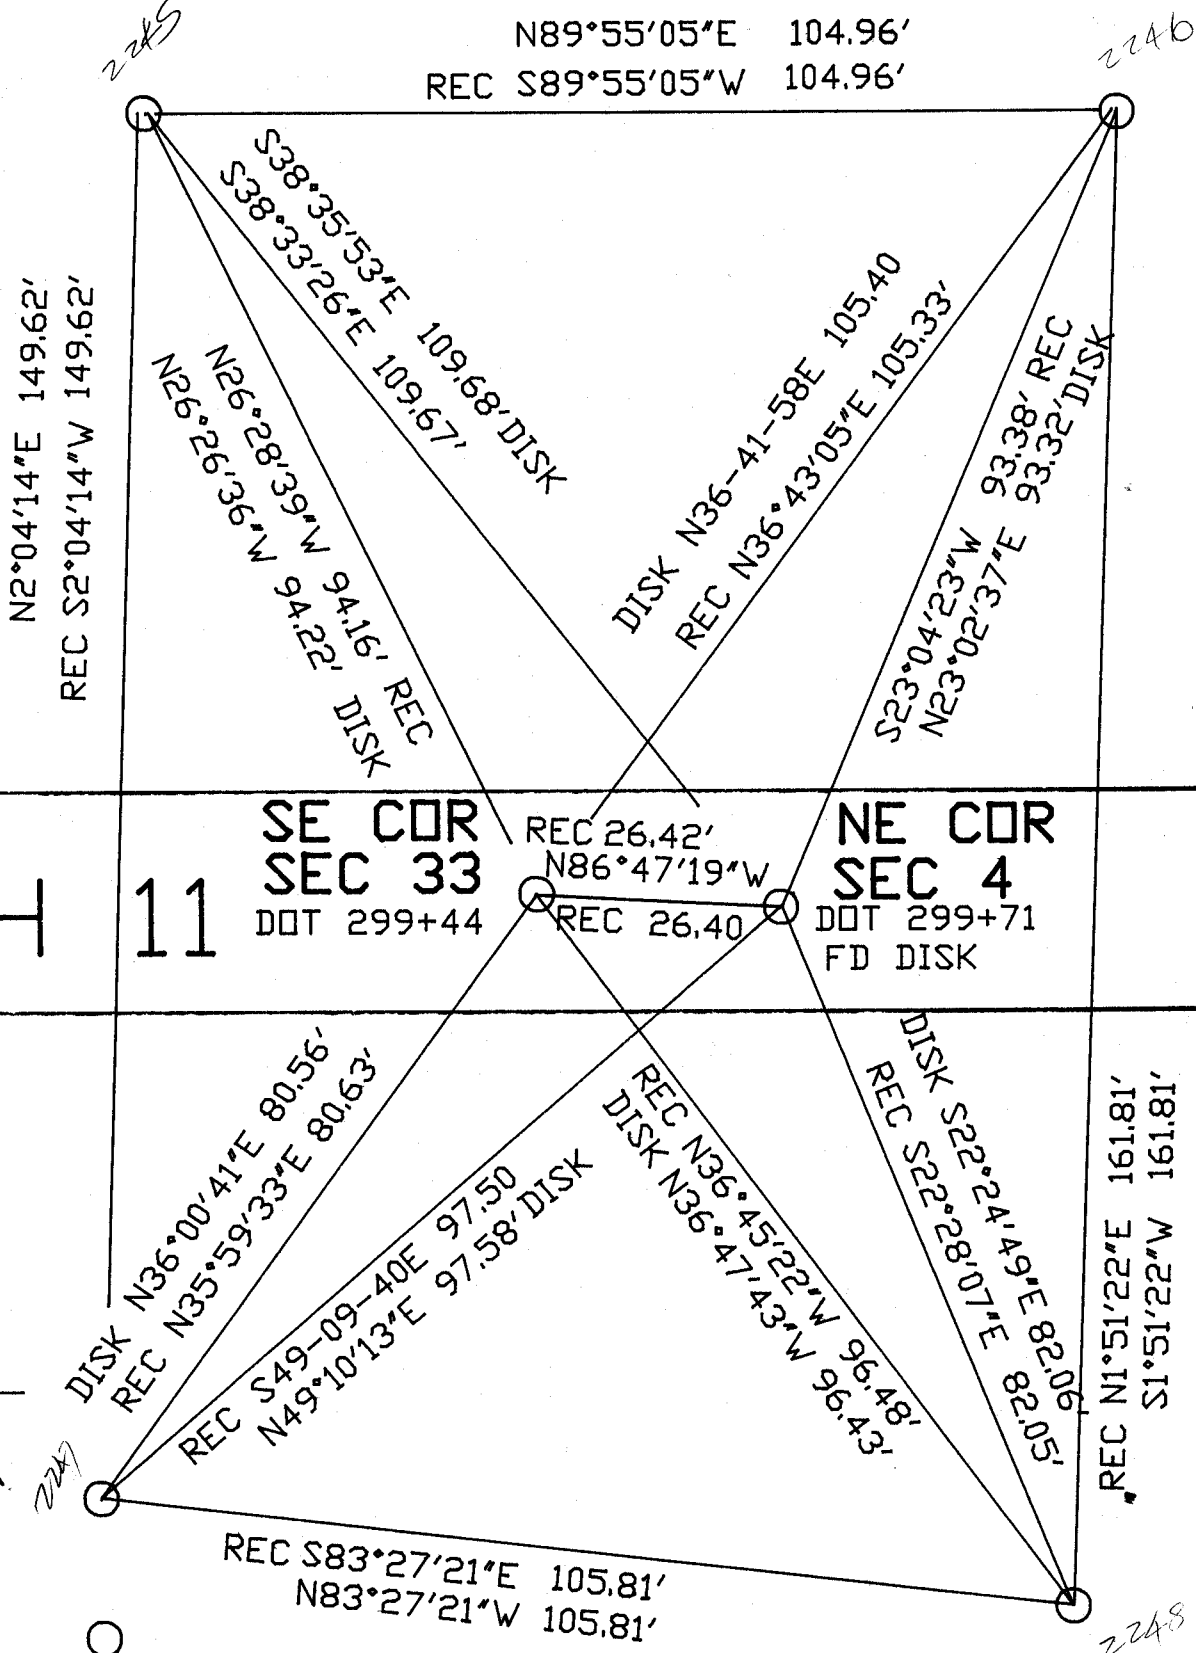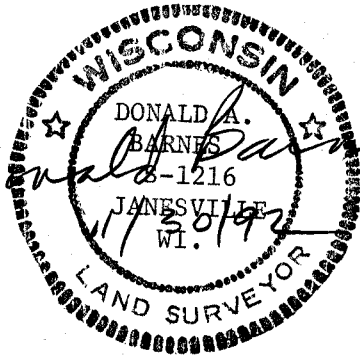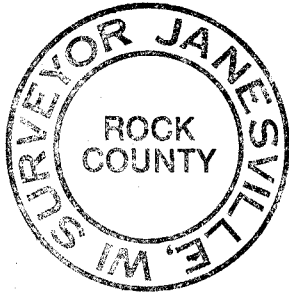

DOT DISK IN CONCRETE

A 13(2)

(B) Describe any record evidence, monument evidence, occupational evidence, testimonial evidence or any other material evidence you considered, and whether the monument was found or placed.

1833 HARRISON ORIGINAL SURVEYOR. INTERSECTED NORTH BOUNDARY 26.4' EAST OF POST. SET POST AND RAISED MOUND FOR CORNER TO SECTIONS 3 & 4.

1866 LOCKE REMONUMENTATION FIELD NOTES. CORNERS FOR TOWN 2 AND 3 BOTH LOST. SET CORNER FOR TOWN 3 MIDWAY AND ON A RIGHT LINE BETWEEN THE QUARTER CORNERS 1/2 MILE EAST AND WEST. AND SET THE CORNERS FOR TOWN 2 26.4' EAST OF CORNER FOR TOWN 3. CORNER IN CENTER OF HIGHWAY. PLACED CUT LIMESTONE.

1933 SUNNY VOL 3 PG 235 SET 1" X 36" IRON PIPE IN CONCRETE PAVEMENT 1.76' NORTH OF CENTER OF SAME.

1970 BATTERMAN JR. VOL 4 PG 484 REFERENCED AND MAPPED CORNER.

1988 BARNES A 13 LARGE CUT ON NORTH SIDE OF ROAD AND SMALL CUT ON SOUTH SIDE. FOUND 1" PIPE AND REFERENCE TIES.

FOUND DOT DISK.



(c) Was the corner restored through acceptance of (1) an obliterated evidence location, or (2) a found perpetuated location?

DID NOT ACCEPT DISK. ACCEPTED POSITION AS ESTABLISHED BY TIES OF RECORD.

(d) Describe any material discrepancy between the location of the corner as restored or reestablished and the location of that corner as previously restored or reestablished by distance and direction. Show the discrepancy on the plan view drawing under (a), above. Show the distances between the corner as previously restored or reestablished and (1) the corner as restored or reestablished, and (2) to at least 4 of the witness monuments shown on the drawing in (a), above.

THE DISK IS .04' SOUTH AND .08' EAST OF THE CORRECT LOCATION.

I, Donald Barnes, hereby certify that the corner points as identified by the corner code index were, in a field survey on November 9, 1992, established, re-established, monumented, re-monumented, recovered or restored as expressed below and in conformance with the regulations and rules as required in the current manual of survey instructions of the United States Department of Interior, Bureau of Land Management.

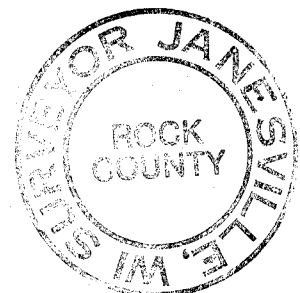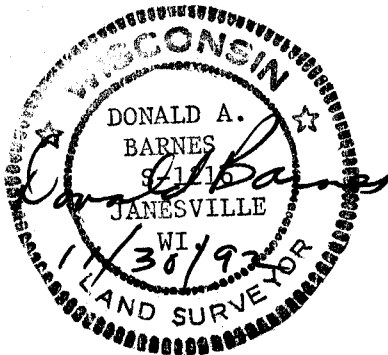

A13(2)