U.S.


LAND SURVEY **PUBLIC** MONUMENT RECORD

For Public Land Survey Corners in:

WI ADMINISTRATIVE CODE A-E 7.08 REQUIREMENT

T. ZN., R. //_E

CORNER CODE INDEX

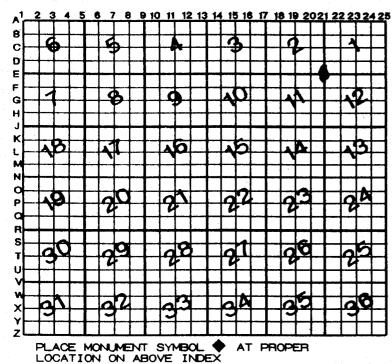

PLYM	0	UT	-H	_T	WP
ROCK					

IF AVAILABLE ROCK COUNTY COORDINATES PERFERRED

North	Elev			
East				
Hor. Datum	Vert. Datum			
LATITUDE	ELLIPS. H			
LONGITUTE				
GPS (X)	TRAVERSE (X)			
BASED ON THE	FOLLOWING CONTROL:			

♦CORNER MONUMENT

O WITNESS MONUMENT

BASED ON BEARINGS ARE

(a)

	•			

OBSERVATION SHEET 531

 $\downarrow \text{ of } \underline{3}$ SHEET _ _PAGE # FIELD BOOK __ SHOW A PLAN VIEW DRAWING DEPICTING THE CORNER MONUMENT AND SURROUNDING PHYSICAL FEATURES, INCLUDING THE EXCAVATION AREA AND DEPTH. PLANNING & ZONING COMMITTEE ADOPTED THE ABOVE FORM ON 12/2/1982

CORNER CODE E-2/(1

PL531

(B) Describe any record evidence, monument evidence, occupational evidence, testimonial evidence or any other material evidence you considered, and whether the monument was found or placed.

1833 HARRISON NORTH BETWEEN SECS 11 & 12

546.48 BLACK O. 18

762.96 BURR D. 14

2640 QUARTER SEC COR. {BURR 0 24 N39W 17.16' BURR 0 6 S44E 22.44' BURR 0 24 BURR 0 6} MARKED

4686 LEFT TIMBER & ENTER MARSH

5148 LEFT MARSH

5280 COR TO SECS 1,2,11,12 {BURR O 6 N7E 61.38', BURR O 10 N26W 79.86', BURR O 24 S87W 139.92' LAND LEVEL 2ND RATE WITH BURR O TIMBER ??

EAST ON RAND BET SECS 1 & 12

99 LEFT TIMBER ENTER MARSH

1320 LEFT MARSH & ENTER TIMB.

2640 TEMPY 1/4 P

4870.14 LEFT TIMBER & ENTER MARSH

5214 BROOK CRS S.E.

5266.14 INT E BDY 48.48' S OF P. LAND LEVEL & ? WET 2^{ND} RATE TIMBER MOSTLY BURR O & RED O COR. WEST.

2633.07 QUARTER SEC COR {BURR 0 6 N21W 116.16' BURR 0 7 S75E 106.92' BURR 0 6 BURR 0 7} MARKED NORTH BETWEEN SECS 1 & 2

2640 QUARTER SEC COR {BURR 0 12 N71E 148.5' BURR 0 24 S47W 48.84' BURR 0 12 BURR 0 24} MARKED

5240.4 INT. N BDG 3.3' W OF P {BURR 0. 24 S41E 316.8' BURR 0. 14 S45W 293.7 LAND HIGH & ROLLING 2ND RATE BUR & BLACK 0. TIMBER FRIDAY DEC 20TH 1833

EAST ON RAND. BET 2 & 11

2211 BROOK 9.9' CRS S.E.

2640 TEMPY 1/4 P

3234 LEFT MARSH & ENTER TIMBER

4158 LEFT TIMBER ENTER MARSH CRS SE

4752 LEFT MARSH ENTER TIMBER

5247.66 INT. E BDY 42.24' S OF P. LAND LEVEL & WET 3RD RATE TIMBER BURR O. GRASS

COR. WEST

2620.2 QUARTER SEC COR. {BURR 0 24 N61E 372.24' BURR 0 24 S26E 345.84' BURR 0 24 BURR 0 24} MARKED

5247.66 SEC COR

- 1843 STEBBINS TWP RD REC BK 1 PG 1 (BUTLER RD) SURVEY OF RD IN THE TWP OF CENTER. BEGINNING AT THE 1/4 POST ON THE EAST SIDE OF SEC 12, T2N R11E; THENCE WEST 5388.24' TO 1/4 POST ON WEST SIDE OF SEC 12; THENCE NORTH 2640 TO THE NW COR OF SEC 12 OF SAID TOWN AND RANGE AND THE WHOLE LENGTH OF THE ROAD 1 1/2 MILES 108.24'. COURSE GIVEN ACCORDING TO THE TRUE MERIDIAN. VARIATION OF THE NEEDLE 7 1/2
- 1843 STEBBINS TWP RD REC BK 1 PG 2 VARIATION OF NEEDLE 7 1/2
 BEGINNING AT THE SE COR OF SEC 1 T2N R11E; THENCE
 WEST 2 1/2 MILES (THIS COURSE FROM QUARTER POST ON
 SOUTH SIDE OF SEC 1 TO SW COR SOUTH ON A RANGE FROM
 BELOIT TO MADISON) TO THE QUARTER STAKE ON THE
 SOUTH LINE OF SEC 3; THENCE N72W ONE MILE AND 20
 CHAINS TO A STAKE; THENCE 59 WEST 1079.1' TO A BURR
 OAK TREE; THENCE N70W B15.1' TO A STAKE; THENCE S65W
 2610.3' TO A BLACK OAK TREE; THENCE S45W 1894.2' TO
 SEC BETWEEN SECTIONS 5 & 8, 247.5' EAST OF THE SE COR
 OF SEC 6, T2N R11E; THENCE WEST FOUR MILES 3679.5' TO

SHEET 1 OF 3 CORNER CODE E-21(1)

03/08/03

Den ld Barres

A STAKE ON THE SEC LINE BETWEEN SECS 4 & 9, 660' WEST OF THE QUARTER POST; THENCE N43 1/2W 838.2' TO A BURR OAK TREE; THENCE N65W 3444.54' TO A POINT ON THE LINE BETWEEN THE COUNTIES OF ROCK AND GREEN 341.88' SOUTH OF THE QUARTER POST ON THE WEST SIDE OF SEC 7, T2N, R10E AND THE WHOLE LENGTH OF THE ROAD IS 12 MILES 3927'

- 1845 PEASE TWP RD REC BK 1 PG 5 BEGINNING AT THE NW COR OF SEC 1 T2N R11E AND RUNNING SOUTH ON THE LINE BETWEEN SEC 1 & 2 2602.38' TO THE 1/4 POST ON THE WEST SIDE OF SEC 1 AFORESAID; THENCE SOUTH ON THE LINE AFOREMENTIONED TO THE SW COR OF SAID SEC 1 IN ALL 5242.38'?? . SAID RD LAID OUT BE FENCED 66' IN WIDTH OR 33 ON EACH SIDE OF THE LINE DESCRIBED.
- 1855 CHURCH VOL 1 PG 34 2614.26 TO N 1/4 COR SEC 11.
- 1868 LOCKE PG 32 COMMENCED AT COR FOR SEC 1 AND 2 11 AND 12 FOUND BT IN SEC 1 STUMP OF BT IN SEC 11 AND WHERE BT IN SEC 2 WAS DUG OUT & STONE ON COR. COR IN CENTER OF HIGHWAYS EAST BETWEEN SECS 1 & 12 VAR 5-37
 - 481.14 CENTER SLUICE BRIDGE
 - 2686.86 INTERSECTED 1/4 LINE 14.52' SOUTH OF COR.
 FOUND NORTH B.T. AND COR AS SET BY SELF (SEE
 CO SURVEYORS RECORD) VAR CORRECTED 5-54
 COR IN CENTER OF HIGHWAY CONTINUED EAST
 FROM 1/4 COR WITH VAR 5-55
 - 5303.76 INTERSECTED EAST BOUNDARY 2.64' NORTH OF COR. VAR CORRECTED 5-52 AUG 27 1868
 PG 35 SOUTH BETWEEN SECS 1 & 2 VAR 7-10
 - 2621.52 INTERSECTED 1/4 LINE AT COR. FOUND SOUTH BT AND STAKE & STONE SET ON CORNER. COR IN CENTER OF HIGHWAY AND IN LINE OF E & W FENCE.

 CONTINUED SOUTH WITH VAR 7-25
 - 5285.28 INTERSECTED SOUTH BOUNDARY 2.97' EAST OF COR. VAR CORRECTED 7-21 AUG 27 1868
 PG 36 WEST BETWEEN SEC 2 & 11 VAR 7-05
 - 2629.11 INTERSECTED 1/4 LINE AT COR. FOUND STUMPS OF BTS AND STONE SET ON COR IN CENTER OF HIGHWAY

CONTINUED WEST WITH VAR 6-35

- 3072.3 EAST SIDE BRIDGE OVER BASS CREEK
- 3151.5 WEST SIDE BRIDGE OVER BASS CREEK
- 5276.7 INTERSECTED WEST BOUNDARY AT COR. FOUND LARGE LIMESTONE AND STAKE UNDERNEATH IN CENTER OF HIGHWAY & IN LINE OF FENCE RUNNING NORTH. AUG 27 1868

PG 39 SOUTH BETWEEN SECS 11 & 12 VAR 5-25

- 380.82 CENTER OF SLUICE BRIDGE
- 2650.56 INTERSECTED 1/4 LINE AT COR. FOUND B.T.S AND STONE ON COR. SET BY SELF. CONTINUED SOUTH WITH VAR 8-15
- 5301.78 INTERSECTED SOUTH BOUNDARY 16.5' EAST OF COR. VAR CORRECTED 7-54 AUG 28, 1868

1876 RUGER VOL 2 PG 205 STONE MON.

- 1933 SUNNY VOL 3 PG 234 & 235 FD 6X6 CUT STONE MON. SET 1

 1/4 PIPE ON TOP. N/S CONC. CULVERT ON EAST & WEST SIDE OF RD. REF. COR.
- 1938 SUNNY VOL 3 PG 391 FD STONE MON. SET PIPE ON TOP. IN 1938 NOT YET IN BLACKTOP. REF. TO ELECTRIC POLES.
- 1966 BATTERMAN VOL 4 PG 295 SET PK @ COR USING SUNNY TIES.
- 1988 COMBS CSM 13-292 ALUM. MON. 2629.80 TO S 1/4 COR SEC 2 AN ALUM. MON.
- 1988 BARNES E-21 I FOUND PK AND ABOUT 2.3' DEEP FD CUT LIMESTONE. THE STONE WAS SPLIT LENGTH WISE. I REMOVED THE MIDDLE SECTION AND PLACED 1X24" PIPE

03/08/03

SHEET 2 OF 3 CORNER CODE E-21(1)

Dad Barnes

PL531

HORIZONTALLY ON SOUTH SIDE OF STONE. PLACED ALUMINUM MON. THERE IS A DISCREPANCY BETWEEN THE STONE AND THE PK THAT I FOUND. I ACCEPTED THE STONE. THE PK IS ABOUT .55' NORTH AND .23 WEST OF THE STONE. REFERENCED SAME.

- 1988 BARNES VOL 6 PG 379 S89-02-33W 2647.04 N 1/4 TO NW COR SEC 11 & N88-46-31E 2629.91 N 1/4 TO NE COR SEC 11
- 1988 BARNES VOL 6 PG 389 S89-50-30E 2687.61 TO S 1/4 COR SEC 1, S89-03-22W 2629.91 TO S 1/4 COR SEC 2, N1-06-00W 2663.97 TO E $\frac{1}{4}$ COR SEC 2, & SO-36-47W 2650.56 TO E $\frac{1}{4}$ COR SEC 11.
- 1993 COMBS CSM 16-370, #10157 & 10005 ALUM 2687.66 TO A PK @ N 1/4 COR SEC 12
- 1998 LATHROP CSM VOL 23 PG 129 FD ALUM. N89-50-10W 2629.79' TO S 1/4 COR SEC 2 & NORTH 2663.80 TO E 1/4 COR SEC 2, 2663.80 TO E 1/4 COR SEC 2, & ANGLE OF 89-50-10 FROM S 1/4 TO E 1/4 CORNERS SEC 2
- 1998 COMBS MAP #8257 FD ALUM MON.

FD ALUM MON. & TIES.

C) Was the corner restored through acceptance of (1) an obliterated evidence location, or, (2) a found perpetuated location?

ACCEPTED FOUND ALUM, MON.

- D) Describe any material discrepancy between the location of the corner as restored or reestablished and the location of that corner as previously restored or reestablished by distance and direction. Show the discrepancy on the plan view drawing under (a), above. Show the distances between the corner as previously restored or reestablished and (1) the corner as restored or reestablished, and (2) to at least 4 of the witness monuments shown on the drawing in (a), above.
- (E) Was the corner reestablished through lost corner proportionate methods? If so, show the method, including the directions and distances to other public land survey corners used as evidence or used for proportioning the corner location.
- I, **Donald Barnes**, hereby certify that the corner location as identified by the corner code index was determined by me under my direction and control and that this U.S. Public Land Survey Monument Record is correct and complete to the best of my knowledge and belief.

Londo Barres
Emboss 03/08/03

SHEET 3 OF 3

CORNER GODE E-21(1)A-E 7.08 REQUIREMENT