
U.S. PUBLIC LAND SURVEY MONUMENT RECORD

For Public Land Survey Corners in:

WI ADMINISTRATIVE CODE A-E 7.08 REQUIREMENT

T. 2N., R. 1/E

CORNER CODE INDEX

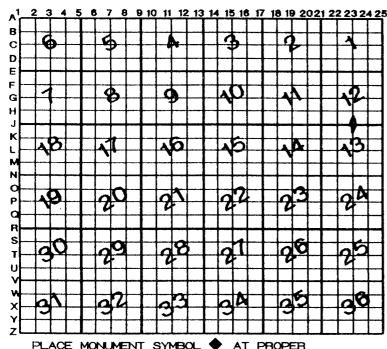

PLYIN	OUTH	TWI
	COUNTY	

IF AVAILABLE ROCK COUNTY COORDINATES PERFERRED

North	Elev
East	
Hor. Datum	Vert. Datum
LATITUDE	ELLIPS. H
LONGITUTE	
GPS (X)	TRAVERSE (X)
BASED ON THE	FOLLOWING CONTROL:

♦ CORNER MONUMENT

LOCATION ON ABOVE INDEX

O WITNESS MONUMENT

BEARINGS ARE BASED ON:

(a)

OBSERVATION SHEETS 338 & SSZ

FIELD BOOK _____PAGE # ____ SHEET ___ OF ____ SHOW A PLAN VIEW DRAWING DEPICTING THE CORNER MONUMENT AND SURROUNDING PHYSICAL FEATURES, INCLUDING THE EXCAVATION AREA AND DEPTH.

PLANNING & ZONING COMMITTEE ADOPTED THE ABOVE FORM ON 12/2/1982

corner code J-23(1)

PL552

(B) Describe any record evidence, monument evidence, occupational evidence, testimonial evidence or any other material evidence you considered, and whether the monument was found or placed.

1833 HARRISON EAST ON RANDOM BET SECS 12 & 13

1716 LEFT TIMBER & ENTER MARSH

2640 TEMPY QR P

5307.72 INT. E. BDY 22.44' N \Box F P LAND LEVEL 2^{ND} RATE FOR WEST $\frac{1}{2}$ MILE WITH RED & BURR & BLK \Box LAST $\frac{1}{2}$ LEVEL & WET 3^{RD} RATE MARSH

WEST COR. WEST

2653.86 QUARTER SEC COR. (BURR O 14 NB6W 891' BURR O 14) MARKED

5307.72 SEC COR.

- 1864 LOCKE VOL 1 PG 218 & MAP#4342 FD 8TS. SET LARGE HH L.S. ON E. WHITE LARGE LIMY SANDSTONE S & W IN MOUND. PIT 4' EAST. 2709.96 TO SW COR SEC 12, 2602.38 TO SE COR SEC 12, VAR 8-00 2651.88 TO CENTER SEC 12, & VAR 5-25 2651.88 FROM CENTER SEC 12 TO N 1/4 COR SEC 12. CENTER SET BY EQUAL DISTANCE METHOD.
- 1868 LOCKE PG 30 EAST BETWEEN SECS 12 & 13 VAR 5-12
 2716.56 INTERSECTED 1/4 LINE AT COR. FOUND BT & COR
 AS SET BY SELF. (SEE CO. SURVEYORS RECORD
 SEC 12) COR IN LINE OF FENCE RUNNING E & A
 LITTLE WEST OF FENCE RUNNING N

CONTINUED EAST FROM 1/4 COR WITH VAR 5-35

5328.84 INTERSECTED EAST BOUNDARY AT COR.

(REMONUMENTATION PLACED CUT LIME STONES)

- 1870 RUGER VOL 2 PG 33 STONE MON SET BY LOCKE VAR 6-10 ON N/S CENTER LINE SEC 13
- 1876 RUGER VOL 2 PG 205 STONE MON. VAR 3-55 2720.52 TO SW COR SEC 12, VAR 4-10 2608.32 TO SE COR SEC 12, VAR 5-27 2651.22 TO CENTER SEC 12, & VAR 5-27 5296.83 TO N 1/4 COR SEC 12. IN MAKING THE SURVEY I TESTED THE STONE MON.'S ESTABLISHED BY LOCKE & FOUND THEM CORRECT.
- 1966 BATTERMAN VOL 4 PG 295 FD CUT LIMESTONE TILTED.
 STRAIGHTENED. SURROUNDED WITH HH SET YELLOW POST
 SW OF STONE. 2660.36 TO CENTER OF SEC 12 (FD RUGERS
 STONE)
- 1972 LEE VOL 4 PG 587 FD CUT STONE. 2715.85 TO SW COR SEC 12, 2611.60 TO SE COR SEC 12, ANGLE 88-34-44 @ S ¼ COR SEC 12 FROM SW TO CENTER SEC 12, ANGLE 91-25-16 @ S ¼ COR SEC 12 FROM CENTER SEC 12 TO SE COR SEC 12, ANGLE 91-10-02 @ CENTER SEC 12 FROM S ¼ COR SEC 12 TO W ¼ COR SEC 12, ANGLE 88-38-39 @ CENTER SEC 12 FROM E ¼ COR SEC 12 TO S ¼ COR SEC 12, & ANGLE 180-00-00 @ S ¼ COR SEC 12 FROM SE TO SW CORNERS SEC 12.
- 1980 BARNES VOL 6 PG 29 FROM DATA IN VOL 4 PG 587. 589-56-25E 2613.47 TO SE COR SEC 12 & NO-56-17W 2660.49 TO CENTER SEC 12.
- 1982 LEUNMBERGER MAP#04308 USED COR TO SUBDIVIDE SEC 12.
- 1982 BARNES VOL 6 PG 282 RECORD COORDINATES: S 1/4 COR SEC 12 N/S 235,521.26; E/W 2,231,443.85 & CENTER SEC 12 N/S 238,181.39; E/W 2,231,400.29
- 1988 BARNES VOL 6 PG 379 BEARINGS & DISTANCES COMPUTED FROM REC. STATE PLANE COORDINATES. NO-56-17W 2660.49 TO CENTER SEC 12 & ANGLE @ CENTER SEC 12 FROM 5 $\frac{1}{4}$ COR SEC 12 TO W $\frac{1}{4}$ COR SEC 12 91-10-01 (LEE 91-10-02).

SHEET/ OF 3

J-23(/)

Den 1 de fames 02/06/03 FD 1 1/2" PIPE 3' DEEP. PLACED 3 MAGNETS ON TOP OF PIPE & 1 MAGNET 15' ABOVE PIPE. LANDOWNER STATED HE REMOVED THE FENCE LINE & THE STONE, BUT HE PLACED A PIPE IN THE HOLE CREATED BY THE STONE.

C) Was the corner restored through acceptance of (1) an obliterated evidence location, or, (2) a found perpetuated location?

DISTANCES AND ANGLES ARE IN HARMONY WITH LEE'S RECORD MEASUREMENTS TO THE WEST & NORTH. ACCEPTED FOUND MONUMENT. ALSO IN HARMONY WITH WP&L COORDINATES.

- D) Describe any material discrepancy between the location of the corner as restored or reestablished and the location of that corner as previously restored or reestablished by distance and direction. Show the discrepancy on the plan view drawing under (a), above. Show the distances between the corner as previously restored or reestablished and (1) the corner as restored or reestablished, and (2) to at least 4 of the witness monuments shown on the drawing in (a), above.
- (E) Was the corner reestablished through lost corner proportionate methods? If so, show the method, including the directions and distances to other public land survey corners used as evidence or used for proportioning the corner location.
- I, Donald Barnes, hereby certify that the corner location as identified by the corner code index was determined by me under my direction and control and that this U.S. Public Land Survey Monument Record is correct and complete to the best of my knowledge and belief.

ald baines

SHEET 2 OF 3

2/06/03

CORNER CODE J-23/)

A.E. 7.08 REQUIREMENT

