

U.S. PUBLIC LAND SURVEY MONUMENT RECORD

For Public Land Survey Corners In:

WI ADMINISTRATIVE CODE A-E 7.08 REQUIREMENT

T. 2N. R. 11E.

CORNER CODE INDEX

1	2	3	4	5	6	7	8	9	10	11	12	13	14	15	16	17	18	19	20	21	22	23	24	25	
A																									A
B																									B
C																									C
D																									D
E																									E
F																									F
G																									G
H																									H
J																									J
K																									K
L																									L
M																									M
N																									N
O																									O
P																									P
Q																									Q
R																									R
S																									S
T																									T
U																									U
V																									V
W																									W
X																									X
Y																									Y
Z																									Z

PLYMOUTH TWP

ROCK COUNTY WI

IF AVAILABLE
ROCK COUNTY COORDINATES PREFERRED

North _____ Elev. _____

East _____

Hor. Datum _____ Vert. Datum _____

LATITUDE _____ ELLIPS. HT. _____

LONGITUDE _____

GPS (X) _____ TRAVERSE (X) _____

BASED ON THE FOLLOWING CONTROL:


1 2 3 4 5 6 7 8 9 10 11 12 13 14 15 16 17 18 19 20 21 22 23 24 25
PLACE MONUMENT SYMBOL AT PROPER
LOCATION ON ABOVE INDEX

CORNER MONUMENT

WITNESS MONUMENT

(a)

BEARINGS ARE BASED ON:

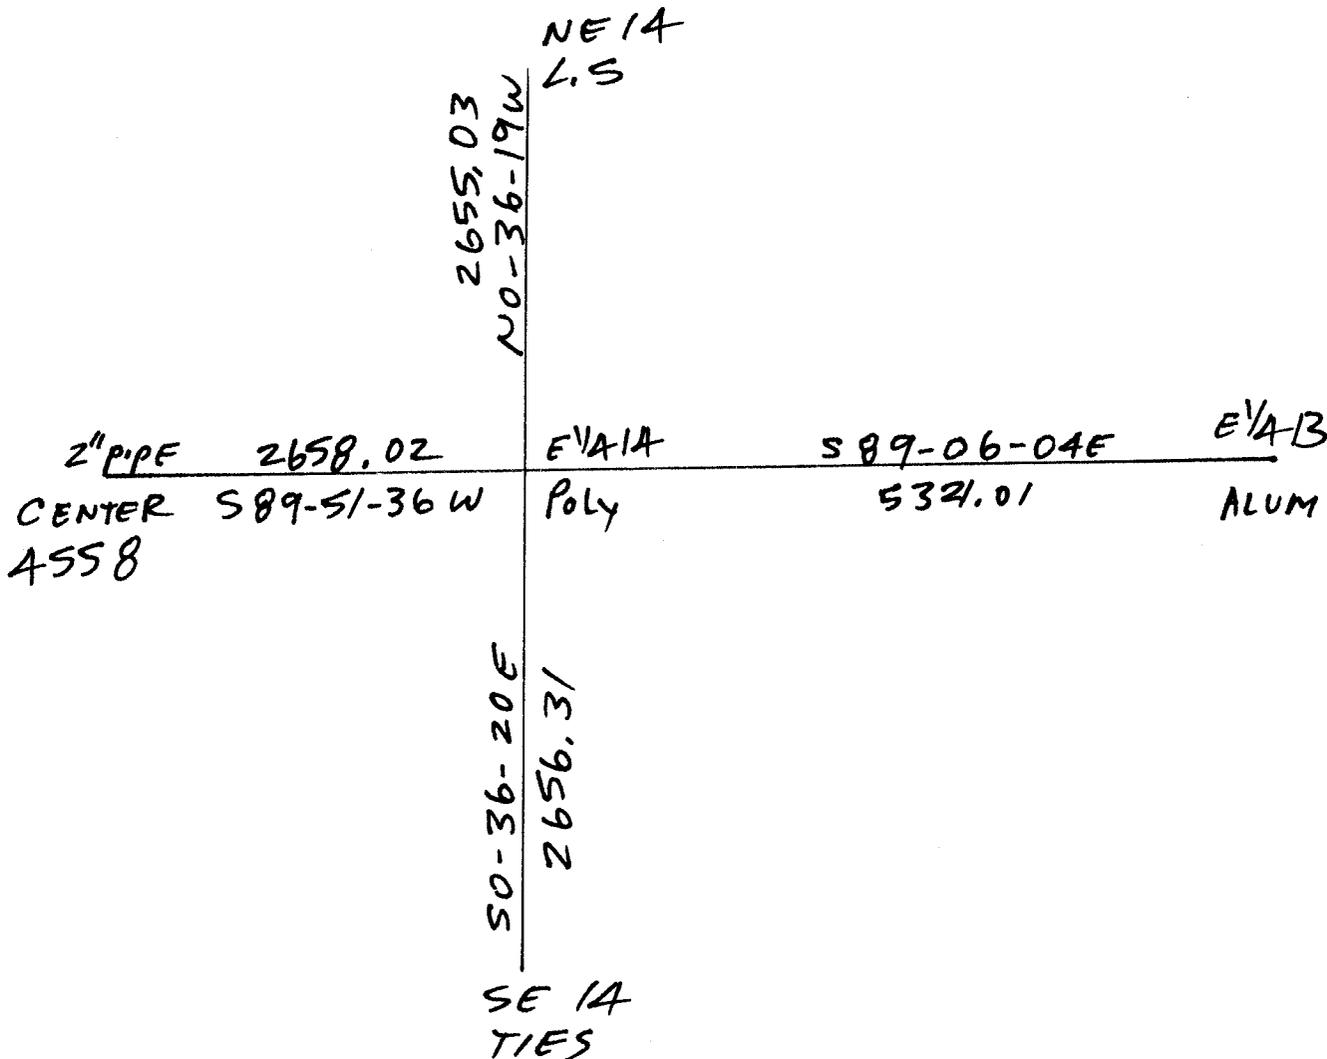

OBSERVATION SHEET 63,203

FIELD BOOK _____ PAGE # _____

SHEET 1 OF 2

SHOW A PLAN VIEW DRAWING DEPICTING THE CORNER MONUMENT AND SURROUNDING PHYSICAL FEATURES, INCLUDING THE EXCAVATION AREA AND DEPTH.

PLANNING & ZONING COMMITTEE ADOPTED THE ABOVE FORM ON 12/2/1982

CORNER CODE L-21(1)

PL559

(B) Describe any record evidence, monument evidence, occupational evidence, testimonial evidence or any other material evidence you considered, and whether the monument was found or placed.

- 1833 HARRISON NORTH BETWEEN SECS 13 & 14
1056 LEFT MARSH & ENTER TIMBER
1914 LEFT TIMBER & ENTER MARSH
2095.5 BROOK 49.5' CRS SE
2640 QUARTER SEC COR. IN MARSH SET POST
4488 LEFT MARSH & ENTER TIMBER
4625.94 BLACK O 36
4722.96 BURR O 34
5280 COR TO SEC 11,12,13,14 {BURR O 16 N32W 49.5'
BUR O 14 N71E 34.98', BURR O 13 S69E 39.6',
WH O 11 S19W 40.26'} LAND MOSTLY LEVEL WITH
3RD MARSH WITH GRASS & WEEDS
- 1856 CHURCH VOL 1 PG 64 VAR 7-10 2640 TO CENTER SEC 14 &
VAR 7-10 5280 TO W ¼ COR SEC 11
- 1861 RUGER VOL 1 PG 172 VAR 7-52 TO SW COR SEC 13 & VAR 7-
00 2655.18 TO CENTER SEC 13 & VAR 7-00 5310.36 TO E ¼
COR SEC 13.
- 1868 LOCKE PG 29 NORTH BETWEEN SECS 13 & 14 VAR 7-05
1056 BR O B 1.98' EAST OF LINE
2112 BASS CREEK SOUTH BANK
2138.4 BASS CREEK NORTH BANK
2640 SET TEMPORARY ¼ COR COR LOST.
3002.34 CENTER B&M RR
4579.08 CENTER M& M R.R
5311.68 INTERSECTED NORTH BOUNDARY 1.32' WEST OF
COR. FOUND BT IN SEC 13 STUMPS OF BT IN SECS
11 AND 12 AND COR AS SET BY SELF (SEE CO.
SURVEYORS RECORD SEC 12) COR AT
INTERSECTION OF FENCES.
2655.84 SET PERMANENT ¼ COR 15.84' NORTH AND .66' E
OF TEMPORARY ¼ COR. VAR CORRECTED 7-04
AUG 26 1868
- 1869 LEE VOL 2 PG 2 FD MON. VAR 7 2657.16 TO SE COR SEC
14, VAR 7-15 2658.48 TO NE COR SEC 14, & VAR 6-45
2662.44 TO CENTER SEC 14.
- 1870 RUGER VOL 2 PG 33 STONE MON BY LOCKE. 2624.49 TO
CENTER SEC 13 & 5305.58 TO E ¼ COR SEC 13
- 1874 RUGER VOL 2 PG 138 STONE MON.
- 1910 KERCH VOL 3 PG 61 2659.2 TO CENTER SEC 14, ANGLE 89-
32-45 @ E ¼ COR SEC 14 FROM CENTER SEC 14 TO CENTER
R/R TRACK 362.35', SOUTHERLY 462.4 TO SET IRON PIN,
ANGLE 54-32-15 @ CENTER OF R/R TRACK FROM CENTER OF
R/R TRACK NORTHWESTERLY TO NE COR SEC 14, & 1327.9
SOUTHERLY FROM NE COR SEC 14 TO 1/16TH COR.
- 190? CVK MAP #4355 DOES NOT STATE MON. 300.96 SOUTH OF
SOUTH R/R ROW LINE. R/R ROW IS 100. AT SEC LINE THE
DISTANCE FROM THE SOUTH R/W LINE TO THE NORTH R/W LINE IS
122.78 & THE BEARING OF THE R/R IS N54-32-152W.
- 1982 BARNES L-21 DUG & FD FEW 3/8" X 24 X 6" PIECES OF CUT
LIMESTONE SCATTERED AROUND THE RE-ESTABLISHED
CORNER. KERCH'S RECORD DISTANCE TO THE CENTER OF
SEC 14 AND THE RECORD DISTANCE TO THE R/R TRACKS WAS
USED TO SET THE COR. THIS WAS IN HARMONY WITH
KERCH'S ANGLE AND RECORD DISTANCE TO THE N ¼ COR OF
SEC 14. ALSO IT IS ON LINE WITH THE E ¼ COR & CENTER
OF SEC 14. LOCKE SET THE COR ON LINE WITH THE NW & SW
CORNERS OF SEC 13. THE RE-ESTABLISHED COR IS ALSO
ON LINE WITH THE NW & SW CORNERS. THE CORNER WAS
RESTORED THROUGH ACCEPTANCE OF OBLITERATED
EVIDENCE LOCATION. MAP SHOWS EXCAVATION HOLE &
REFERENCE MONUMENTS. 2658.20 TO C.I @ CENTER OF SEC
14. WEST SIDE OF DITCH. PLACED POLY. MON. 363.6 TO
CENTER OF TRACKS (KERCH 362.35; LOCKE 346.5)

SHEET 1 OF 2 CORNER CODE L-21(1)

Donald Barnes

May 12, 2003

PL559

1982 BARNES R-21 NO-32-40W 2655.05 TO NE COR SEC 14 & SO-38-25W 2656.29 TO SE COR SEC 14.

1982 BARNES VOL 6 PG 282 SO-38-25E 2656.29 TO SE COR SEC 14, NO-38-20W 2655.05 TO NE COR SEC 14, NB9-49-47W 2658.20 TO CENTER SEC 14, SB9-49-3W 1334.05 FROM CENTER 14 TO 1/16TH COR, & SB9-49-16W 1334.49 FROM 1/16TH COR TO W 1/4 COR SEC 14.

1982 LEUNMBERGER MAP #4308 STATES NOTHING.

1992 SCROEDER GSM VOL 16 PG 108 STATES NOTHING.

2002 ERICKSON FED. PRELIM. NADB3 232,896.825 N/S;
2,197,248.38

E/W REDUCED TO COUNTY - 251967.505 N/S; 459084.939' E/W.
NADB3 SB9-13-23W 2657.88 TO CENTER SEC 14, NADB3 SB9-44-16E 5320.89 TO E 1/4 COR SEC 13, SD1-13-54E 2656.59 NADB3 TO SE COR SEC 14, N1-12-35W 2655.04 NADB3 TO W 1/4 COR SEC 13.

USED MY 1982 OBSERVATIONS

C) Was the corner restored through acceptance of (1) an obliterated evidence location, or, (2) a found perpetuated location?

ACCEPTED ~~ATTN~~. Poly

D) Describe any material discrepancy between the location of the corner as restored or reestablished and the location of that corner as previously restored or reestablished by distance and direction. Show the discrepancy on the plan view drawing under (a), above. Show the distances between the corner as previously restored or reestablished and (1) the corner as restored or reestablished, and (2) to at least 4 of the witness monuments shown on the drawing in (a), above.

(E) Was the corner reestablished through lost corner proportionate methods? If so, show the method, including the directions and distances to other public land survey corners used as evidence or used for proportioning the corner location.

I, Donald Barnes, hereby certify that the corner location as identified by the corner code index was determined by me under my direction and control and that this U.S. Public Land Survey Monument Record is correct and complete to the best of my knowledge and belief.

Seal

Donald Barnes

May 12 2003

Emboss

SHEET 2 OF 2

CORNER CODE L-21(1)
A-E 7.08 REQUIREMENT