

U.S. PUBLIC LAND SURVEY MONUMENT RECORD

For Public Land Survey Corners in:

WI ADMINISTRATIVE CODE A-E 7.08 REQUIREMENT

T. 2 N., R. 11 E

CORNER CODE INDEX

A	2	3	4	5	6	7	8	9	10	11	12	13	14	15	16	17	18	19	20	21	22	23	24	25	
B																									
C	6					5				A			3				2						1		
D																									
E																									
F																									
G	1					8				9			10				11						12		
H																									
J																									
K																									
L	18					17				16			15				14						13		
M																									
N																									
O																									
P	19					20				21			22				23						24		
Q																									
R																									
S	30					29				28			27				26						25		
T																									
U																									
V																									
W																									
X	31					32				33			34				35						36		
Y																									
Z																									

PLYMOUTH TWP
ROCK COUNTY WI

IF AVAILABLE
ROCK COUNTY COORDINATES PREFERRED

North _____ Elev. _____

East _____

Hor. Datum _____ Vert. Datum _____

LATITUDE _____ ELLIPS. HT. _____

LONGITUDE _____

GPS (X) _____ TRAVERSE (X) _____

BASED ON THE FOLLOWING CONTROL:

PLACE MONUMENT SYMBOL  AT PROPER LOCATION ON ABOVE INDEX

 CORNER MONUMENT  WITNESS MONUMENT

(a)

BEARINGS ARE BASED ON:

OBSERVATION SHEETS 331, 591, 60, 1591

FIELD BOOK _____ PAGE # _____ SHEET 1 OF 4

SHOW A PLAN VIEW DRAWING DEPICTING THE CORNER MONUMENT AND SURROUNDING PHYSICAL FEATURES, INCLUDING THE EXCAVATION AREA AND DEPTH.

PLANNING & ZONING COMMITTEE ADOPTED THE ABOVE FORM ON 12/2/1982

CORNER CODE R-21(2)

PL591

(B) Describe any record evidence, monument evidence, occupational evidence, testimonial evidence or any other material evidence you considered, and whether the monument was found or placed.

1833 HARRISON NORTH BETWEEN 25 & 26 (VAR B-DOE)

324.72 RED OAK 24 IN DIAM

657.36 ELM 12 IN DIAM

1151.04 ASH 36 IN DIAM

1617 CHERRY 24 IN DIA

2640 QUARTER SEC COR. {BUR OAK 14 S29E 129.36'
ASPEN 6 N66W 63.36'} BUR OAK O 14 ASPEN 6}
MARKED

4290 LEFT TIMBER ENTER MARSH

5082 LEFT MARSH ENTER TIMBER

5280 COR TO SECS 23,24,25,26 {BUR O 8 S73E 36.96'
BUR O 9 N56E 53.46' BURR O 1 S56W 90.42' W O 36
N19W 164.34' LAND HIGH R?? 1ST RATE TIMBER RED,
W, & BURR O. ASPEN, ELM WALNUT.

EAST BETWEEN SEC 24 & 25

2640 TEMP 1/4 P

3630 LEFT TIMBER & ENTER MARSH

5294.52 INT. E BDY 76.56' N OF P LAND HIGH RICH & ROLLING
FOR THE 1ST 1/4 MILE WITH TIMBER HICHY, W.O. BURR O
RED O & LAST 1/2 LEVEL & WET 3RD RATE BEING MARSH
WEST COR. WEST

2442 HICKY 12

2647.26 QUARTER SEC COR {W.O. 24 S73W 14.52' W.O. 36
S15E 40.92' W.O. 24 W.O. 36} MARKED

5148 BUR O 24

5294.52 SEC COR.

EAST ON RAND. BET. 23 & 26

1320 LEFT TIMBER & ENTER MARSH

2508 LEFT MARSH

2640 TEMPY 1/4 P

2805 LEFT TIMBER & ENTER MARSH

3300 LEFT MARSH & ENTER TIMBER

3696 LEFT TIMBER & ENTER MARSH

5148 LEFT MARSH & ENTER TIM.

5299.8 INT. E BDG 52.8' S OF P. LAND LEVEL & WET 3RD
RATE TIMBER W.O. & BURR O

COR. WEST

2649.90 QUARTER SEC COR. {W.O. 24 N32E 214.5' W.O. 24
S29W 225.06' W.O 24 W.O. 24} MARKED

4620 W.O. 30

5299.8 SEC COR

NORTH BETWEEN SECS 23 & 24

1452 LEFT TIMBER & ENTER MARSH

2640 QUARTER SEC COR IN MARSH POST & MOUND OF
TUSSACKS

5280 COR TO SECS 13,14,23,24 IN MARSH {RED O 18 N3E
1067.88' RED O 9 N2W 1072.5' LAND SOUTH 1/4 AS
BEFORE LAST 3/4 LEVEL & WET 3RD RATE MARSH

1849 Mc VANE TOWN ROAD RECORDS BK 1 PG 26 """" THE WIDTH OF
49.5' AND SAID COMMISSIONERS HAVE CAUSED A SURVEY
THERE OF TO BE MADE AS FOLLOWS; THE CENTER LINE OF SAID
HWY IS TO COMMENCE AT THE NW COR OF SEC 25; THENCE
RUNNING SOUTH ON THE EAST ON THE SECTION 26 TO THE SW
COR OF SAID SEC 25; THENCE SOUTH ON THE SEC LINE BETWEEN
SEC 35 AND SEC 36 TERMINATING ON THE SOUTH LINE OF SAID
TOWN THE CENTER OF HWY TO BE ON THE SEC LINE.

1853 TWP RD REC BK 1 PG 30 & 31 """" HWY BE LAID OUT IN SAID
TOWN OF THE WIDTH OF 66' WIDE AND HAVE CAUSED A
SURVEY THERE OF TO BE MADE AS FOLLOWS: THE CENTER LINE
OF THE SAID HWY IS TO COMMENCE 1320' EAST OF THE SW COR

SHEET 1 OF 4 CORNER CODE R-21(2)

2/12/03
Donald Barnes

PL591

OF SEC 23; THENCE RUNNING EAST ON THE SEC LINE TO THE SW COR OF SEC 24; THENCE EAST 825' RUNNING 33' SOUTH AND PARALLEL WITH SECTION LINE BETWEEN SECS 24 AND 25; THENCE EAST ON THE SECTION LINE BETWEEN 24 AND 25 TO THE EAST LINE OF SAID TOWN.

1868 LOCKE PG 2 EAST BETWEEN SECS 23 & 26 VAR 6-25E
AUG 17, 1868

2659.14 INTERSECTED 1/4 LINE AT 1/4 COR FOUND STUMP OF SOUTH B.T. AND WHERE NORTH B.T. WAS DUG OUT AND OLD STAKE. COR IN CENTER OF HIGHWAY & 3' WEST OF FENCES RUNNING NORTH & SOUTH.

CONTINUED EAST FROM 1/4 COR WITH VAR 6-15

5330.16 INTERSECTED EAST BOUNDARY 15.18' SOUTH OF COR. FOUND B.T.S IN SECS 24 & 25 AND STUMPS OF BTS IN 23 AND 26 COR IN CENTER OF HIGHWAY RUNNING WEST AND SOUTH AND 2 FT SOUTH OF FENCE ON NORTH SIDE OF HIGHWAY RUNNING EAST & 2 FT WEST OF FENCE RUNNING NORTH. VAR CORRECTED 6-35
PG 3 EAST BETWEEN SECS 24 & 25

0 SET OFF 14.85' SOUTH VAR 6-30E

1320 SET OFF 8.58' SOUTH

2661.45 INTERSECTED 1/4 LINE 2.64' NORTH OF 1/4 COR FOUND STUMPS OF B.T.S & OLD STAKE COR IN CENTER OF HIGHWAY & IN LINE WITH FENCES RUNNING NORTH AND SOUTH VAR CORRECTED 5-56

CONTINUED EAST FROM 1/4 COR WITH VAR 6-10

3498 SET OFF 46.2' SOUTH

5332.47 INTERSECTED EAST BOUNDARY 15.18' NORTH OF COR. FOUND MOUND IN LINE WITH FENCES RUNNING SOUTH & EAST VAR CORRECTED 4-50 AUG 18, 1868
PG 6 NORTH BETWEEN SECS 25 & 26 VAR 7-15

2666.07 INTERSECTED 1/4 LINE AT COR. FOUND COR AS SET BY SELF (SEE COUNTY SURVEYORS RECORD SEC 26) & BT IN SEC 25. CORNER IN CENTER OF HIGHWAY & IN LINE WITH FENCE RUNNING WEST

CONTINUED NORTH FROM 1/4 COR WITH VAR 7

5330.49 INTERSECTED NORTH BOUNDARY 16.5' EAST OF COR VAR CORRECTED 7-21 AUG 18 1868
PG 25 SOUTH BETWEEN SECS 23 & 24 VAR 7-30

2650.56 SET TEMPORARY 1/4 COR. COR LOST

5302.44 INTERSECTED SOUTH BOUNDARY 28.38' EAST OF COR.

2651.22 SET PERMANENT 1/4 COR 0.66' SOUTH AND 14.19' WEST OF TEMPORARY 1/4 COR. COR IN LINE OF E & W FENCE AND 14.52' E OF N & S FENCE VAR CORRECTED 7-12 SET THE MONUMENT IN MOUND OF TUSSACKS.
AUG 24, 1868

1869 LEE VOL 1 PG 338 FOUND MONUMENT. SHOWS 2671.68 TO N 1/4 COR SEC 26 AND 2665.74 TO E 1/4 COR SEC 26

1870 RUGER VOL 2 PG 47 STONE MON. SET BY LOCKE. SHOWS 2645.28 TO E 1/4 COR SEC 23 AND 2663.10 TO S 1/4 COR SEC 23.

1961 BATTERMAN JR. VOL 4 PG 121 SET MONUMENT BOX OVER 1" PIPE AND REFERENCED SAME. FOUND BROKEN PART OF MONUMENT IN DITCH AND DUG 20X20X4 HOLE LOOKING FOR REMAINS OF MONUMENT BUT COULDN'T FIND ANY SO RESET CORNER BY DOUBLE PROPORTIONATE MEASUREMENT. SHOWS THE FOLLOWING DISTANCES:

2660.94 TO S 1/4 COR SEC 23

2676.12 TO S 1/4 COR SEC 24

2659.99 TO E 1/4 COR SEC 26

1981 THOM CSM VOL 10 PG 379 1" PIPE IN MON. BOX

SHEET 2 OF 4 CORNER CODE R-21(2)

D. J. Barnes
2/12/03

PL591

1982 BARNES VOL 6 PG 282 & P-21 SHOWS RECORD DISTANCES AND THE FOLLOWING DISTANCES TO THE POLY MONUMENT:

S89-42-26W 2673.58 TO N 1/4 COR SEC 26

S89-34-09E 2664.01 TO S 1/4 COR SEC 24

NO-45-41W 2651.66 TO E 1/4 COR SEC 23.

FOUND A R/R SPIKE AT THE S 1/16TH CORNER OF THE SW 1/4 OF SEC 24. IT IS ON LINE WITH THE S 1/4 COR SEC 24 AND THE PIPE IN THE MONUMENT BOX.

1982 BARNES R-21 & P-21 FOUND REMAINS OF OLD E/W FENCE LINE TO THE EAST. USED CALL DISTANCES IN LOCKES FIELD NOTES TO THE FENCE AND ROAD. PLACED POLY MONUMENT. THIS IS ALSO IN HARMONY WITH HIS DISTANCES AND PRORATING THE ORIGINAL GOVERNMENT DISTANCES. SHOWS N67-38-02E 13.19' FROM THE PIPE IN THE MONUMENT BOX TO THE POLY MONUMENT.

1991 BARNES R-21(1) 1990 MR. EMERY HORKEY, COUNTY BOARD SUPERVISOR, STATED THAT HE LIVED ON ADJACENT FARM AND REMEMBERS THE CUT LIMESTONE. HE WENT TO THE SITE AND STATED THAT IT WAS ABOUT WHERE THE POLY STONE IS.

1996 KREBS MAP #08905 FD ALUM AT SW COR. FD 1" PIPE IN MON. BOX 13 +/- SW OF ALUM. USED ALUM. BECAUSE THE W 1/4 COR WAS SET BY USING THE ALUM. N89-41-11W 2673.43 TO S 1/4 COR SEC 23, N88-57-40E 2664.23 TO S 1/4 COR SEC 24, & NO-08-56W 2651.83 TO W 1/4 COR SEC 24.

1997 COMBS CSM VOL 20 PG 303 ALUM. MON. 2661.30 TO PIPE IN MON. BOX. @ S 1/4 COR SEC 23.

2002 ERICKSON FED PRELIMINARY 224,939.140N/S;
2,197,433.061E/W NAD83 REDUCED TO COUNTY
244,008.177N/S; 459,180.878 E/W N89-4-24E 2664.31 NAD83
TO S 1/4 COR SEC 24 & NO1-22-31W 2651.62 TO W 1/4 COR SEC 24.

FD POLY. MON. 12" DEEP MON & TIES. IT IS NORTH OF NORTH PVMT EDGE.

C) Was the corner restored through acceptance of (1) an obliterated evidence location, or, (2) a found perpetuated location?

ACCEPTED FOUND POLY AS PLACED. IT IS IN HARMONY WITH LOCKE'S REMONUMENTATION DISTANCES.

D) Describe any material discrepancy between the location of the corner as restored or reestablished and the location of that corner as previously restored or reestablished by distance and direction. Show the discrepancy on the plan view drawing under (a), above. Show the distances between the corner as previously restored or reestablished and (1) the corner as restored or reestablished, and (2) to at least 4 of the witness monuments shown on the drawing in (a), above.

DISCREPANCY WAS STATED IN PREVIOUS RECORDS.

I, Donald Barnes, hereby certify that the corner location as identified by the corner code index was determined by me under my direction and control and that this U.S. Public Land Survey Monument Record is correct and complete to the best of my knowledge and belief.

Seal

Donald Barnes
3-7-03


Emboss

SHEET 3 OF 4


CORNER CODE

R-21(2)

A-E 7.08 REQUIREMENT

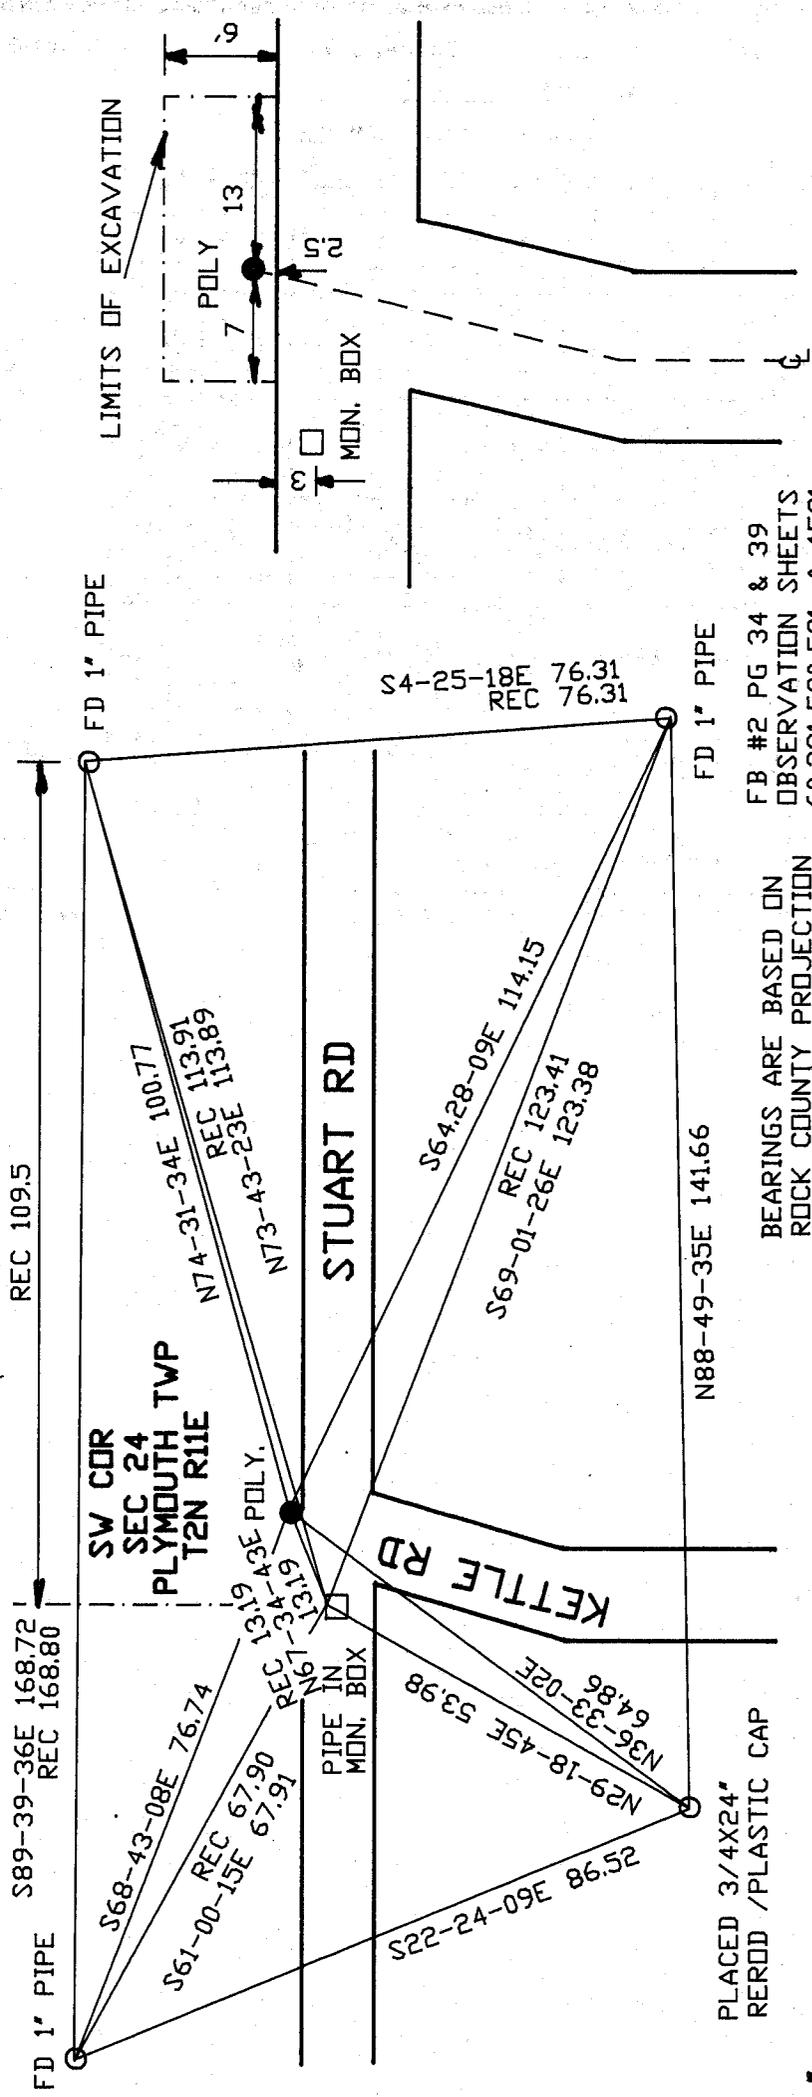

LIMITS OF EXCAVATION

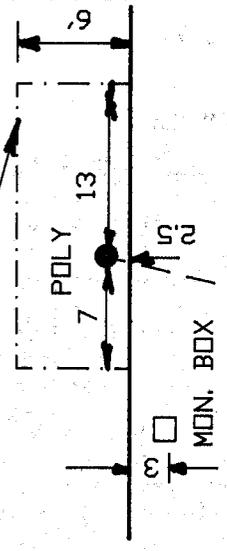

FB #2 PG 34 & 39
 OBSERVATION SHEETS
 60,331,590,591, & 1591

BEARINGS ARE BASED ON
 ROCK COUNTY PROJECTION

SHEET 4 OF 4

EMBOSSED
 SEAL
Donald Barnes
 2-12-03

R-21(2)