U.S.

PUBLIC SURVEY

	M	ON	IUN	1E	NT	RECORD
For Public		Survey R//	4	in:		VI ADMINISTRATIVE CODE A-E 7.08 REQUIREMEN
1 2 2 4 5		RNER C				PLYMOUTH TWP
A 2 3 4 5	المأ		7	16 10 202	22232428	ROCK COUNTY WI
C W						IF AVAILABLE ROCK COUNTY COORDINATES PERFERRE
F G	8	9	10		12	
H						North Elev
<u> </u>	- AU	10	10		13	East
N						Hor. Datum Vert. Datum
P 19	20	5)	24	23	24	LATITUDE ELLIPS
s s	09	48		06	â	LONGITUTE
Ų T	4	4	P	9	4	GPS (X) TRAVERSE (X) _
× 91	32	33	38	35	30	BASED ON THE FOLLOWING CONTROL
ž dos		SYMBOL				
		SYMBOL BOVE IND		HOPEH	n na sa sa san na sa	An order and the second
(a)	• C	ORNER	MONUM	IENT	0	WITNESS MONUMENT
· 1		en e				
i y i y i w	ر المراقع الم المراقع المراقع المراق					
					ar Ni≥ ty ty et nort s	
1.						

BEARINGS ARE BASED ON:

PAGE # SHOW A PLAN VIEW DRAWING DEPICTING THE CORNER MONUMENT AND SURROUNDING PHYSICAL FEATURES, INCLUDING THE EXCAVATION AREA AND DEPTH. PLANNING & ZONING COMMITTEE ADOPTED THE ABOVE FORM ON 12/2/1982

PL607

- (B)Describe any record evidence, monument evidence, occupational evidence, testimonial evidence or any other material evidence you considered, and whether the monument was found or placed.
- 1855 CHURCH VOL 1 PG 38 STONE 12" LONG & 3" THICK. 2664.75 TO N 1/4 COR SEC 33 AND 2699.73 TO E 1/4 COR SEC 28.
- 1868 LOCKE REMONUMTATION NOTES PG 12 SOUTH BETWEEN SEC 27 AND 28 VAR 8
 40.42 INTERSECTED 1/4 LINE 31 LKS EAST OF COR. FOUND STONE SET BY
 CHURCH. (SEE COUNTY SURVEYORS RECORD SEC 28) AT JUNCTION OF
 FENCES FROM N.S AND E SEE PAGES 18 VAR CORRECTED 7-34. SET
 OFF 18 1/2 LKS WEST AND CONTINUED SOUTH FROM 1/4 COR WITH
 VAR 7-25.
 - 80.675 INTERSECTED SOUTH BOUNDARY 18 1/2 LKS WEST OF COR. FOUND B.TS IN SEC 27 AND 34 AND STUMP OF BT IN 33 AND OLD STAKE. BT IN 33 IS 1.35 DIST. COR IN CENTER OF HIGHWAYS RUNNING E. S. AND W. VAR CORRECTED 7-25

PG 13 WEST BETWEEN SEC 27 & 34 VAR 6-18

- 39.98 INTERSECTED 1/4 LINE 32 LKS. NORTH OF COR. FOUND WHERE BTS WERE DUG OUT AND STAKE. COR IN CENTER OF HIGHWAY AND IN LINE OF FENCE RUNNING NORTH VAR CORRECTED 5-50.
- 80.125 INTERSECTED EAST BOUNDARY 35 1/2 LKS SOUTH OF COR. VAR CORRECTED 5-50

PG 17 NORTH BETWEEN SEC 33 AND 34 VAR 7

- 40.23 INTERSECTED 1/4 LINE 1 LK EAST OF COR. FOUND STUMPS OF BTS AND STAKE UNDER STONE ON CORNER. THE DISTANCE AND COURSE OF EACH BT GIVEN FOR THE OTHER RIGHT WERE EXCHANGED. COR IN CENTER OF HIGHWAY AND IN LINE OF E & W FENCE. VAR CORRECTED 7-01 CONTINUED NORTH FROM 1/4 COR WITH VAR 7
- 47.25 BROOK 6 LKS WIDE COURSE SW
- 80.58 INTERSECTED NORTH BOUNDARY 5 LKS E OF COR VAR CORRECTED 7-04

PG 18 WEST BETWEEN SECS 28 & 33 VAR 6

- 2.17 BROOK BRIDGE 10 LKS WIDE
- 40.47 INTERSECTED 1/4 LINE AT STONE SET BY CHURCH CENTER OF ROAD. (SEE CO. SURVEYORS RECORD SEC 28). CONTINUED WEST WITH VAR 6-10
- 54.10 CENTER SLUICE BRIDGE 5 LKS WIDE.
- 80.94 INTERSECTED WEST BOUNDARY AT STONE SET BY CHURCH. (SEE CO. SURVEYORS RECORD) JAKE FISHER, T IMYLIE AND SEVERAL OTHER NEIGHBORS UNITE IN DECLARING THAT THE OLD CORNERS IN SEC 28 HAD BEEN KEPT UP & THAT THESE STONES SET BY CHURCH WERE SET WHERE THE OLD CORNERS WERE. COR 34 1/2 LKS SOUTH AND 2 LKS EAST OF CORNER OF J. FISHERS FENCES IN NORTH & WEST SIDES OF HIGHWAYS.
- 1871 RUGER VOL 2 PG 75 STONE MON. 2664.75 TO N 1/4 COR SEC 33, 2657.98 TO E 1/4 COR SEC 33.
- 1876 RUGER VOL 2 PG 206 STONE MON 2648.58 TO W 1/4 COR SEC 27, 2634.06 TO S 1/4 COR SEC 27.
- 1896 BROWN 2663.26 TO W 1/4 COR SEC 34. TAKEN FROM NOTES OF O.G. BROWN 1978 BARNES VOL 5 PG 473 N88-43-18W 2670.13 TO N 1/4 COR SEC 33, S88-57-56E 2637.93 TO N 1/4 COR SEC 34, S0-02-26W 2661.65 TO E 1/4 COR SEC 33.
- 1979 BARNES VOL 6 PG 125. DUG 30" DEEP AND FOUND OLD STONE ROAD BED. DUG 30" DEEPER THRU SAND AND FOUND NOTHING. SET ALUM. MON. AS CALLED FOR IN LOCKE'S REMONUMENTATION NOTES IN REGARDS TO THE CENTER OF THE ROAD. THIS WAS IN HARMONY WITH RECORD DISTANCES.

19?? WIDOT Z-13 & Z-13(1) REFERENCED MONUMENT.

DOT NOTIFIED ME THAT STH 213 WILL BE RESURFACED AND THIS WILL START IN APRIL. FOUND PK & 2' DEEP FOUND BOTTOM HALF OF ALUM. MON. PLACED * MAGNETS ON TOP OF MON. CHAD COMBS STOPPED AND STATED THAT HE PLACED THE PK FROM THE DOT TIES SEVERAL YEARS AGO.

C) Was the corner restored through acceptance of (1) an obliterated evidence location, or, (2) a found perpetuated location?
ACCEPTED FOUND ALUM. MON. WHICH PERPETUATED THE LOCATION.

- D) Describe any material discrepancy between the location of the corner as restored or reestablished and the location of that corner as previously restored or reestablished by distance and direction. Show the discrepancy on the plan view drawing under (a), above. Show the distances between the corner as previously restored or reestablished and (1) the corner as restored or reestablished, and (2) to at least 4 of the witness monuments shown on the drawing in (a), above. SEE DIAGRAM FOR DIFFERENCE BETWEEN PK AND ALUM. MON.
- (E) Was the corner reestablished through lost corner proportionate methods? If so, show the method, including the directions and distances to other public land survey corners used as evidence or used for proportioning the corner location.


I, Donald Barnes, hereby certify that the corner location as identified by the corner code index was determined by me under my direction and control and that this U.S. Public Land Survey Monument Record is correct and complete to the best of my knowledge and belief.

seal

Number of included sheets _____

Prolo Barres April 22 1998 A-E 7.08 REQUIREMENT

CORNER CODE

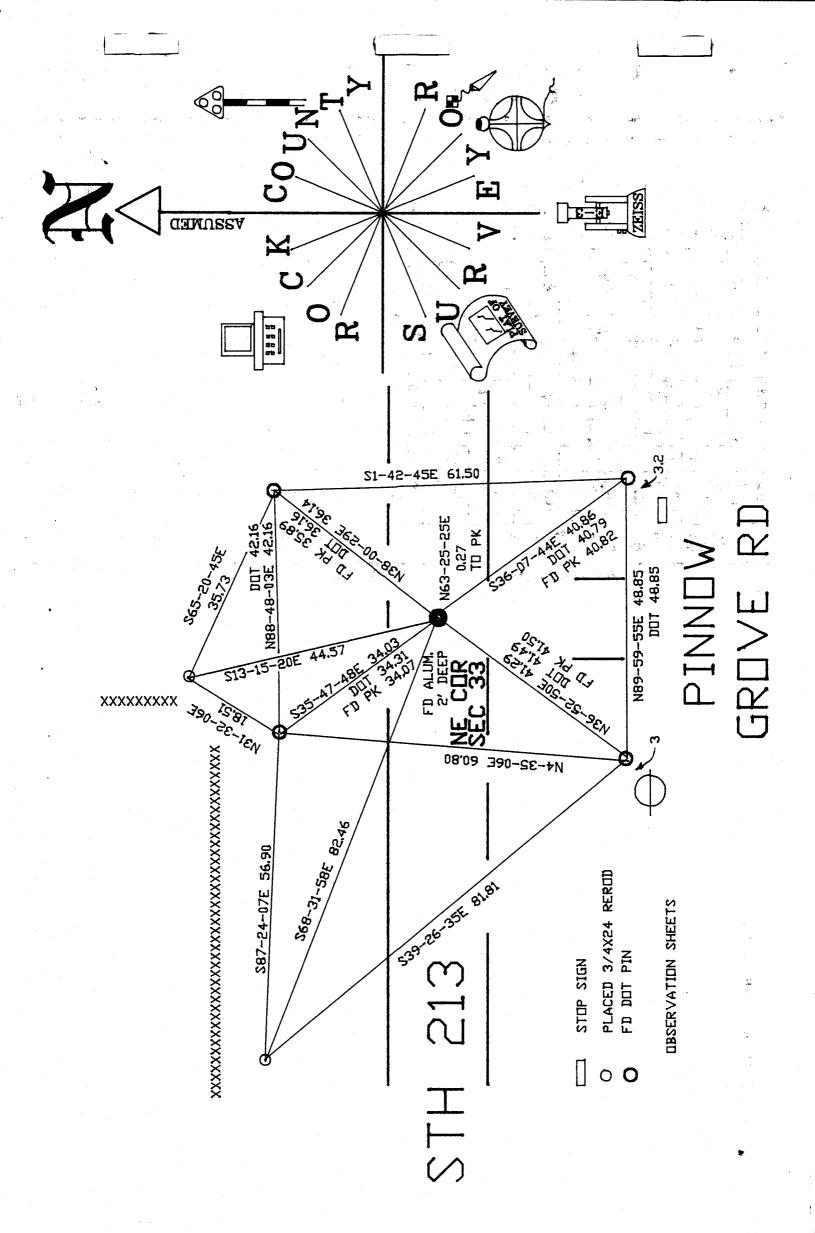

Desal Baines April 22,1998 V - 13(z)