

U.S. PUBLIC LAND SURVEY MONUMENT RECORD

For Public Land Survey Corners in:

WI ADMINISTRATIVE CODE A-E 7.08 REQUIREMENT

T. 2 N., R. 11 E

CORNER CODE INDEX

| | | | | | | | | | | | | | | | | | | | | | | | | | |
|---|----|---|---|---|---|---|----|---|---|----|----|----|----|----|----|----|----|----|----|----|----|----|----|----|----|
| A | 1 | 2 | 3 | 4 | 5 | 6 | 7 | 8 | 9 | 10 | 11 | 12 | 13 | 14 | 15 | 16 | 17 | 18 | 19 | 20 | 21 | 22 | 23 | 24 | 25 |
| B | | | | | | | | | | | | | | | | | | | | | | | | | |
| C | 6 | | | | | | 5 | | | | | | | | | | | | | | | | | | |
| D | | | | | | | | | | | | | | | | | | | | | | | | | |
| E | | | | | | | | | | | | | | | | | | | | | | | | | |
| F | 7 | | | | | | 8 | | | | | | | | | | | | | | | | | | |
| G | | | | | | | | | | | | | | | | | | | | | | | | | |
| H | | | | | | | | | | | | | | | | | | | | | | | | | |
| I | | | | | | | | | | | | | | | | | | | | | | | | | |
| J | | | | | | | | | | | | | | | | | | | | | | | | | |
| K | 18 | | | | | | 17 | | | | | | | | | | | | | | | | | | |
| L | | | | | | | | | | | | | | | | | | | | | | | | | |
| M | | | | | | | | | | | | | | | | | | | | | | | | | |
| N | | | | | | | | | | | | | | | | | | | | | | | | | |
| O | | | | | | | | | | | | | | | | | | | | | | | | | |
| P | 19 | | | | | | 20 | | | | | | | | | | | | | | | | | | |
| Q | | | | | | | | | | | | | | | | | | | | | | | | | |
| R | | | | | | | | | | | | | | | | | | | | | | | | | |
| S | | | | | | | | | | | | | | | | | | | | | | | | | |
| T | 30 | | | | | | 29 | | | | | | | | | | | | | | | | | | |
| U | | | | | | | | | | | | | | | | | | | | | | | | | |
| V | | | | | | | | | | | | | | | | | | | | | | | | | |
| W | | | | | | | | | | | | | | | | | | | | | | | | | |
| X | 31 | | | | | | 32 | | | | | | | | | | | | | | | | | | |
| Y | | | | | | | | | | | | | | | | | | | | | | | | | |
| Z | | | | | | | | | | | | | | | | | | | | | | | | | |

PLYMOUTH TWP
ROCK COUNTY WI

IF AVAILABLE
ROCK COUNTY COORDINATES PREFERRED

North _____ Elev. _____

East _____

Hor. Datum _____ Vert. Datum _____

LATITUDE _____ ELLIPS. HT. _____


LONGITUDE _____

GPS (X) _____ TRAVERSE (X) _____

BASED ON THE FOLLOWING CONTROL:

PLACE MONUMENT SYMBOL \blacklozenge AT PROPER LOCATION ON ABOVE INDEX

\blacklozenge CORNER MONUMENT \circ WITNESS MONUMENT

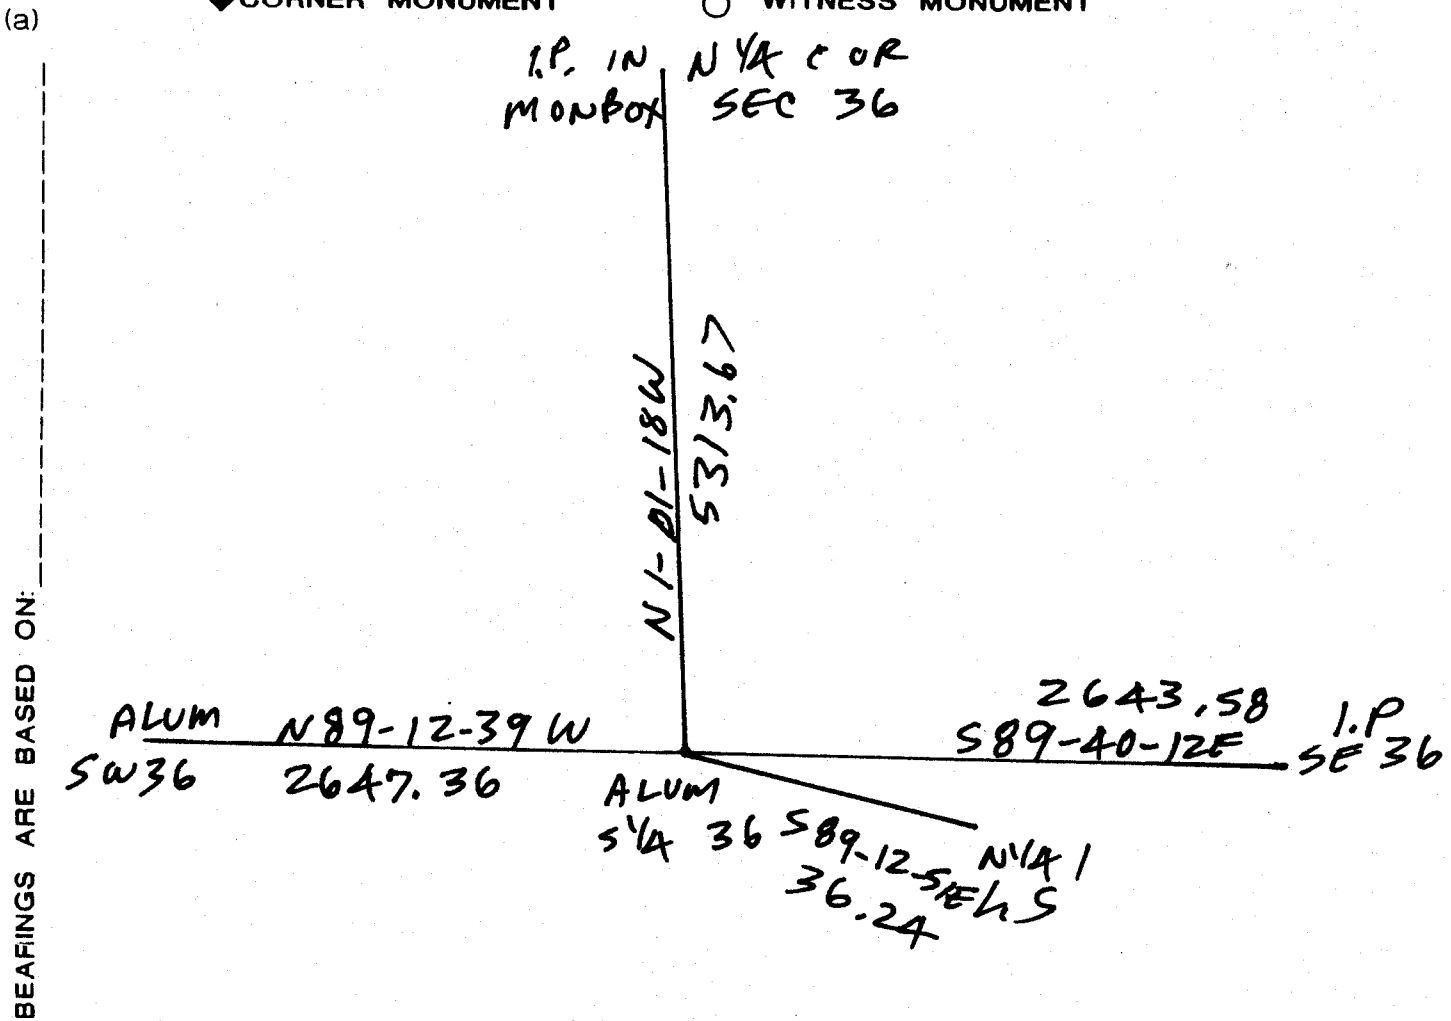

OBSERVATION SHEETS 340 & 4512

FIELD BOOK _____ PAGE # _____

SHEET 1 OF 1

SHOW A PLAN VIEW DRAWING DEPICTING THE CORNER MONUMENT AND SURROUNDING PHYSICAL FEATURES, INCLUDING THE EXCAVATION AREA AND DEPTH.

PLANNING & ZONING COMMITTEE ADOPTED THE ABOVE FORM ON 12/2/1982

CORNER CODE Z-23(1)

FL632

(B) Describe any record evidence, monument evidence, occupational evidence, testimonial evidence or any other material evidence you considered, and whether the monument was found or placed.

- 1833 MULLETT WEST ON SOUTH SIDE SECTION 36 VAR 7-00
2640 SET QUARTER SECTION POST WHITE OAK 10 N54E
20.46'; WHITE OAK 14 N15W 69.3;
4059 ENTER MARSH
5016 LEAVE MARSH
5280 SET POST CORNER SECTIONS 34 & 36 BLACK OAK 14
N9E 12.54'; WHITE OAK 8 N64 1/2W 67.98'. LAND
EXCEPT MARSH ROLLING SECOND RATE THINLY
TIMBERED WITH WHITE BLACK AND BUR OAK
- 1868 LOCKE PLYMOUTH REMONUMENTATION PG 8
WEST ON SOUTH BOUNDARY OF SEC 36. VAR 6-30
2645.45 INTERSECTED 1/4 LINE 22.44' SOUTH OF COR. FOUND
EAST BT AND STUMPS OF WEST BT AND OLD STAKE. COR
IN LINE WITH NORTH AND SOUTH FENCES AND 3 FT
NORTH OF FENCE RUNNING EAST ON SOUTH SIDE OF
HIGHWAY MONUMENT MARKED WITH FIGURES 36. VAR
CORRECTED 6 (PLACED CUT L.S.)
CONTINUED WEST FROM 1/4 COR WITH VAR 5-10
5295.34 INTERSECTED WEST BOUNDARY 5.28' NORTH OF COR.
FOUND BT IN SEC 35 AND WHERE BT IN 36 WAS DUG
OUT. {SW COR SEC 36}
5218.12 INTERSECTED WEST BOUNDARY OF SEC 1 TOWN 1N
FOUND BT IN SEC 2 AND OLD STAKE. COR FOR SEC 36
IN CENTER OF N AND S HIGHWAY AND ON SOUTH LINE
OF E AND W HIGHWAY VAR CORRECTED 5-17 {NW COR
SEC 1) AUG 19, 1868
- 1871 COLLINS REMONUMENTATION PG 147 NEWARK TWP T1N R11E
EAST ON NORTH LINE SEC 1 ON OFFSET
12.54' NORTH VARIATION 5-15
2584.56 OFFSET 33' SOUTH AND CONTINUED EAST WITH
VARIATION 6
5216.64 INTERSECT RANGE LINE 19.8' SOUTH OF CORNER
WEST CORRECTED BACK VARIATION 5-17
2608.32 SET 1/4 36.3' EAST OF PLYMOUTH 1/4 CORNER (PLACED
CUT L.S.)
CONTINUED WEST VARIATION 5-17
5216.64 SECTION CORNER OCT 18 1871
- 1961 BATTERMAN VOL 4 PG 63 STATES NOTHING ABOUT CORNER CALLS
FOR IT EASTERLY 36.3 OF THE S 1/4 COR SEC 36. AT THE S 1/4 COR
SEC 36 FD CUT STONE MON. & NOTE THAT @ S 1/4 COR SEC 36 G.
SHIMEALL FD CUT LIMESTONE BROKEN OFF. RESET 1" PIPE AT S 1/4
COR. SKETCH SHOWS THE S 1/4 COR. IS NEAR THE FENCE LINE INT. &
IS SE OF CURVE IN RD & S 1/4 COR. IS IN FARM ENTRANCE.
- 1979 COMBS CSM 8-491 SET PIN 36.24 WEST OF CUT L.S. @ N 1/4 COR
SEC 1 NEWARK TWP
- 2000 BARNES Z-23 FOUND CUT LIMESTONE @ N1/4 COR SEC 1. AT S 1/4
COR SEC 36 PLYMOUTH TWP DUG 1.5 WIDE, 2.5' LONG, & 1.5' DEEP
HOLE & FOUND NOTHING. DIGGERS HOTLINE LOCATED A N/S
UNDERGROUND ELECTRIC CABLE IN CLOSE VICINITY TO CORNER.
CUT LIMESTONE WAS PROBABLY DESTROYED. PLACE ALUM. MON.
WITH CARSONITE POST ON WEST SIDE AT RECORD DISTANCE FROM N
1/4 COR SEC 1 NEWARK TWP AND ON LINE WITH THE N 1/4 COR SEC 1
AND THE NW COR SEC 1. S 1/4 COR SEC 36 IS N89-12-50W 36.24'
FROM THE CUT L.S.

C) Was the corner restored through acceptance of (1) an obliterated evidence location, or, (2) a found perpetuated location?

ACCEPTED OBLITERATED EVIDENCE LOCATION.

I, Donald Barnes, hereby certify that the corner location as identified by the corner code index was determined by me under my direction and control and that this U.S. Public Land Survey Monument Record is correct and complete to the best of my knowledge and belief.

seal

amboss

Donald Barnes
6-17-03

SHEET 1 OF 1
CORNER CODE Z-23(1)