
U.S.

PUBLIC LAND SURVEY MONUMENT RECORD

For Public Land Survey Corners in: T. 2N., R. 1LE

WI ADMINISTRATIVE CODE A-E 7.08 REQUIREMENT

CORNER CODE INDEX

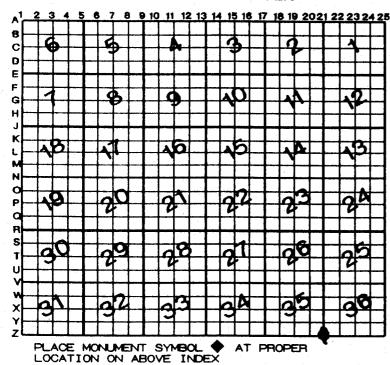

PLY	m	0	VT	H	T	WP
ROCI						

IF AVAILABLE ROCK COUNTY COORDINATES PERFERRED

North			Elev			
East	-					
Hor. 1	Datu	m	Vert. Dat	:um		
LATIT	UDE			_ELLIPS. HT		
LONG	וטדוו	E .				
GPS	(X)		TRAVERSE	: (x)		
BASED	ON	THE	FOLLOWING C	ONTROL:		

CORNER MONUMENT

WITNESS MONUMENT

BEAFINGS ARE BASED ON:

(a)

OBSERVATION	SHEETS	330,3	39
	the state of the s		

					, · · · · · · · · · · · · · · · · · · ·	. 2
FIELD	ВООК	PAGE #			SHEET	OF <u>></u>
SHOW	A PLAN VIEW	DRAWING DEPICTING	THE CORNER	MONUMENT AN	D SURROUNDING	
PHYSIC	AL FEATURES,	INCLUDING THE EXC	AVATION AREA	A AND DEPTH.		
PLANNIN	G & ZONING COM	MITTEE ADOPTED THE AL	BOVE FORM ON	12/2/1982		

PL631

(B)Describe any record evidence, monument evidence, occupational evidence, testimonial evidence or any other material evidence you considered, and whether the monument was found or placed.

1833 MULLETT WEST ON SOUTH SIDE SECTION 36 VAR 7-00

2640 SET QUARTER SECTION POST WHITE DAK 10 N54E 20.46'; WHITE DAK 14 N15W 69.3;

4059 ENTER MARSH

5016 LEAVE MARSH

5280 SET POST CORNER SECTIONS 34 & 36 BLACK OAK 14 N9E 12.54'; WHITE OAK 8 N64 1/2W 67.98'. LAND EXCEPT MARSH ROLLING SECOND RATE THINLY TIMBERED WITH WHITE BLACK AND BUR OAK SEPT.

WEST ON SOUTH SIDE SECTION 35

1387.32 WHITE DAK 10 IN DIAMETER

2640 SET QUARTER SECTION POST WHITE DAK 18 N69E 14.52'; WHITE DAK ``14 N78W 23.76'

5280 SET POST CORNER SECTION 34 & 35 WHITE OAK 20 N62E 33'; WHITE OAK 3 N62W 24.42'

1833 HARRISON NORTH BETWEEN 35 & 36 VAR 8-DDE DEC 20TH

462 LEFT TIMBERING ENTER MARSH

990 LEAVE MARSH & ENTER TIMBER

2640 QUARTER SEC COR. BURR OAK 22 N87W 73.26'; BUR \
OAK 8 S31E 30.36'; BURR OAK 22 & BURR O 8 MARKED.

3630 LEFT TIMBER & ENTER PRAIRIE

4854.96 LEFT PRAIRIE & ENTER TIMBER

4884 BLACK DAK 12 5214 BLACK DAK 12

5280 COR TO SECS 26,25,35,36 RED OAK 24 N69E 25.08'; WHITE OAK 24 N 10W 38.94'; RED OAK 16 S9W 38.28'; RED OAK 14 S46E 75.9'; LAND 8? 2ND RATE. TIMBER

BURR RED & WHITE DAK DEC 20TH

1834 MILLER NORTH BETWEEN SECS 1 & 2

1518 BLACK WALNUT 14 IN DIA

2191.2 YEL. DAK 46 IN DIA

2640 SET 1/4 SEC POST BLACK WALNUT B N34E 19.8'

HICKORY 8 S77W 13.2'

2970 YEL. DAK. 14 IN DIA

4191 BROOK E 1.32' WIDE

4655.64 BUR OAK 12

5377.02 INTERSECTED NORTH BOUNDARY 77.22' EAST OF POST WO 12 S28W 9.24', YEL. 22 S75E 26.4' LAND SOUTH HALF FIRST RATE NORTH HALF 2ND RATE MARCH 8 1834

1849 MC VANE TOWN ROAD RECORDS BK 1 PG 26 """ THE WIDTH OF 49.5' AND SAID COMMISSIONERS HAVE CAUSED A SURVEY THERE OF TO BE MADE AS FOLLOWS; THE CENTER LINE OF SAID HWY IS TO COMMENCE AT THE NW COR OF SEC 25; THENCE RUNNING SOUTH ON THE SOUTH ON THE SECTION (2)6 TO THE SW COR OF SAID SEC 25; THENCE SOUTH ON THE SEC LINE BETWEEN SEC 35 AND SEC 36 TERMINATING ON THE SOUTH LINE OF SAID TOWN THE CENTER OF HWY TO BE ON THE SEC LINE.

1868 LOCKE PLYMOUTH TWP REMONUMENTATION PG 9

NORTH BETWEEN SEC 35 & 36 VAR 7-10 AUG 19[™]1868

2658.48 INTERSECTED 1/4 LINE AT COR. FOUND B.T. IN SEC 35 (CUT DOWN BUT NOT REMOVED) AND REMAINS OF STAKE COR IN CENTER OF HIGHWAY AND 1.98' SOUTH OF FENCE RUNNING WEST. CONTINUED

NORTH FROM 1/4 COR WITH VAR 7-15

5318.28 INTERSECTED NORTH BOUNDARY 6.6' WEST OF COR.
VAR CORRECTED 7-07

EAST ON SOUTH LINE OF SEC 35 VAR 5-30 PG 15

330 SET OFF 15.18' NORTH

1716 SET OFF 6.27' NORTH

1452 SET OFF 4.29' NORTH

848 SET OFF 46.86' NORTH

SHEET 1 OF 3 CORNER CODE Z-21(1)

3-07-03

2696.1	INTERSECTED 1/4 LINE 52.8' NORTH OF COR. FOUND
	STUMP OF EAST BT AND WHERE WEST BT WAS DUG
	OUT AND OLD STAKE. COR 3 FT WEST OF N & S FENCE
	VAR CORRECTED 5-56 AUG 20, 1868

CONTINUED EAST FROM 1/4 COR WITH VAR 5-56

5346 INTERSECTED EAST BOUNDARY 3.63' SOUTH OF COR. VAR CORRECTED 5-55 1/4 MONUMENT MARKED WITH FIGURE 35 ON NORTH FACE

WEST ON SOUTH BOUNDARY OF SEC 36. VAR 6-30 PG 8

INTERSECTED 1/4 LINE 22.44' SOUTH OF COR. FOUND EAST BT AND STUMPS OF WEST BT AND OLD STAKE. COR IN LINE WITH NORTH AND SOUTH FENCES AND 3 FT NORTH OF FENCE RUNNING EAST ON SOUTH SIDE OF HIGHWAY MONUMENT MARKED WITH FIGURES 36. VAR CORRECTED 6

CONTINUED WEST FROM 1/4 COR WITH VAR 5-10

- INTERSECTED WEST BOUNDARY 5.28' NORTH OF COR. 5295.34 FOUND BT IN SEC 35 AND WHERE BT IN 36 WAS DUG OUT. {SW COR SEC 36}
- 5218.12 INTERSECTED WEST BOUNDARY OF SEC 1 TOWN 1N FOUND BT IN SEC 2 AND OLD STAKE. COR FOR SEC 36 IN CENTER OF N AND S HIGHWAY AND ON SOUTH LINE OF E AND W HIGHWAY. (NW COR SEC 1) VAR CORRECTED 5-17 AUG 19, 1868
- 1871 COLLINS REMONUMENTATION NEWARK TWP TIN R11E NORTH BETWEEN 1 & 2 VARIATION 4-45 PG 146
 - SET 1/4 STONE BY ROOTS- OF WITNESS TREES. 2640 AGREEING WITH LINE TREE NORTH. CONTINUED NORTH SAME VARIATION

4191 BROOK

- 5359.2 SET CORNER FOR 1 & 2 BY WITNESS TREES FROM WHICH STONE AT CORNER OF 35 & 36 T2 R11 IS 880W 77.22' EAST ON NORTH LINE SEC 1 ON OFFSET 12.54' NORTH VARIATION 5-15 PG 147
- OFFSET 33' SOUTH AND CONTINUED EAST WITH 2584.56 VARIATION 6
- 5216.64 INTERSECT RANGE LINE 19.8' SOUTH OF CORNER WEST CORRECTED BACK VAR 5-17
- 2608.32 SET 1/4 36.3' EAST OF PLYMOUTH 1/4 COR CONTINUED WEST VARIATION 5-17
- 5216.64 SECTION CORNER OCT 18 1871 EAST ON NORTH LINE OF 2 VARIATION 6-15

5454.24 SEC. CORNER BACK TO PG 160

- SET 1/4 STONE 1.98' EAST OF PLYMOUTH CORNER OCT 2727.12 211871
- 1967 SHIMEALL MAP #4442 PIPE OVER STONE @ SW SEC 36 PLYMOUTH TWP & PIN AT NW COR SEC 1 NEWARK TWP. 77.2' BETWEEN PIN & PIPE

1975 COMBS CSM5-100 PIPE IN MON. BOX

- 1983 WIDOT #7025 1" IRON PIN 214291.35; 2,229,261.74
- 1984 BARNES VOL 6 PG 314 WIDOT PROJ 5571-01-21 1" PIN 214,291.35; 2,229,261.74. N89-17-16E 77.20 TO 1' PIN AT NE COR SEC 2 NEWARK TWP 214,292.31; 2,229,338.93
- 1996 COMBS CSM 19-206 FD IRON PIPE OVER STONE (PER CLAYTON SHIMEALL SURVEY DATED DEC 1967) MON. BOX IS 2.9' SOUTH.
- 2001 BARNES Z-21 FD 3.8" PIN @ NW COR SEC 1 & PIPE IN MON. BOX NEAR SW COR SEC 36 & PIPE OVER CUT LIMESTONE, N9-04-36W

SHEET 2 OF 3 CORNER CODE \mathbb{Z} -21(1)

PL631

7.25 FROM FD $\frac{1}{2}$ " PIN @ NW COR SEC 1 NEWARK TWP. SET ALUM MON ON TOP OF L.S. L.S. IS N5-06-10E 2.95' OF PIPE IN MON. BOX

FD ALUM. MON & TIES.

C) Was the corner restored through acceptance of (1) an obliterated evidence location, or, (2) a found perpetuated location?

ACCEPTED FOUND ALUM OVER CUT LIMESTONE. DID NOT ACCEPT FOUND PIPE IN MON. BOX.

D) Describe any material discrepancy between the location of the corner as restored or reestablished and the location of that corner as previously restored or reestablished by distance and direction. Show the discrepancy on the plan view drawing under (a), above. Show the distances between the corner as previously restored or reestablished and (1) the corner as restored or reestablished, and (2) to at least 4 of the witness monuments shown on the drawing in (a), above.

THE PIPE IN THE MON BOX IS NOT THE ONE SHIMEALL PLACED OVER THE STONE. THE CUT L.S. (ALUM. MON.) IS N5-06-10W 2.95' NORTH OF THE PIPE IN THE MON. BOX.

I, **Donald Barnes**, hereby certify that the corner location as identified by the corner code index was determined by me under my direction and control and that this U.S. Public Land Survey Monument Record is correct and complete to the best of my knowledge and belief.

0.6%)

3/07/03

SHEET 3 OF 3

CORNER CODE Z-21(1)

A-E 7.08 REQUIREMENT