

U.S. PUBLIC LAND SURVEY MONUMENT RECORD

For Public Land Survey Corners in:

WI ADMINISTRATIVE CODE A-E 7.08 REQUIREMENT

T. 1N., R. 14E

CORNER CODE INDEX

A	1	2	3	4	5	6	7	8	9	10	11	12	13	14	15	16	17	18	19	20	21	22	23	24	25
B																									
C	6																								
D																									
E																									
F																									
G	7																								
H																									
I																									
J																									
K	18																								
L																									
M																									
N																									
O																									
P	19																								
Q																									
R																									
S																									
T	30																								
U																									
V																									
W																									
X	31																								
Y																									
Z																									

CLINTON TWP

ROCK COUNTY WI

IF AVAILABLE
ROCK COUNTY COORDINATES PREFERRED

North _____ Elev. _____

East _____

Hor. Datum _____ Vert. Datum _____

LATITUDE _____ ELLIPS. HT. _____

LONGITUDE _____


GPS (X) _____ TRAVERSE (X) _____

BASED ON THE FOLLOWING CONTROL:

PLACE MONUMENT SYMBOL AT PROPER LOCATION ON ABOVE INDEX

CORNER MONUMENT WITNESS MONUMENT

(a)

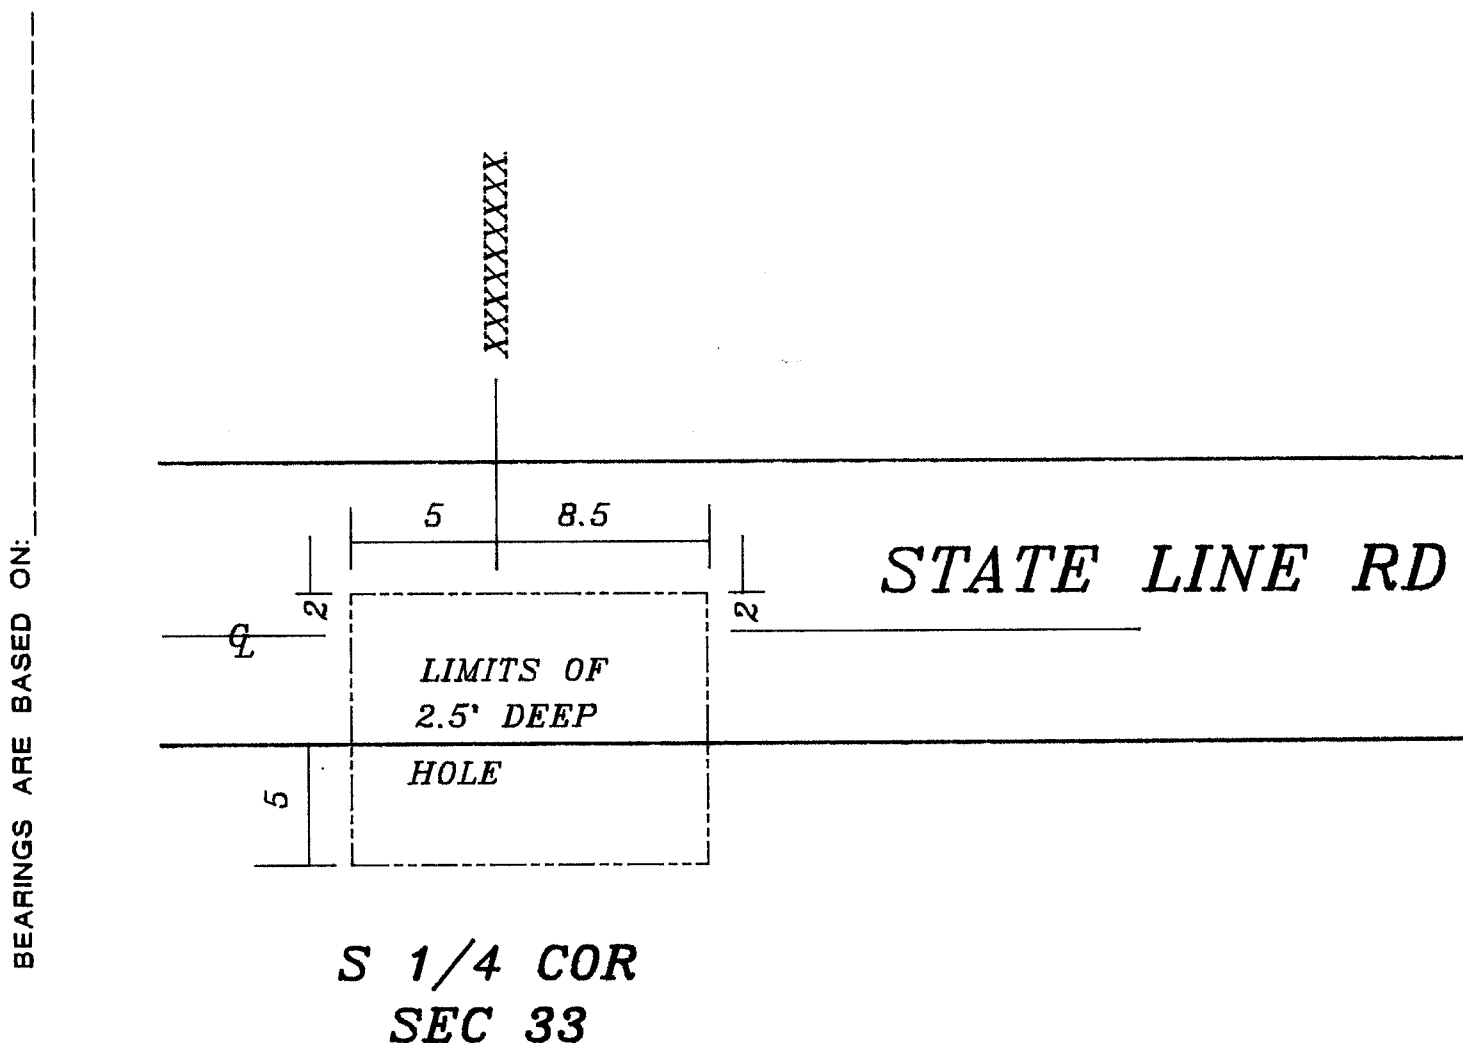

FIELD BOOK _____ PAGE # _____

SHEET _____ OF _____

SHOW A PLAN VIEW DRAWING DEPICTING THE CORNER MONUMENT AND SURROUNDING PHYSICAL FEATURES, INCLUDING THE EXCAVATION AREA AND DEPTH.

PLANNING & ZONING COMMITTEE ADOPTED THE ABOVE FORM ON 12/2/1982

CORNER CODE 211(2)

CL626 S 1/4 COR SEC 33 T1N R14E

(B) Describe any record evidence, monument evidence, occupational evidence, testimonial evidence or any other material evidence you considered, and whether the monument was found or placed.

1833 LYON EAST ALONG THE SOUTH LINE OF SEC 33

2640 SET POST FOR 1/4 SECTION CORNER

BLACK OAK 5 N71 1/2W 30

BUR OAK 16 N41 1/2E 276

5280 HAVING PASSED OVER A WET GLADE, SET A POST FOR CORNER TO SECS #33 & 34. BUR OAK 20 N65W 37, BUR OAK 15 N72E 200. LAND ROLLING AND THICKLY TIMBERED WITH BUR OAK, EXCEPT IN THE GLADES.

1838 DEC 24 SPAULDING FIELD NOTES PG 834 NORTH BETWEEN SECTIONS 1 & 2 TOWNSHIP 46 NORTH RANGE 3 EAST OF THE 3RD PRINCIPAL MERIDIANS. CHAIN

28.72 INTERSECTED THE NORTH BOUNDARY OF THE STATE OF ILLINOIS 18.90 CHAINS WEST OF THE CORNER TO SECTIONS 33 & 34 TOWNSHIP ONE NORTH RANGE 14 EAST OF THE 4TH PRINCIPAL MERIDIANS IN THE WISCONSIN TERRITORY AND AT SAID INTERSECTION SET A POST FOR CORNER TO SECTIONS 1 & 2 TOWNSHIP 46 NORTH RANGE 3 EAST FROM WHICH A BURR OAK 14" DIAMETER BEARS S49W 68 LINKS AND A BURR OAK 12 INCHES DIAMETER BEARS S5E 710 LINKS DISTANT.

1848 TERRITORIAL ROAD RECORDS. SHEET 1 PG 66 & SHEET 2 PG 67. JOHN McKEY, ROBBINS, WHITE WERE COMMISSIONERS APPOINTED BY THE LEGISLATURE. E.G. WHEELER, SURVEYOR SIGNED THE FOLLOWING CERTIFICATE: NOTE: AS WILL BE SEEN BY THE MINUTES OF THE CENTER LINE OF THE ROAD STRIKES THE EAST LINE OF ROCK COUNTY, 50 LINKS (33') NORTH FROM THE STATE LINE & CONTINUES PARALLEL TO THE STATE LINE UNTIL IT STRIKES THE EAST LINE OF SEC 36 T1N R12E. IT THEN ANGLES TO THE NORTH WEST MAKING 3 SMALL ANGLES TO THE TERMINUS(?). STAKES ARE SET IN THE CENTER LINE. THEY ARE MARKED & NUMBERED & ARE WITNESSED WHERE EVER LINE COULD BE FOUND CONVENIENT. E.G. WHEELER SURVEYOR.

1993 FIDIS Z11. SET 5/8" REBAR. THE CORNER WAS REESTABLISHED BY SINGLE PROPORTIONATE BETWEEN TWO FOUND ALUMINUM MONUMENTS. SKETCH CALLS FOR AN ALUMINUM MONUMENT AT THE S 1/4 COR OF SEC 32 AND THE SE CORNER OF SECTION 33.

FOUND REBAR AND TIES AS SHOWN. DID NOT FIND ANY MARKINGS IN THE ASPHALT THAT INDICATES THAT THE MONUMENT WAS EVER EXCAVATED FOR. DUG & FOUND NOTHING. SOIL INDICATES AREA MAY HAVE BEEN CUT FOR ROAD CONSTRUCTION. TELEPHONE CABLE MARKING ON PAVEMENT IS 2' WEST OF N/S FENCE.


C) Was the corner restored through acceptance of (1) an obliterated evidence location, or, (2) a found perpetuated location?

WISCONSIN ADOPTED THE "MANUAL OF INSTRUCTIONS FOR THE SURVEY OF THE PUBLIC LANDS OF THE UNITED STATES" (1973). SEE WI STATUTES 59.62. THE MANUAL, SECTION 5-19, REQUIRES AN ORDER OF THE UNITED STATES SUPREME COURT OR AUTHORIZATION OF THE ADJOINING STATES PLUS CONGRESSIONAL APPROVAL TO REPLACE A LOST STATE BOUNDARY MONUMENT. SINCE AUTHORIZATION MUST BE SECURED BEFORE A LOST STATE BOUNDARY MARKER CAN BE RESET, I DO NOT ACCEPT THIS MONUMENT BUT ONLY PERPETUATE ITS' LOCATION. ED GARVEY DEPUTY ATTORNEY GENERAL FOR THE WISCONSIN DEPARTMENT OF JUSTICE ATTORNEY GENERAL'S OFFICE WROTE AN OPINION DATED OCTOBER 18, 1983. THE OPINION SUPPORTS THE AUTHORIZATION PROCEDURE.

E) Was the corner reestablished through lost corner proportionate methods? If so, show the method, including the directions and distances to other public land survey corners used as evidence or used for proportioning the corner location.

YES, FIDIS DECLARED THE CORNER LOST.

I, Donald Barnes, hereby certify that the corner location as identified by the corner code index was determined by me under by direction and control and that this U.S. Public Land Survey Monument Record is correct and complete to the best of my knowledge and belief.

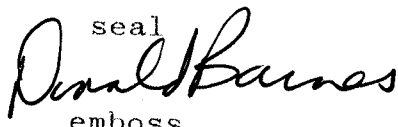seal


emboss
JUNE 18, 1997

Number of included sheets 1

CORNER CODE Z-11(1)

A-E 7.08 REQUIREMENT