

U.S. PUBLIC LAND SURVEY MONUMENT RECORD


For Public Land Survey Corners in the
T. 2 N., R. 11 E.

CORNER CODE INDEX

	1	2	3	4	5	6	7	8	9	10	11	12	13	14	15	16	17	18	19	20	21	22	23	24	25	
A																										
B																										
C	6																									
D		5																								
E			4																							
F				3																						
G					2																					
H																										
I																										
J																										
K																										
L																										
M																										
N																										
O																										
P																										
Q																										
R																										
S																										
T																										
U																										
V																										
W																										
X																										
Y																										
Z																										

PLACE MONUMENT SYMBOL (◆) AT PROPER LOCATION ON ABOVE INDEX

EXAMPLE

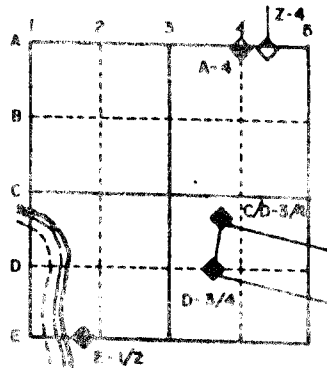

PLYMOUTH TWP
ROCK COUNTY WI

IF AVAILABLE
STATE PLANE COORDINATES

North (Y) _____ Eleve. (Z) _____
East (X) _____ Zone _____
Hor. Datum _____ Vert. Datum _____

(a.)

◆ CORNER MONUMENT

○ WITNESS MONUMENT

BEARINGS ARE BASED ON:

10PZ

MICROFILMED

FIELD BOOK _____ PAGE # _____

SHOW A PLAN VIEW DRAWING DEPICTING THE CORNER MONUMENT AND SURROUNDING PHYSICAL FEATURES, INCLUDING THE EXCAVATION AREA AND DEPTH. THE CORNER MONUMENT SHALL HAVE THE FOLLOWING CHARACTERISTICS: 1) HAVE AT LEAST TWO PREDETERMINED BREAK-OFF POINTS. 2) IF BROKEN, LEAVE A PERMANENTLY MAGNETIZED REMNANT AT THE ORIGINAL POINT. 3) MUST BE EXTENDABLE. 4) THE CAP IS INSCRIBED: ROCK COUNTY SURVEY MONUMENT - PENALTY FOR DISTURBING MARKER. 5) OR AN EXISTING CUT LIMESTONE. AN IRON PIPE 1 1/2" x 4'0" (MINIMUM) MAY BE USED IN AREAS WHERE GROUND WATER IS WITHIN ONE FOOT OF THE SURFACE. IF THE CORNER IS OCCUPIED BY AN IMPROVEMENT (MANHOLE, BURIED CABLE, ETC.) ANY DURABLE, DISTINCT MONUMENT MAY BE USED. CORNERS SHALL BE REFERENCED WITH AT LEAST 4 DURABLE WITNESS MONUMENTS. WITNESS MONUMENTS SHALL BE MADE OF CONCRETE, NATURAL STONE, IRON OR OTHER EQUALLY DURABLE MATERIAL, EXCEPT WOOD. DESCRIBE THE CORNER AND THE WITNESS MONUMENTS.

CORNER CODE:

A 23(2)

(B) Describe any record evidence. monument evidence, occupational evidence, testimonial evidence, other material evidence considered, and whether the monument was found or placed.

- 1866 LOCKE REMONUMENTATION FIELD NOTES. CORNER IS 1.32' EAST OF THE SOUTH QUARTER CORNER OF SECTION 36. PLACED CUT LIMESTONE. AT THE SOUTH QUARTER CORNER OF SECTION 36, FOUND LARGE LIMESTONE IN CENTER OF HIGHWAY AND IN LINE OF N AND S FENCES.
- 1933 SUNNY VOL 3 PG 234 SET 1" X 36" PIPE IN CONCRETE PAVEMENT. 1.4' NORTH OF CENTER OF CONCRETE PAVEMENT IN LINE WITH S. FENCE. SHOWS A DISTANCE OF 2644.7 TO THE FENCE INTERSECTION AT THE CENTER OF SECTION 1. SHOWS THE MONUMENT 1.32' EAST OF THE SOUTH QUARTER CORNER OF SECTION 36.
- 1970 BATTERMAN JR. VOL 4 PG 298 SHOWS A 3/4 " PIN WITH REFERENCE MONUMENTS. DOES NOT STATE ANYTHING ABOUT THE CORNER.
- 1988 BARNES A 23 FOUND 3/4" REROD AND 4" DEEP FOUND PIPE IN CONCRETE PAVEMENT. 5'3" DEEP FOUND CUT LIMESTONE. BROKE TOP 25" OF STONE. MEASURED TO BOTTOM AND THEN PUT TOP BACK ON. PLACED BENT PIPE HORIZONTALLY BY THE STONE. FOUND 15" X 6" 2 1/2" LIMESTONE 1.26 TO THE WEST. STONE IS 1.82 SOUTH OF THE PIPE. STONE IS AT THE CENTER OF THE PAVEMENT. IT APPEARS FROM THE EXCAVATION THAT SUNNY NEVER DUG FOR THE CORNER. ACCEPTED FOUND CUT LIMESTONE.

FOUND DISK AT THE S 1/4 CORNER OF SECTION 36 BUT NOTHING AT THE N 1/4 CORNER OF SECTION 1.

C) Was the corner restored through acceptance of (1) an obliterated evidence location, or, (2) a found perpetuated location?

D) Describe any material discrepancy between the location of the corner as restored or reestablished and the location of that corner as previously restored or reestablished by distance and direction. Show the discrepancy on the plan view drawing under (a), above. Show the distances between the corner as previously restored or reestablished and (1) the corner as restored or reestablished, and (2) to at least 4 of the witness monuments shown on the drawing in (a), above.

(E) Was the corner reestablished through lost corner proportionate methods? If so, show the method, including the directions and distances to other public land survey corners used as evidence or used for proportioning the corner location.

I, Donald Barnes, hereby certify that the corner points as identified by the corner code index were, in a field survey on, November 9, 1992, established, re-established, monumented, re-monumented, recovered or restored as expressed below and in conformance with the regulations and rules as required in the current manual of survey instructions of the United States Department of Interior, Bureau of Land Management.

seal
Donald Barnes
 11/30/92

COUNTY SURVEYOR FILING DATA

Date of computer entry _____

Date microfilmed _____

Number of included sheets _____
CORNER CODE

AFFIX YOUR LAND SURVEYOR SEAL

A 23(2)

Donald Barnes
11/30/92

