

U.S. PUBLIC LAND SURVEY MONUMENT RECORD

For Public Land Survey Corners in:

WI ADMINISTRATIVE CODE A-E 7.08 REQUIREMENT

T. 2 N., R. 11 E

CORNER CODE INDEX

A	2	3	4	5	6	7	8	9	10	11	12	13	14	15	16	17	18	19	20	21	22	23	24	25
B	6																							
C		5																						
D																								
E																								
F																								
G	1	8																						
H																								
I																								
J																								
K																								
L	18	11																						
M																								
N																								
O																								
P	19	20																						
Q																								
R																								
S																								
T	30	29																						
U																								
V																								
W																								
X	31	32																						
Y																								
Z																								

PLYMOUTH TWP
ROCK COUNTY WI

IF AVAILABLE
ROCK COUNTY COORDINATES PREFERRED

North _____ Elev. _____

East _____

Hor. Datum _____ Vert. Datum _____

LATITUDE _____ ELLIPS. HT. _____

LONGITUDE _____

GPS (X) _____ TRAVERSE (X) _____

BASED ON THE FOLLOWING CONTROL:

PLACE MONUMENT SYMBOL AT PROPER LOCATION ON ABOVE INDEX

CORNER MONUMENT WITNESS MONUMENT

BEARINGS ARE BASED ON:

FIELD BOOK _____ PAGE # _____

SHEET 1 OF 3

SHOW A PLAN VIEW DRAWING DEPICTING THE CORNER MONUMENT AND SURROUNDING PHYSICAL FEATURES, INCLUDING THE EXCAVATION AREA AND DEPTH.

PLANNING & ZONING COMMITTEE ADOPTED THE ABOVE FORM ON 12/2/1982

CORNER CODE V-902

PL605

(B) Describe any record evidence, monument evidence, occupational evidence, testimonial evidence or any other material evidence you considered, and whether the monument was found or placed.

- 1855 CHURCH VOL 1 PG 38 COMPASS N & S. 2664.75 TO S 1/4 COR SEC 28 & 2658.98 TO W 1/4 COR SEC 28. STONE 24" LONG 8" WIDE 4" THICK. SCHOOL HOUSE S6 1/2E 157.74', SE CORNER OF JAKE FISHER'S HOUSE N47 3/4W 99.66'
- 1868 LOCKE REMONUMENTATION NOTES. PG 18 WEST BETWEEN SECS 28 AND 33 VAR 6
- 2.17 BROOK BRIDGE 10 LKS WIDE
- 40.47 INTERSECTED 1/4 LINE AT STONE SET BY CHURCH CENTER OF ROAD. (SEE CO. SURVEYOR RECORD SEC 28) CONTINUED WEST WITH VAR 6-10
- 54.10 CENTER SLUICE BRIDGE 5 LKS WIDE
- 80.94 INTERSECTED WEST BOUNDARY AT STONE SET BY CHURCH (SEE CO. SURVEYORS RECORD) JAKE FISHER T IMYLIE AND SEVERAL OTHER NEIGHBORS UNITE IN DECLARING THAT THE OLD CORNERS IN SEC 28 HAD BEEN KEPT UP & THAT THESE STONES SET BY CHURCH WERE SET WHERE THE OLD CORNERS WERE. COR 22.77' SOUTH AND 1.32' EAST OF CORNER OF J. FISHERS FENCES ON NORTH & WEST SIDES OF HIGHWAYS.
- NORTH BETWEEN SECS 28 AND 29 VAR 7-30 PG 19
- SET OFF 35 1/2 LKS EAST
- 40.42 1/2 INTERSECTED 1/4 LINE 34 1/2 LKS EAST OF COR. FOUND STONE SET BY CHURCH (SEE PAGE 18) ALSO CO. SURVEYORS RECORD SEC 28) COR IN CENTER OF HIGHWAY RUNNING NORTH & ON WEST LINE OF HIGHWAY RUNNING SOUTH AND IN LINE WITH FENCES RUNNING E & W. VAR CORRECTED 7-29
- CONTINUED NORTH WITH VAR 7-15
- 80.26 INTERSECTED NORTH BOUNDARY 1 LK WEST OF COR. FOUND STONE SET BY CHURCH. (SEE CO. SURVEYORS RECORD SEC 28 ALSO PAGE 18 HEREOF) VAR CORRECTED 7-14.
- WEST BETWEEN SEC 29 AND 32 VAR 6-05 PG 61
- 40.30 INTERSECTED 1/4 LINE 7 LKS SOUTH OF COR. FOUND REMAINS OF NORTH BT AND LIMESTONE ABOVE OLD STAKE IN CENTER OF HIGHWAY AND IN LINE OF FENCE RUNNING NORTH VAR CORRECTED 6. CONTINUED WEST FROM 1/4 COR WITH VAR 6
- 44.00 SET OFF 12 LKS NORTH
- 51.20 CENTER OF SLUICE BRIDGE
- 61.00 SET OFF 9 1/2 NORTH
- 76.00 SET OFF 13 LKS NORTH
- 80.53 INTERSECTED WEST BOUNDARY AT COR. FOUND B.T.S IN SEC 31 AND 32 AND STUMP OF BT IN 29 AND STONE ON COR. COR IN CENTER OF HIGHWAY. VAR CORRECTED 5-30
- SOUTH BETWEEN SEC 32 & 33 VAR 7-15 PG 68
- 0.00 SET OFF 16 1/2 EAST
- 40.32 INTERSECTED 1/4 LINE 16 1/2 LKS EAST OF COR., FOUND MOUND AT JUNCTION OF FENCES ON WEST SIDE OF HIGHWAY AND ON LINE OF E & W FENCES. VAR CORRECTED 7-15. CONTINUED SOUTH FROM 1/4 COR WITH VAR 7-15.
- 80.615 INTERSECTED SOUTH BOUNDARY 6 LKS EAST OF COR. FOUND LARGE LIMESTONE ON COR & UNDERNEATH INDICATIONS OF STAKE. COR IN CENTER OF E & W HIGHWAY AND NEARLY ON LINE OF FENCES ON WEST SIDE OF HIGHWAY RUNNING NORTH. VAR CORRECTED 7-10.
- 1871 RUGER VOL 2 PG 75 STONE MON 2655.84 TO W 1/4 COR SEC 33, 2667.22 TO N 1/4 COR SEC 33
- 1875 RUGER VOL 2 PG 193 CALLS FOR STONE MON.
- 1978 BARNES VOL 5 PG 473 N88-43-35W 2659.80 TO N 1/4 COR SEC 32, S88-56-51E 2670.13 TO N 1/4 COR SEC 33, S0-04-49W 2662.40 TO W 1/4 COR SEC 33, & N0-09-37E 2672.16 TO E 1/4 COR SEC 29.
- 1978 BARNES VOL 5 PG 482 SET ALUM MON & REFERENCED SAME.
- 1979 BARNES VOL 6 PG 372 DUG 4X4X7' DEEP HOLE 2' DEEP FOUND CONCRETE ROAD, 4 DEEP FOUND STONE ROAD BED, 6' DEEP FOUND 1X1X3 WOOD HUB.
- 1984 DOT V-11 DOT REFERENCED CORNER

WIDOT NOTIFIED ME THAT STH 213 WILL BE RESURFACED AND THE PROJECT WILL START IN APRIL. FOUND PK. NEED TO BORE WITH SIGN TRUCK TO FIND ALUM. MON.

V 9 (2)

C) Was the corner restored through acceptance of (1) an obliterated evidence location, or, (2) a found perpetuated location?
DID NOT RESTORE LOCATION.

D) Describe any material discrepancy between the location of the corner as restored or reestablished and the location of that corner as previously restored or reestablished by distance and direction. Show the discrepancy on the plan view drawing under (a), above. Show the distances between the corner as previously restored or reestablished and (1) the corner as restored or reestablished, and (2) to at least 4 of the witness monuments shown on the drawing in (a), above.

(E) Was the corner reestablished through lost corner proportionate methods? If so, show the method, including the directions and distances to other public land survey corners used as evidence or used for proportioning the corner location.

I, Donald Barnes, hereby certify that the corner location as identified by the corner code index was determined by me under my direction and control and that this U.S. Public Land Survey Monument Record is correct and complete to the best of my knowledge and belief.

seal

Donald Barnes

Number of included sheets _____



emboss

April 22, 1998

A-E 7.08 REQUIREMENT

CORNER CODE

V-9(2)

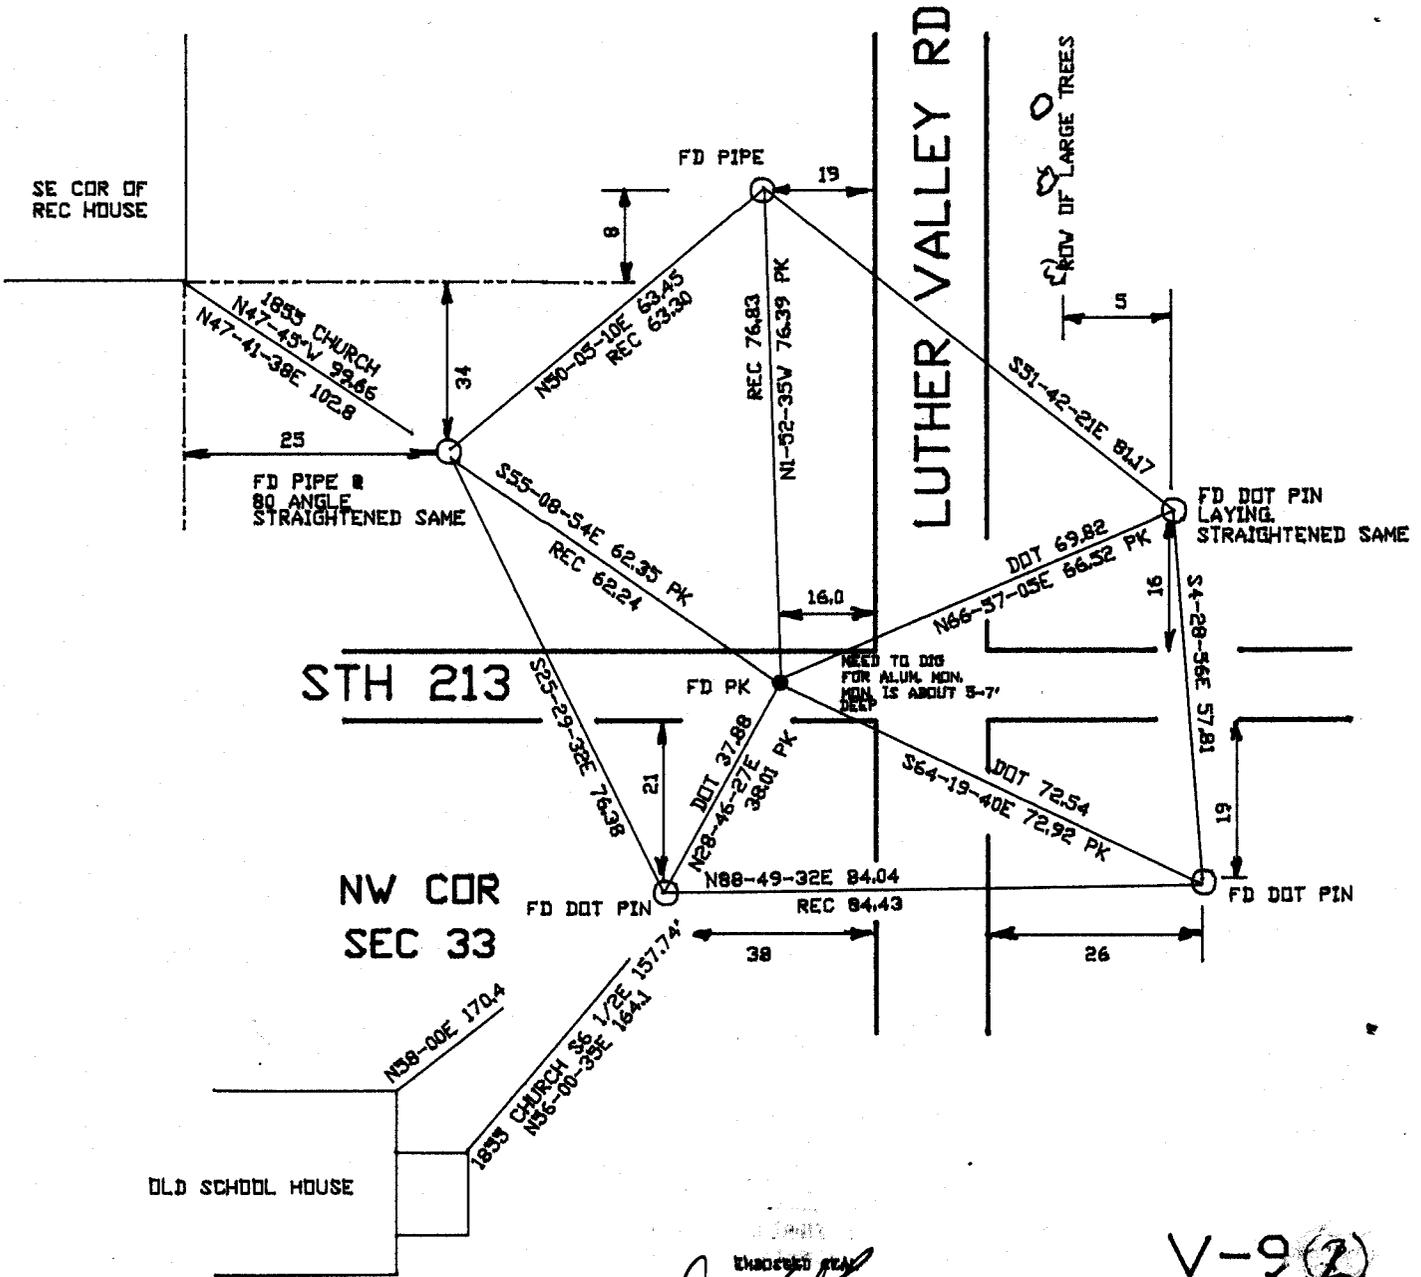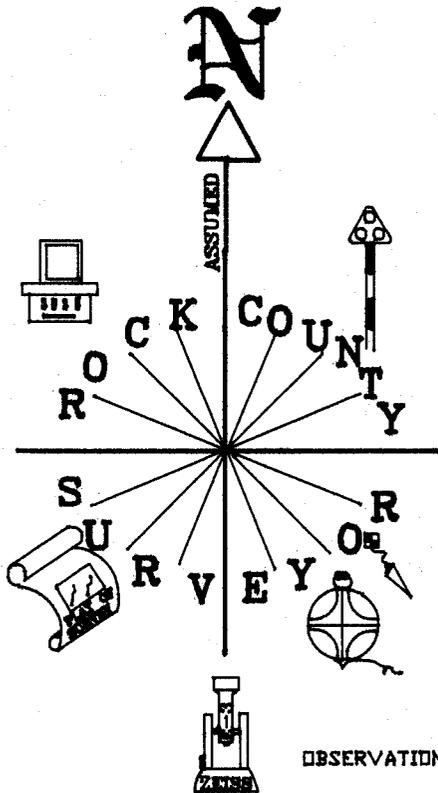

Donald Barnes
April 22 1998

V-9(2)