Paper weight-110# (minimum)

Black nonfading ink required

LAND U.S. **PUBLIC** SURVEY **MONUMENT RECORD**

CORNER CODE INDEX A 1 2 3 4 5 6 7 8 9 10 11 12 13 14 15 16 17 18 19 20 21 22 23 24 2	TORTER TWP
A B C D D D D D D D D D D D D D D D D D D	ROCK COUNTY WI C D IF AVAILABLE E ROCK COUNTY COORDINATES PERFERRED F
H J K K	G H North Elev K East
M N O P Q R	L Date Vert. Datum Vert. Datum OP LATITUDE ELLIPS. HT
X Y Z	S LONGITUDE T V NAD83(91)NETWORK ADJ. YR W GPS (X) TRAVERSE (X) Y BASED ON THE FOLLOWING CONTROL:
1 2 3 4 5 6 7 8 9 10 11 12 13 14 15 16 17 18 19 20 21 22 23 24 29 PLACE MONUMENT SYMBOL AT PROPER LOCATION ON ABOVE INDEX CORNER MONUMENT (a)	WITNESS MONUMENT

FIELD BOOK _____ PAGE # ____ SHEET ____ SHOW A PLAN VIEW DRAWING DEPICTING THE CORNER MONUMENT AND SURROUNDING FIELD BOOK PHYSICAL FEATURES, INCLUDING THE EXCAVATION AREA AND DEPTH. PLANNING & ZONING COMMITTEE ADOPTED THIS FORM ON 12/2/1982

BEARINGS ARE BASED ON:___

CORNER CODE $\frac{\chi - 25}{1}$

(B) Describe any record evidence, monument evidence, occupational evidence, testimonial evidence or any other material evidence you considered, and whether the monument was found or placed.

- 1833 (SEP 20) MULLETT & BRINK NORTH ON EAST SIDE SECTION
 36 V8 40'E T4N 11E
 - 2385.9 BUR DAK 14 IN DIAMETER
 - 2640 SET QURTER SECTION POST BUR DAK 14 S45W 33'
 BUR DAK 12 N36W 25.0B'
 - 3135 ENTER PRAIRIE
 - 5280 SET POST CORNER SECTIONS 25 & 36 BUR OAK 14 S25W 305.58' BUR OAK 12 N85W 188.1' LAND ROLLING SECOND RATE FIRST ½ THINLY TIMBERED WITH BUR WHITE AND BLACK OAK GOOD OBSERVATIONS AT THIS CORNER VAR 8 10'
- 1854 TWP RD REC PORTER TWP BK 1 PG 6 BEGINNING AT THE 1/4 POST ON THE WEST LINE OF SEC 19 T4N R12E [STH 184]; THENCE RUNNING SOUTH ON THE SECTION LINE 1337.82'; THENCE EAST 446.82'; THENCE S18 1/2E 396'; THENCE S3W 264' TO RED OAK TREE; THENCE S17 3/4W 264' TO BURR OAK; THENCE S1E 764.94'; THENCE S11W 502.92' TO BURR OAK TREE; THENCE S6 3/4W 326.04'; THENCE S17E 1158.3'; THENCE S30 3/4W 741.84'; THENCE S41 3/4W 1247.4' TO THE WEST LINE OF T4N R12E (THENCE SOUTH ON THE TOWN LINE 766.92', THENCE S42 1/2W 924'; [SEC 30 FULTON] THENCE S3 1/4W ? CHAINS; THENCE S32 1/2E 1013.1' TO THE W. LINE OF T4N RF12E; THENCE S. ON THE TOWN LINE 4746.06' TO THE SW COR OF SEC 31 OF T4N R12E)
- 1870 RUGER VOL 2 PG 34 & #1431 FD STUMPS OF BOTH BEARING TREES SET IRREGULAR TRIANGULAR HARDHEAD STONE 15X11X9 & SURROUNDED IT WITH 4 HARD HEAD STONES.
- 1883 LEE VOL 2 PG 364 & 1449 FD COR SET BY RUGER [COPIED FROM BELOIT RECORDS]
- 1974 LEE VOL 5 PG 19 FD HH SURROUNDED BY HH & REF SAME
- 1974 SCHROEDER CSM VOL 4 PG 171 STATES NOTHING ABOUT MON. 2624.20 FROM E 1/4 COR SEC 36 TO NE COR SEC 36 PORTER TWP
- 1981 BARNES VOL 6 PG 200 FD PK NAIL ON SURFACE OF PVMT. 30" DEEP FD HH PT UP SURROUNDED BY HHB. SET ALUM. MON. & REF. SAME.
- 1981 AERO-METRIC PHOTO CONTROL NGVD 29 ELEVATION 886.90'
- 1982 BARNES VOL 6 PG 271 FD ALUM. MON. TIED INTO AERO-METRIC PHOTO CONTROL. 280,696.55; 2,233,348.77
- 1989 SCHROEDER CSM VOL 14 PG 112 STATES NOTHING ABOUT MON. E 1/4 COR SEC 36 PORTER TWP IS 40.00 EAST OF SE COR OF LOT 1.
- 1995 BARNES X-1& X-25 THE MON. WAS COVERED BY SEVERAL FEET OF FILL. THE FOLLOWING TIES WERE PROVIDED BY COUNTY & STATE PROJECT MANAGERS. PLACED MAGNET DEEP AT INTERSECTION OF DISTANCES. REC MON. IS ALUM.
- 1995 COMBS CSM VOL 18 PG 454 FD ALUM AT E 1/4 COR SEC 36 & 2651.02 TO ALUM AT SE COR SEC 36 PORTER TWP
- 1999 COMBS #7373 FD IRON SPIKE
- 2001 LATHROP CSM VOL 24 PG 279 FD ALUM AT E 1/4 COR SEC 36 & 2650.97 TO PK AT SE COR SEC 36 PORTER TWP

SHEET 1 OF 3 CORNER CODE X-25(1)

Doub Farmer Nov4 2009

PO 620 E1/4SEC36 FU614

C) Was the corner restored through acceptance of (1) an obliterated evidence location, or, (2) a found perpetuated location?

ACCEPTED FULTON DATA & TIES

D) Describe any material discrepancy between the location of the corner as restored or reestablished and the location of that corner as previously restored or reestablished by distance and direction. Show the discrepancy on the plan view drawing under (a), above. Show the distances between the corner as previously restored or reestablished and (1) the corner as restored or reestablished, and (2) to at least 4 of the witness monuments shown on the drawing in (a), above.

NONE


(E) Was the corner reestablished through lost corner proportionate methods? If so, show the method, including the directions and distances to other public land survey corners used as evidence or used for proportioning the corner location.

I, **Donald Barnes**, hereby certify that the corner location as identified by the corner code index was determined by me under my direction and control and that this U.S. Public Land Survey Monument Record is correct and complete to the best of my knowledge and belief.

SHEET 2 OF 3

CORNER CODE X-25(1)

A.E. 7.08 REQUIREMENT

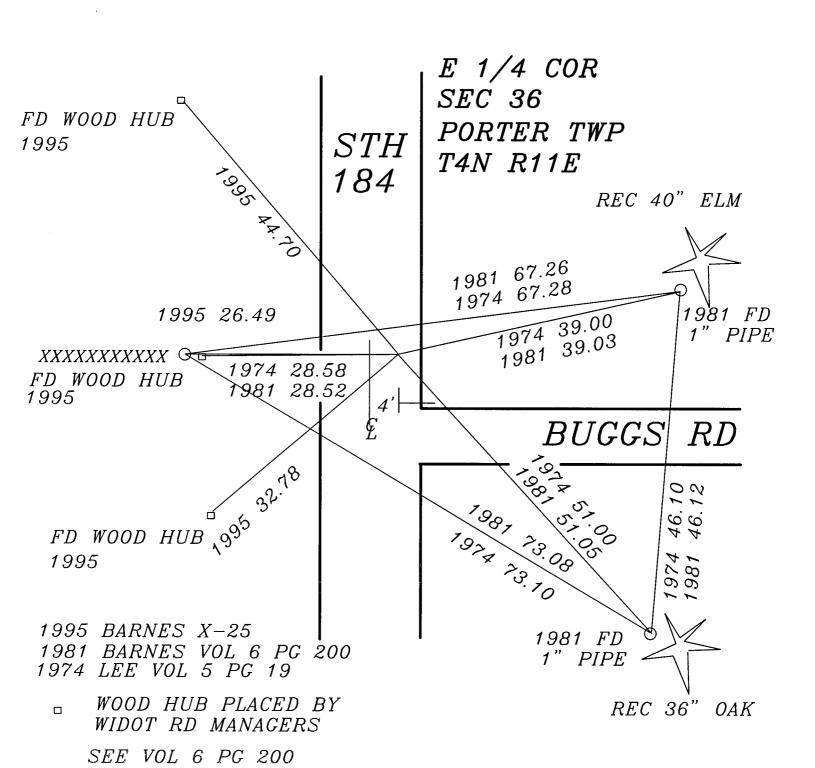

THE FOLLOWING TIES WERE PROVIDED BY

SHEET 3 OF 3 X - 25(1)

MONUMENT WAS COVERED BY SEVERAL

COUNTY & STATE PROJECT MANAGERS.

RECORD MONUMENT IS AN ALUM. MON.

Nu 42009

PLACED MAGNET DEEP AT INTERSECTION OF DISTANCES.

FEET OF FILL.