Paper weight-110# (minimum)

Black nonfading ink required

U.S. PUBLIC LAND SURVEY MONUMENT RECORD


For Public Land Survey Corners In:

WI ADMINISTRATIVE CODE A-E 7.08 REQUIREMENT

REV 10/23/2004 USMONREC.DWG

T. $\underline{4}$ N. R. $\underline{11}$ E. 4th P.M.

CORNER CODE INDEX

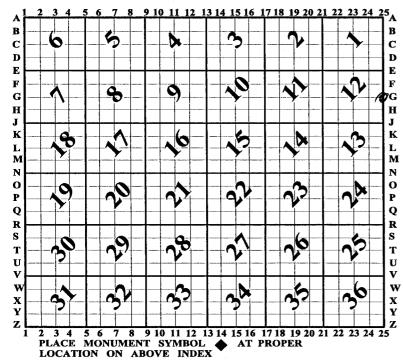

PORTER TWP

IF AVAILABLE ROCK COUNTY COORDINATES PERFERRED

North	Elev.
East	
Hor. Datum	Vert. Datum
LATITUDE _	ELLIPS. HT.
LONGITUDE	
NAD83(91)	NETWORK ADJ. YR
GPS (X)	TRAVERSE (X)
BASED ON THE	FOLLOWING CONTROL:

◆ CORNER MONUMENT

O WITNESS MONUMENT

BEARINGS ARE BASED ON: ________

(a)

FIELD BOOK _____ PAGE # _____ OF _____ SHEET ____ OF ____ SHOW A PLAN VIEW DRAWING DEPICTING THE CORNER MONUMENT AND SURROUNDING PHYSICAL FEATURES, INCLUDING THE EXCAVATION AREA AND DEPTH.
PLANNING & ZONING COMMITTEE ADOPTED THIS FORM ON 12/2/1982

CORNER CODE <u>6-25(1)</u>

E1/4CORSEC12

(B) Describe any record evidence, monument evidence, occupational evidence, testimonial evidence or any other material evidence you considered, and whether the monument was found or placed.

1833 (SEP 20) MULLETT & BRINK NORTH ON EAST SIDE SEC 12 T4N R11E

957	ENTER PRAIRIE
1538.46	INDIAN PATH @ NW & SE
2131.8?	LEAVE PRAIRIE
2180.64	BURR OAK 10 IN DIAMETER
2640	SET QUARTER SECTION POST BUR OAK 18
	S23W 9.9' BUR OAK 10 N4 1/4W 165'
3993.66	BUR DAK 10 IN DIAMETER
5280	SET POST CORNER SECTIONS 1 & 12 BLACK
	□AK 8 5 1 ½ W 55.44' BUR □AK 8 N57W 9.9'
	LAND ROLLING SECOND RATE FIRST 1/2 SOME
	PRAIRIE LAST 1/2 TIMBERED WITH WHITE BLACK

1847 STEBBINS PORTER TWP RD REC BK 1 PG 2 BEGINNING AT A STAKE ON THE WEST LINE OF SEC 5 T4N R11E 1101.54 NORTH OF THE SW CORNER OF SAID SEC 5; THENCE EAST 3762. WHITE DAK 30 N59W 34.32; THENCE S71 3/4E 792 THENCE 559E 198'; THENCE N64 1/2E 827.64' TO THE SEC LINE; THENCE N89E 1320' THENCE EAST ON THE LINE OF FORTIES 1287' TO THE N & S CENTER LINE OF SEC 4 THENCE S54E 1636.8 THENCE S3B 1/2E 2376; THENCE S82 3/4E 2409' TO CENTER LINE OF SEC 10; THENCE S4E 2783.88; THENCE NB6 1/2 E 1155; THENCE S65 1/4E B1B.4; THENCE EASTERLY IN A DIRECT LINE 2640' TO 1/4 POST ON THE EAST LINE OF SEC 11; THENCE EAST ON CENTER LINE OF SEC 12-36, 3564 TO THE CENTER OF A TERRITORIAL RD LEADING FROM JANESVILLE TO MADISON AND THE WHOLE LENGTH OF THE ROAD IS 24,417.36'. COURSES GIVEN ACCORDING TO THE TRUE MERIDIAN. VARIATION OF NEEDLE 7-3/4.

AND BUR DAK

HARRISON STEBBINS COUNTY SURVEYOR.

- 1871 RUGER VOL 2 PG 63 CORNER LOST, ESTABLISHED IT FROM SECTION CORNERS. SET HARD HEAD STONE 20X9X6 ON TOP OF ANOTHER HARD HEAD STONE SURROUNDED IT WITH 3 HARDHEAD STONES & ON LIMESTONE. VAR 7-27 TO NW & SW CORNERS SEC 7. VAR 5-55 2589.18 CENTER SEC 12.
- 1871 RUGER VOL 2 PG 79 & 1069 FD THAT THE TOP STONE & STONES SURROUND IT IN A FORMER SURVEY HAD BEEN DUG UP. BUT THE BOTTOM STONE HAD NOT BEEN DISTURBED DRIVE STAKE DEEP & PUT LIMESTONE ON TOP OF IT & PUT ON TOP LIMESTONE 21X9X6 SURROUNDED BY 4 HH STONES. SEE SECTION 12 PORTER PAGE 39. VAR 7-18 2686.86 TO CEN SEC 7, VAR 7-18 5344.68 TO E 1/4 COR SEC 7
- 1934 WIDOT STH 59 #3907 SHOWS CORNER BUT DID NOT USE OR STATE ANYTHING ABOUT IT.
- 1937 SUNNY VOL 3 PG 359 DUG BXBX7 DEEP FD. NO MON. ON LINE E/W FENCE LINE ON EAST SIDE OF RD.
- 1965 BATTERMAN VOL 4 PG 223 PK NAIL BY WP&L 2642.90 WP&L TO SW COR SEC 7, 2642.9 BY WP&L TO NW COR SEC 7
- 1966 BATTERMAN VOL 4 PG 256 DUG & FD 6"X5" HH
 SURROUNDED BY HHS SET 3/4" PIN & REF. SAME. R/R SPIKES
 10.7 TO THE EAST & SOUTH.
- 1978 SCHROEDER CSM VOL B PG 211+ STATES NOTHING ABOUT MON.
- 1981 BARNES VOL 6 PG 211 FD REBAR OF REC. REPLACED WITH ALUM. & REF. 6' WEST OF N/S CENTER STH 184 PVMT..
- 1995 BARNES G-1 & G-25(PORTER TWP) FD MON. AS SHOWN IN DRAWING, FD POLY WITH TOP BROKE OFF. 6' EAST OF THE WEST EDGE OF STH 184, 57 NORTH OF CENTER OF STH 59
- 2000 NORTHROP CSM VOL 24 PG 45 STATES NOTHING ABOUT MON. 2643.01 TO NW COR SEC 7 & ANGLE 90-22-23 @ NW COR SEC 7 FROM N 1/4 COR SEC 7 TO W 1/4 COR SEC 7

SHEET 1 OF 2

CORNER CODE G-25(1)

Dendel Baines 3/14/2009

P0540 E1/4CORSEC12

200?	BARNES G-1 FD POLY WITH	TOP BROKE OFF. ALSO FD
	REFERENCE MONUMENTS.	ACCEPTED ED MON.

I USED MY 1995 OBSERVATIONS AND FD REF MONUMENTS

C) Was the corner restored through acceptance of (1) an obliterated evidence location, or, (2) a found perpetuated location?

ACCEPTED PERPETUATED LOCATION

D) Describe any material discrepancy between the location of the corner as restored or reestablished and the location of that corner as previously restored or reestablished by distance and direction. Show the discrepancy on the plan view drawing under (a), above. Show the distances between the corner as previously restored or reestablished and (1) the corner as restored or reestablished, and (2) to at least 4 of the witness monuments shown on the drawing in (a), above.

NONE

I, **Donald Barnes**, hereby certify that the corner location as identified by the corner code index was determined by me under my direction and control and that this U.S. Public Land Survey Monument Record is correct and complete to the best of my knowledge and belief.

SHEET 2 OF 2

CORNER CODE G-25(1)

A.E. 7.08 REQUIREMENT

Hade Been 3/14/2009