Paper weight-110# (minimum)

BEARINGS ARE BASED ON:___

Black nonfading ink required

U.S. PUBLIC LAND SURVEY MONUMENT RECORD

For Public Land Survey Corners In: T. N. R. L. E. 4th P.M.	WI ADMINISTRATIVE CODE A-E 7.08 REQUIREMENT REV 10/23/2004 USMONREC.DWG
CORNER CODE INDEX	20-0
A 2 3 4 5 6 7 8 9 10 11 12 33 14 15 16 17 18 19 20 21 22 23 24	PORTER TWP
B	- B ROCK COUNTY WI
C D D D D D D D D D D D D D D D D D D D	C IF AVAILABLE
E	E ROCK COUNTY COORDINATES PERFERRED
	F G
H	— н North Elev
K 48 AN AG AS AS AS	J K East
L	L M
	N Hor. Datum Vert. Datum
	P LATERIAN
Q	Q LATITUDE ELLIPS. HT
	R S LONGITUDE
	T U
VI	v NAD83(91)NETWORK ADJ. YR
x as as as as	W
Y	PASED ON THE EQUIONING COMPROY
1 2 3 4 5 6 7 8 9 10 11 12 13 14 15 16 17 18 19 20 21 22 23 24 PLACE MONUMENT SYMBOL AT PROPER	LZZ BASED ON THE FOLLOWING CONTROL:
LOCATION ON ABOVE INDEX	
♦ CORNER MONUMENT	WITNESS MONUMENT
(a)	
" 	

FIELD BOOK _____ PAGE # ____ OF SHOW A PLAN VIEW DRAWING DEPICTING THE CORNER MONUMENT AND SURROUNDING PHYSICAL FEATURES, INCLUDING THE EXCAVATION AREA AND DEPTH.
PLANNING & ZONING COMMITTEE ADOPTED THIS FORM ON 12/2/1982

CORNER CODE ___

A - 13(2)

P0507 **NECORSEC4**

(B) Describe any record evidence, monument evidence, occupational evidence, testimonial evidence or any other material evidence you considered, and whether the monument was found or placed.

1833 (SEP) BRINK & MULLETT T5N R11E WEST ON SOUTH SIDE SECTION 34

> TRAIL @ SE 607.20

2640.00 SET QUARTER SECTION POST BUR OAK 11 N57E 67.98'; BUR OAK 8 N54W 244.2'

3102.0 **ENTER PRAIRIE**

4884.0 LEAVE PRAIRIE & ENTER MARSH

5280.0 SET POST CORNER SECTION 33 & 34 WILLOW 6 NBE 69.30'; ASPEN B N34W 69.30' LAND ROLLING SECOND RATE WHITE, BLACK, AND BUR DAK LAND PRAIRIE AND MARSH

1833 (SEP) BRINK & MULLETT T5N R11E WEST ON SOUTH SIDE SECTION 33

> 396.0 LEAVE MARSH AND ENTER PRAIRIE

2640.0 SET QUARTER SECTION POST IN PRAIRIE AND MADE

MOUND

3399.0 **LEAVE PRAIRIE**

5280 SET POST CORNER SECTIONS 32 & 33 BUR DAK 18 N19E 64.02'; BUR OAK 11 N47W 84.48' LAND ROLLING SECOND RATE PRAIRIE & @

1833 (NOV 3RD) HARRISON T4N R11E NORTH BETWEEN SECS 3 & 4

825.0 CREEK CRS S.E.

1362.24 BURR DAK 12

2640.0 QUARTER SEC COR. (BURR OAK 12 S74W 45.54'; BURR OAK 12 545E 85.80' BURR OAK 12; BURR OAK 12}

2772.0 **ENTER MARSH**

INT. NORTH BDY 24.42' EAST OF POST IN MARSH 5214.0 WILLO 8 S60E 46.86'; ASPEN 6 S30W 47.52' LAND FOR THE 1ST 1/2 MILE SAME AS BEFORE 2ND 1/2 LEVEL & WET 3RD RATE BEING MARSH NOV 3RD 1833

1833 ORIG GOV PLAT NW COR SEC 3 PORTER TWP IS 24.42' EAST OF SW COR SEC 34 DUNKIRK TWP.

- GRAVES VOL 6 PG 355 [BARNES-COPIED FROM DANE 1872 COUNTY SURVEYORS' RECORDS BK 5 PG 566.] SURVEYED ON THE 24 & 25 DAYS OF APRIL 1872 THE ABOVE PLATTED SECTION. COMMENCED AT SOUTH ORT CORNER. STONE SET RUN THROUGH TO NORTH QUARTER COR STAKE GONE ONE STUMP FD SET CORNER IN HIGHWAY. WEST QRT COR GONE RUN THROUGH THE WHOLE LINE DIVIDED THE DISTANCE EQUAL SET STONE IN QRT CORNERS: RUN THROUGH TO EAST QRT CORNER: SET STONES AT NO. 1,2,3,4,5. S.W. GRAVES COUNTY SURVEYOR. SURVEY IS OF SEC 34 T5NR11E. 1326.60 FROM STONE @ S 1/4 COR SEC 34 TO STONE @ S 1/16TH COR OF SE 1/4 SEC 34, 2653.20 TO SE COR SEC 34. 1327.26 TO STONE @ S 1/16TH COR OF SW 1/4 SEC 34, & 2653.20 TO SW COR SEC 34.
- 1872 LEE VOL 2 PG 82 & #3551 SET BROWN HH WITH 4 SMALL HHS FD OLD STAKE AT 24.42' EAST FROM COR FOR SEC N. AT SW COR SEC 34 FD STONE & N. BT., VAR7-30 1250.21 TO WHITE DAK STAKE @ W 1/16TH CDR DF NW 1/4 SEC 3, VAR 7-30' 2566.08 TO W 1/4 COR SEC 3.
- 1874 RUGER VOL 2 PG 129 FD LARGE REDISH HH STONE ON COR. ALSO FD REMAINS OF STUMP OF S.W. BT, 24.42 EAST OF SE COR SEC 33. @ SE COR SEC 33 FD LIMESTONE ON COR ALSO FD STUMPS OF B.T.S, VAR8-23 1302.84 TO HH 24X9X8 @ N 1/16TH COR OF NE 1/4 SEC 4, & 2605.68 TO N 1/4 COR SHEET 1 OF 3

CORNER CODE A-13(2)

Derstof Daines Nov 5 2009

- PO507 NECORSEC4
 SEC 4. N 1/4 COR SEC 4 IS MIDWAY & ON LINE WITH NE &
 NW CORNERS OF SEC 4.
- 1973 LEE VOL 5 PG 45 DUG & FD REDISH HH ON SIDE SET
 UPRIGHT SMALL HH ON E & W. BK 163/130. REFERENCE
 SAME N 1/16TH COR OF NE 1/4 SEC 4 FD HH 24X9X8 SET BY
 RUGER BK 163/128
- 1985 WEIR A-13 FD 1" IRON PIPE @ NE COR OF SEC 4 & REFERENCE PIPES. SHOWS IT 6' NORTH OF CENTER OF PVMT. & ABOUT 87' +/- WEST OF CMP. I FOUND THE 1" PIPE AT THE NE COR OF SEC 4, T4NR11E AS TIED BY HUGH LEE IN VOL 5 PG 4 DATED APRIL 3, 1973. I ALSO FD 3 OF THE 4 TIES; HOWEVER, ALL THREE OF THESE APPEARED SOME WHAT DISTURBED. I REMEASURED THESE DISTANCES AND ADDED A FOURTH TIE POINT AS SHOW IN THE DRAWING ON THE OPPOSITE SIDE OF THIS SHEET.
- 1991 NORTHROP VOL 6 PG 417 N89-04-18E 2658.20 TO N 1/4 COR SEC 3. SHOWS SW COR SEC 34 BEING WEST OF COR.
- 1993 BARNES A-13(1) COUNTY COORDINATES 328,713.99; 448,066.75. REFERENCED COR. SHOWS 5.6' NORTH OF CENTER OF PVMT. FD 1" PIPE.
- 1994 NORTHROP CSM 17 PG 370 SHOWS 24.42 EAST OF IP @ SE COR SEC 33. 2648.87 FROM S 1/4 COR SEC 33 TO SE COR SEC 33.
- 2008 NORTHROP CSM32-119 FD 3/4 ID PIPE 24.42 EAST OF SE COR SEC 33 T5N R11E. 2673.22 TO S 1/4 COR SEC 33 T5N R11E. WESTERLY 201.21 ALONG SEC LINE TO POB OF SURVEY

FD 1" PIPE 0.15 DEEP 3.5' SOUTH OF NORTH PVMT EDGE

C) Was the corner restored through acceptance of (1) an obliterated evidence location, or, (2) a found perpetuated location?

ACCEPTED FD PIPE

- D) Describe any material discrepancy between the location of the corner as restored or reestablished and the location of that corner as previously restored or reestablished by distance and direction. Show the discrepancy on the plan view drawing under (a), above. Show the distances between the corner as previously restored or reestablished and (1) the corner as restored or reestablished, and (2) to at least 4 of the witness monuments shown on the drawing in (a), above.
- (E) Was the corner reestablished through lost corner proportionate methods? If so, show the method, including the directions and distances to other public land survey corners used as evidence or used for proportioning the corner location.


I, **Donald Barnes**, hereby certify that the corner location as identified by the corner code index was determined by me under my direction and control and that this U.S. Public Land Survey Monument Record is correct and complete to the best of my knowledge and belief.

Embor 2009

SHEET 2 OF 3

CORNER CODE A-13(2)

A.E. 7.08 REQUIREMENT

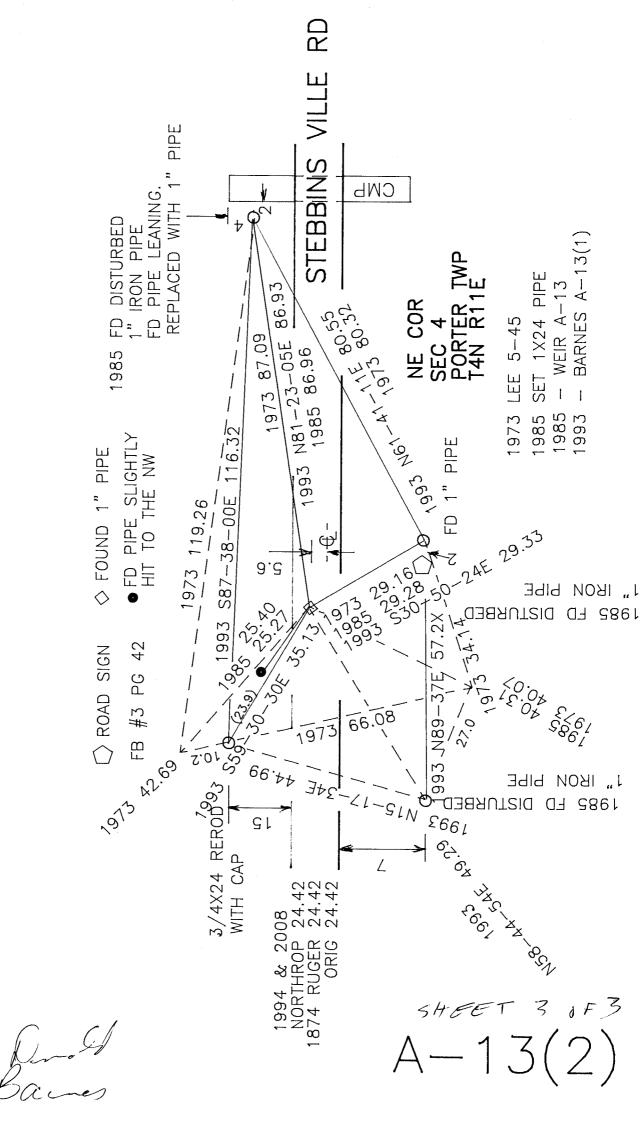

Nov 5 2009