

Paper weight-110# (minimum)

Black nonfading ink required

# U.S. PUBLIC LAND SURVEY MONUMENT RECORD

For Public Land Survey Corners In:  
T. 4N. R. 11E. 4th P.M.  
CORNER CODE INDEX

WI ADMINISTRATIVE CODE A-E 7.08 REQUIREMENT  
REV 10/23/2004 USMONREC.DWG

A	1	2	3	4	5	6	7	8	9	10	11	12	13	14	15	16	17	18	19	20	21	22	23	24	25	A
B			6				5				4				3			2				1				B
C																										C
D																										D
E																										E
F																										F
G																										G
H																										H
J																										J
K																										K
L																										L
M																										M
N																										N
O																										O
P																										P
Q																										Q
R																										R
S																										S
T																										T
U																										U
V																										V
W																										W
X																										X
Y																										Y
Z																										Z

PLACE MONUMENT SYMBOL  AT PROPER LOCATION ON ABOVE INDEX

PORTER TWP  
ROCK COUNTY WI

IF AVAILABLE  
ROCK COUNTY COORDINATES PREFERRED

North \_\_\_\_\_ Elev. \_\_\_\_\_

East \_\_\_\_\_

Hor. Datum \_\_\_\_\_ Vert. Datum \_\_\_\_\_

LATITUDE \_\_\_\_\_ ELLIPS. HT. \_\_\_\_\_

LONGITUDE \_\_\_\_\_

NAD83(91) \_\_\_\_\_ NETWORK ADJ. YR \_\_\_\_\_

GPS (X) \_\_\_\_\_ TRAVERSE (X) \_\_\_\_\_

BASED ON THE FOLLOWING CONTROL:

CORNER MONUMENT

WITNESS MONUMENT

BEARINGS ARE BASED ON: \_\_\_\_\_

FIELD BOOK \_\_\_\_\_ PAGE # \_\_\_\_\_

SHEET 1 OF 5

SHOW A PLAN VIEW DRAWING DEPICTING THE CORNER MONUMENT AND SURROUNDING PHYSICAL FEATURES, INCLUDING THE EXCAVATION AREA AND DEPTH.

PLANNING & ZONING COMMITTEE ADOPTED THIS FORM ON 12/2/1982

CORNER CODE A-5(2)

PO503

NECORSEC6

(B) Describe any record evidence, monument evidence, occupational evidence, testimonial evidence or any other material evidence you considered, and whether the monument was found or placed.

1833 (SEP 22) BRINK & MULLETT T5N R11E WEST ON SOUTH SIDE SECTION 32

2640.0 SET QUARTER SECTION POST BLACK OAK 14 N32E 147.18'; BLACK OAK 14 N22W 83.82'  
3003.0 BUR OAK 12 IN DIAMETER  
3762.0 ENTER MARSH  
4026 STREAM 2.64' (264' ??) @ SE  
4356 LEAVE MARSH  
5280 SET POST CORNER SECTIONS 31 & 32 BUR OAK 8 N66W 4.62'; BUR OAK 10 N78E 55.44' LAND ROLLING SECOND RATE WHITE BLACK & BUR OAK

1833 MULLETT & BRINK (SEP 22<sup>ND</sup>) T5N R11E WEST ON SOUTH SIDE SECTION 31

2640 SET QUARTER SECTION POST BUR OAK 8 N41E 58.08'; BLACK OAK 14 N14W 42.9'  
5187.60 INTERSECTED RANGE LINE AT TEMPORARY POST. SET POST CORNER TOWNSHIPS 4 & 5 RANGES 10 & 11 E WHITE OAK 14 S11E 56.76'; WHITE OAK 18 N1 1/2W 80.52' LAND ROLLING SECOND RATE WHITE BLACK AND BUR OAK.

1833 HARRISON T4N R11E (NOV 4<sup>TH</sup>) NORTH BETWEEN SECS 5 & 6

1980.0 LEFT PRAIRIE  
2640.00 QUARTER SEC. COR. {RED OAK 12 S23W 130.68'; RED OAK 14 S32E 92.40' RED OAK 12; RED OAK 14} MARKED  
2970.0 BROOK 13.2' CRS EAST  
5240.40 INT. NORTH BDY 66.00' EAST OF POST RED OAK 12 S40E 58.08'; RED OAK 16 S6W 72.60' LAND FOR THE 1<sup>ST</sup> 1980' ROLLING 1<sup>ST</sup> RATE PRAIRIE RUN OF MILL WOODLAND & WITH TIMBER OF RED OAK MOSTLY NOV 4<sup>TH</sup> 1833

1833 ORIG GOV PLAT NW COR SEC 5 PORTER TWP IS 66.00' EAST OF SW COR SEC 32 DUNKIRK TWP.

1846 VAUGHAM "PLAT OF WAUCOMA" BK 4 PG 8 NO TIE INTO THE SECTION LINE NOR CORNERS. CALLS FOR A VAR OF 8 EAST.

1857 TOWN RD RECORDS BK 1 PG 10 & 11 BEGINNING AT THE SOUTH EAST COR OF SAID TOWN OF RUTLAND BEING THE SOUTH EAST COR OF SEC 36 T5N OF RANGE 10E AND THENCE NORTH OF SW COR SEC 32 DUNKIRK TWP. ON THE LINE 132.0' TO THE NORTH WEST CORNER OF THE TOWN OF PORTER BEING THE NW COR OF SEC 6 T4N R11E THE LENGTH OF THE ABOVE DESCRIBED RD IS 132.0' AND IS 66' WIDE THE LINE SURVEYED BEING THE CENTER OF THE SAME. VARIATION OF NEEDLE 8 COURSE GIVEN ACCORDING TO THE TRUE MERIDIAN.

1867 (SEP) TOWN RD RECORDS BK 2 PG 5 "" AND THAT THE AFORESAID SUPERVISORS IN CONNECTION WITH THE UNDERSIGNED SUPERVISORS OF THE TOWN OF DUNKIRK IN THE COUNTY OF DANE, HAVING BEEN SATISFIED THAT THE LAW HAS IN ALL RESPECTS BEEN COMPLIED WITH ; IT IS HEREBY ORDERED AND DETERMINED, AND WE DO HEREBY ORDER AND DETERMINE THAT A HIGHWAY BE AND THE SAME IS HEREBY LAID OUT PURSUANT TO SAID APPLICATION : DESCRIBED AS FOLLOWS, TO WIT : BEGINNING AT THE NE COR OF SEC 5 IN SAID TOWN OF PORTER, ON THE TOWN LINE BETWEEN SAID TOWN AND THE TOWN OF DUNKIRK (DUNKIRK BEING IN THE COUNTY OF DANE) AND THENCE RUNNING WEST ON SAID LINE UNTIL IT

EMBOSSSED

SHEET 1 OF 5

CORNER CODE A-5(2)

*Donald Barnes*

4-27-2010

PO503 NECORSEC6

INTERSECTS MR. SAVAGES ORCHARD (SAID ORCHARD BEING IN THE SW CORNER OF SEC 31 IN THE TOWN OF DUNKIRK DANE COUNTY, THENCE BEARING SOUTH 2 RODS: THENCE WEST TO THE COOKVILLE AND DUNKIRK RD RUNNING SOUTH ON THE CENTER LINE OF SEC 6 IN PORTER THE SAID HIGHWAY IS LAID OUT RUNNING THROUGH THE NORTH HALF OF THE NORTH EAST 1/4 OF SEC 5 AND THE N 1/2 OF THE NE 1/4 OF SEC 5 ALSO THE NORTH 1/2 OF THE NE 1/2 OF SEC 6 IN THE TOWN OF PORTER, THE WHOLE LENGTH OF THE ROAD BEING ONE AND ONE HALF (1 1/2) MILES MORE OR LESS. THE LINE OF SAID SURVEY TO BE THE CENTER OF SAID HIGHWAY; AND THE SAME IS ESTABLISHED FOUR RODS IN WIDTH.

1867

(SEP) TOWN RD RECORDS BK 2 PG 7 DESCRIBED AS FOLLOWS, TO WIT : BEGINNING AT THE NE COR OF SEC 5 IN SAID TOWN OF PORTER AND AT THE SE COR OF SEC 32 IN THE TOWN OF DUNKIRK, DANE COUNTY; THENCE RUNNING WEST ON SAID LINE UNTIL NEAR THE CORNER OF MR. SAVAGES ORCHARD. SAID ORCHARD BEING ON THE SE 1/4 OF SEC 31 IN SAID TOWN OF DUNKIRK; THENCE BEARING SOUTH 2 RODS; THENCE WEST UNTIL IT INTERSECTS THE COOKVILLE AND DUNKIRK ROAD RUNNING NORTH AND SOUTH ON THE CENTERLINE OF SEC 6 IN PORTER AND THE NORTH AND SOUTH CENTERLINE OF SEC 31 IN DUNKIRK, DANE COUNTY. THE SAID HIGHWAY IS LAID OUT ON THE NORTH LINE OF SEC 5 AND ON THE NORTH LINE OF SEC 6 UNTIL IT REACHES THE NORTH WEST CORNER OF THE NE 1/4 OF SAID SEC 6 (N 1/4 COR SEC 6) INTERSECTING THE RD RUNNING FROM COOKVILLE TO DUNKIRK BEARING SOUTH 2 RODS OPPOSITE J.W. SAVAGES ORCHARD AND THE WHOLE LENGTH OF SAID ROAD BEING ONE AND HALF MILES MORE OR LESS THE LINE OF SAID SURVEY TO BE THE CENTER LINE OF SAID HIGHWAY AND THE SAME IS ESTABLISHED 4 RODS IN WIDTH.

1870

RUGER VOL 2 PG 24 FD OLD STAKE & TESTED AND FOUND IT CORRET SET HH 14X9X7. SHOWS EAST OF SW COR SEC 32. @ SW COR SEC 32 FD STONE AT COR. ALSO FD BEARING TREE AND STUMP OF ANOTHER BEARING TREE.

1893

BLEEDORN VOL 2 PG 473 FD HH AT COR ALSO ONE OF B.T.S & STUMP OF OTHER. 66.00' EAST OF SE COR SEC 31 T5N R11E. @ SE COR SEC 31 FD LIMESTONE. 2588.52 TO FD STAKE @ E 1/4 COR SEC 6, 2638.68 TO N 1/4 COR SEC 6.

1933

SUNNY #3567 FD POINTED HH IN LINE WITH FENCE SOUTH @ NE COR OF SEC 6. CALLS FOR A JOG OF 66. 2635.8 TO SET 1 1/2 PIPE 24" LONG SURROUNDED BY STONES @ N 1/4 COR SEC 6.

1933

SUNNY VOL 3 PG 227 FD HH ON END 1 1/2' BELOW GRAVEL RD IN LINE WITH FENCE SOUTH, 3' NORTH OF CENTER OF GRAVEL RD 66' EAST OF FENCE TO N. 24" CHERRY TREE S25W 35'; 26" WHITE OAK N66W 68.2' 2635.8X' TO 1 1/2" IRON PIPE AT N 1/4 COR SEC 6, 5245.4X TO NW COR SEC 6, ANGLE 90-42-XX @ N 1/4 COR SEC 6 FROM NE COR SEC 6 TO CENTER OF N/S GRAVEL RD

1963

ELY #12621&12620 CALLS FOR RR SPIKE @ NE COR SEC 6 & SW COR SEC 32. SHOWS TIES. 2658.10 FROM SW COR SEC 32 TO S 1/4 COR SEC 32 & 2637.98 FROM SW COR SEC 31 TO S 1/4 COR SEC 31.

1969

BATTERMAN VOL 4 PG 421 DUG & FD HH SET BY RUGER AT NW COR SEC 5. REFERENCED SAME. ALL BEARINGS ARE ASTONOMIC NORTH BEARINGS. N89-31-45E TO S 1/4 COR SEC 32 T5N R11E

EMBOSSSED

SEAL

*Donald Baenes*

4-27-2010

SHEET 2 OF 5  
CORNER CODE A-5(2)

P0503 NECORSEC6  
 1970 COMBS (SIGNED BY BATTERMAN) VOL 4 PG 487 HC DUG & FD HH 14X9X7, 10' DEEP. SET 1" PIPE & REFERENCED NORTH SIDE OF RD. 30.9 +/- SOUTH OF E/W FENCE  
 1976 WEIR #12616 IRON STAKE FD @ NW COR SEC 5 & SW COR SEC 32. 66.0X EAST OF SW COR SEC 32.  
 1980 UNKNOWN A-5 & #3572 DANE COUNTY TIES. CALLS FOR A R/R SPIKE @ THE SE COR SEC 31 & THE NE COR SEC 6 AND A DISTANCE OF 66.00 BETWEEN THE TWO. CALL DISTANCES TO THE REFERENCE MONUMENTS ARE THE SAME AS ELY IN 1963 IN MAPS #12621&12620.  
 1988 BARNES A-7 SB9-35-45E 2591.24 TO S 1/4 COR SEC 32 T5N R11E. REC NB9-31-45E (ASTRONOMIC NORTH)  
 1988 BARNES VOL 6 PG 387 NB9-46-11W 2672.82 TO N 1/4 COR SEC 6, SB4-45-56W 81.97 TO SE COR SEC 31.  
 1988 BARNES A-5(1) FD 1"X6" PIPE ON TOP OF CUT LIMESTONE. PLACED POLY MON ON TOP OF STONE. REFERENCED SAME. FD SOME OF THE OLD REC MONUMENTS. 3' NORTH OF CENTER OF PVMT. & ON LINE WITH N/S FENCE TO THE SOUTH.  
 2007 RESOP #S15533 FD ALUM MON. SD-56-23W 2589.22 TO FD ALUM @ E 1/4 COR SEC 6 & SB9-08-54W 2636.16 TO FD ALUM @ N 1/4 COR SEC 6.

FD ALUM & REFERENCE MONUMENTS. ALUM IS 4.2' NORTH OF CENTER OF PVMT. SUNNY CALLS FOR 3' NORTH OF CENTER OF ROAD. THE RECORD AND MEASURED DISTANCES INDICATES THE NE COR OF SEC 6 WAS FOUND BY SUNNY IN 1933, BATTERMAN IN 1969, COMBS IN 1970, & BY ME IN 1988. THE TIES INDICATE THE CORNERS REFERENCED BY ELY IN 1963 ARE NOT IN THE SAME LOCATION BUT RATHER @ THE CENTER OF THE ROAD & ON LINE WITH N/S FENCE LINE. DID NOT ACCEPT ELY'S LOCATION.

C) Was the corner restored through acceptance of (1) an obliterated evidence location, or, (2) a found perpetuated location?

IT APPEARS THE TOP OF THE SHORT ALUM. MON. , WHICH IS ON TOP OF THE CUT LIMESTONE MOVED ABOUT 0.11' TO THE SOUTH. THE COR. POSITION IS COMPUTED FROM THE INTERSECTION OF 5 OF THE REFERENCE MONUMENTS. THE ALUM MON PROBABLE BROKE OR MOVED BECAUSE IT WAS JUST A SHORT ONE.

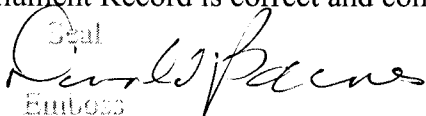
D) Describe any material discrepancy between the location of the corner as restored or reestablished and the location of that corner as previously restored or reestablished by distance and direction. Show the discrepancy on the plan view drawing under (a), above. Show the distances between the corner as previously restored or reestablished and (1) the corner as restored or reestablished, and (2) to at least 4 of the witness monuments shown on the drawing in (a), above.

THE 196? UNKOWN TIE FROM DANE COUNTY AND THE 1963 ELY TIES ESTABLISHES THE CORNER ABOUT 3.45' SOUTH. HE DOES NOT STATE WHAT HE FD & ONLY CALLS FOR A R/R SPIKE, WHICH IS NEAR THE CENTER OF THE ROAD. I DID NOT ACCEPT NOR ESTABLISH THE SW COR. OF SEC 32. SINCE RUGER FD A STONE @ THE SW COR SEC 32 & THE DANE COUNTY TIE CALLS FOR A R/R SPIKE WITH NO HISTORY OF ANY EXCAVATION THE SW COR SEC 32 NEEDS TO BE DUG FOR BY DANE COUNTY. I COMPUTED A POSTION OF THE SW COR OF SEC 32 TO COMPUTE AND CHECK THE DISTANCES TO THE REFERENCE MONUMENTS.

(E) Was the corner reestablished through lost corner proportionate methods? If so, show the method, including the directions and distances to other public land survey corners used as evidence or used for proportioning the corner location.

NO

I, Donald Barnes, hereby certify that the corner location as identified by the corner code index was determined by me under my direction and control and that this U.S. Public Land Survey Monument Record is correct and complete to the best of my knowledge and belief.

Seal  
  
 Emboss

SHEET 3 OF 5

4-27-2010

CORNER CODE A-5(2)

A.E. 7.08 REQUIREMENT



