Paper weight-110# (minimum)

Black nonfading ink required

#### LAND U.S. SURVEY **PUBLIC** MONUMENT RECORD


For Public Land Survey Corners In:

WI ADMINISTRATIVE CODE A-E 7.08 REQUIREMENT

REV 10/23/2004 USMONREC.DWG

T. 4 N. R. 11 E. 4th P.M.

CORNER CODE INDEX

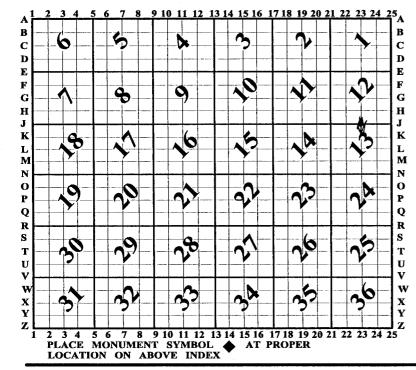

# **PORTER** TWP **ROCK COUNTY WI**

IF AVAILABLE ROCK COUNTY COORDINATES PERFERRED

North	Elev
East	
Hor. Datum	Vert. Datum
LATITUDE	ELLIPS. HT.
LONGITUDE _	
NAD83(91)	NETWORK ADJ. YR
GPS (X)	TRAVERSE (X)
BASED ON THE	E FOLLOWING CONTROL:

**◆ CORNER MONUMENT** 

O WITNESS MONUMENT

BEARINGS ARE BASED ON:

(a)

FIELD BOOK PAGE # SHOW A PLAN VIEW DRAWING DEPICTING THE CORNER MONUMENT.		
PHYSICAL FEATURES, INCLUDING THE EXCAVATION AREA AND DEPT PLANNING & ZONING COMMITTEE ADOPTED THIS FORM ON 12/2/1982		- 165
CORNE	R CODE	J-23(1)

## PD552 N1/4CDRSEC13

(B) Describe any record evidence, monument evidence, occupational evidence, testimonial evidence or any other material evidence you considered, and whether the monument was found or placed.

- 1833 (OCT 29) HARRISON EAST ON RAND BET SECS 12 & 13 T4N
  - 1056 TRAIL CRS NORTH
  - 2640 TEMPY 1/4 SEC COR4
  - 4290 LEAVE PRAIRIE & ENTER SMALL SCATTERING
    - TIMBER OF BURR & RED O
  - 5273.4 INT. E. BDY 39.6' S  $\Box$ F P. LAND F $\Box$ R THE 1  $^{ST}$   $^{3}$ /<sub>4</sub>
    - OF A MILE ? ROLLING PRAIRIE 1 ST RATE ? ROLLING  $\mathbf{Z}^{\text{ND}}$  RATE WITH RED & BUR  $\mathbf{D}$ 
      - COR WEST BET SECS 12 & 13
  - 2636.7 QUARTER SEC COR. SET A POST & RAISED MOUND ON GROUND HIGH & ROLLING
  - 5273.4 INT. SEC. COR
- 1871 RUGER VOL 2 P 63 CORNER LOST ESTABLISHED IT FROM SECTION CORNERS SET LIMESTONE 20X8X4. SHOWS NO E/W DISTANCES BUT CALLS VOR VAR 6-49' ALONG ENTIRE SOUTH LINE OF SEC 12. VAR 6-35 2696.92 TO LIMESTONE 19X7X5 @ CENTER OF SEC 12.
- 1965 BATTERMAN VOL 4 PG 223 FD 4X8 LIMESTONE SET BY RUGER. 5 EAST OF N/S FENCE & 1 NORTH OF E/W FENCE. 2647.80 TO SW COR SEC 12. RUGER 2642.81 FROM SW TO S 1/4 COR SEC 12.
- 19?? WPL #3592 & #3625 FD 4X8X20 LS 2647 TO FD 6X11X18 @ NW COR SEC 13.
- 2005 BARNES J-23 FOUND LIMESTONE 4"X9"X18" WITH FLAT SIDES, 10" DEEP, AND IN VERTICAL POSITION. NO OTHER STONES IN AREA PLACED 5 MAGNETS ON EASTSIDE OF BOTTOM OF STONE. PLACED CARSONITE POST 1' SOUTH & 1' EAST OF L.S. FENCE LINES ARE GONE. RETRACED FENCE LINES BY LOCATING METAL FENCE POSTS BELOW GRADE, WHICH POST LINES ARE IN HARMONY WITH RECORD CALL DISTANCES. STONE APPEARED NOT TO BE DISTURBED. DISTANCE TO SW COR OF SEC 12 IS 2.28' SHORTER THAN THE 1965 RECORD WPL DISTANCE. USING BATTERMAN'S GPS COORDINATES FOR THE SE COR OF SEC 12 INDICATES THE LS IS ON LINE WITH THE SW & SE CORNERS OF SEC 12 AS CALLED FOR BY RUGER. THE DISTANCES ALSO INDICATES THE L.S. IS ALMOST MIDWAY BETWEEN THE SE & SW CORNERS OF SEC 12. ACCEPTED FD LIMESTONE AS PLACED BY RUGER IN 1871.
- 2005 LATHROP #15276 FD STONE MON. 2645.55 TO FD PIPE @ NW COR SEC 13

I USED MY 2005 OBSERVATIONS TO FD STONE.

SHEET 1 OF 3
CORNER CODE J-23(1)

Dende Paines 3-17-2009

### P0552

## N1/4CORSEC13

C) Was the corner restored through acceptance of (1) an obliterated evidence location, or, (2) a found perpetuated location?

ACCEPTED RUGER'S STONE.

D) Describe any material discrepancy between the location of the corner as restored or reestablished and the location of that corner as previously restored or reestablished by distance and direction. Show the discrepancy on the plan view drawing under (a), above. Show the distances between the corner as previously restored or reestablished and (1) the corner as restored or reestablished, and (2) to at least 4 of the witness monuments shown on the drawing in (a), above.

NONE

(E) Was the corner reestablished through lost corner proportionate methods? If so, show the method, including the directions and distances to other public land survey corners used as evidence or used for proportioning the corner location.

IN 1871 RUGER DECLARED THE CORNER LOST & ESTABLISHED IT ON LINE FROM THE SE & SW SECTION CORNERS. HE SET LIMESTONE 20X8X4. THE FD LS IS 0.05' IS NORTH OF THE LINE BETWEEN THE SE & SW CORNERS OF SEC 12 AND THE MID POINT IS 0.18 EAST OF THE STONE.

I, Donald Barnes, hereby certify that the corner location as identified by the corner code index was determined by me under my direction and control and that this U.S. Public Land Survey Monument Record is correct and complete to the best of my knowledge and belief.

SHEET 2 OF 3

CORNER CODE J-23(1)

A.E. 7.08 REQUIREMENT

