

U.S. PUBLIC LAND SURVEY MONUMENT RECORD

For Public Land Survey Corners in:

WI ADMINISTRATIVE CODE A-E 7.08 REQUIREMENT

T. 2N., R. 11E

CORNER CODE INDEX

A	1	2	3	4	5	6	7	8	9	10	11	12	13	14	15	16	17	18	19	20	21	22	23	24	25
B	6																								
C		5																							
D			4																						
E				3																					
F					2																				
G	1																								
H		8																							
I			9																						
J				10																					
K					11																				
L	18																								
M		11																							
N			16																						
O				15																					
P					14																				
Q						13																			
R	19																								
S		20																							
T			21																						
U				22																					
V					23																				
W						24																			
X	30																								
Y		29																							
Z			28																						
				27																					
					26																				
						25																			
							30																		
								31																	
									32																
										33															
											34														
												35													
													36												
														37											
															38										

PLYMOUTH TWP
ROCK COUNTY WI

IF AVAILABLE
ROCK COUNTY COORDINATES PREFERRED

North _____ Elev. _____

East _____

Hor. Datum _____ Vert. Datum _____

LATITUDE _____ ELLIPS. HT. _____

LONGITUDE _____

GPS (X) _____ TRAVERSE (X) _____

BASED ON THE FOLLOWING CONTROL:

PLACE MONUMENT SYMBOL AT PROPER LOCATION ON ABOVE INDEX

CORNER MONUMENT

WITNESS MONUMENT

(a)

BEARINGS ARE BASED ON:

FOR TIES SEE e 25(1)
1990

FIELD BOOK _____ PAGE # _____

SHEET 1 OF 3

SHOW A PLAN VIEW DRAWING DEPICTING THE CORNER MONUMENT AND SURROUNDING PHYSICAL FEATURES, INCLUDING THE EXCAVATION AREA AND DEPTH.

PLANNING & ZONING COMMITTEE ADOPTED THE ABOVE FORM ON 12/2/1982

CORNER CODE E-25(2)

PL533

(B) Describe any record evidence, monument evidence, occupational evidence, testimonial evidence or any other material evidence you considered, and whether the monument was found or placed.

- 1833 MULLETT NORTH ON EAST SIDE OF SEC 1
429 LEAVE MARSH AND ENTER PRAIRIE
2640 SET QUARTER SECTION POST IN PRAIRIE AND RAISED A MOUND
5280 SET POST CORNER TOWNSHIPS 2 & 3 N RANGES 11 & 12E IN PRAIRIE AND RAISED A MOUND LAND ROLLING PRAIRIE AND RAISED A MOUND . LAND ROLLING PRAIRIE FIRST RATE SEPT 11TH 1833
NORTH ON EAST SIDE SECTION 12
231 LEAVE PRAIRIE AND ENTER TIMBER
2640 SET QUARTER SECTION POST HICKORY 8 S22W 17.16' HICKORY 10 N89W 16.5'
3186.48 BLACK OAK 12 IN DIAMETER
4488 ENTER MARSH
5247 SPRING STREAM ? C S.E.
5280 SET POST CORNER SECTIONS 1 & 12 BUR OAK 8 N 1/2 W 577.5' BUR OAK 8 S73W 256.08' LAND ROLLING SECOND RATE TIMBER WHITE BLACK AND BUR OAK HICKORY ?
- 1833 HARRISON EAST ON RAND BET SECS 1 & 12
99 LEFT TIMBER ENTER MARSH
1320 LEFT MARSH & ENTER TIMB.
2640 TEMPY 1/4 P
4870.14 LEFT TIMBER & ENTER MARSH
5214 BROOK CRS S.E.
5266.14 INT E BDY 48.48' S OF P. LAND LEVEL & ? WET 2ND RATE TIMBER MOSTLY BURR O & RED O
COR. WEST.
2633.07 QUARTER SEC COR {BURR O 6 N21W 116.16' BURR O 7 S75E 106.92' BURR O 6 BURR O 7} MARKED
- 1834 HARRISON WEST BET SECS 6 & 7 ON RAND
1650 LEFT TIMBER & ENTER PRAIRIE
2640 TEMPY 1/4 POST
4290 LEAVE PRAIRIE & ENTER MARSH
5329.5 INT. W BDY 72.6' S OF P. MARKED SAME NO TREES LAND 1ST 1/4 BLDG 2ND RATE WITH RED O. & W.O. BURR. PRAIRIE
COR EAST
2689.5 QUARTER SEC COR. SET POST & RAISED MOUND
5329.5 SEC COR.
- 1843 STEBBIN TWP RD REC BK 1 PG 2 VARIATION OF NEEDLE 7 1/2 BEGINNING AT THE SE COR OF SEC 1 T2N R11E; THENCE WEST 2 1/2 MILES (THIS COURSE FROM QUARTER POST ON SOUTH SIDE OF SEC 1 TO SW COR SOUTH ON A RANGE FROM BELOIT TO MADISON) TO THE QUARTER STAKE ON THE SOUTH LINE OF SEC 3; THENCE N72W ONE MILE AND 20 CHAINS TO A STAKE; THENCE 59 WEST 1079.1' TO A BURR OAK TREE; THENCE N70W 815.1' TO A STAKE; THENCE S65W 2610.3' TO A BLACK OAK TREE; THENCE S45W 1894.2' TO SEC BETWEEN SECTIONS 5 & 8, 247.5' EAST OF THE SE COR OF SEC 6, T2N R11E; THENCE WEST FOUR MILES 3679.5' TO A STAKE ON THE SEC LINE BETWEEN SECS 4 & 9, 660' WEST OF THE QUARTER POST; THENCE N43 1/2W 838.2' TO A BURR OAK TREE; THENCE N65W 3444.54' TO A POINT ON THE LINE BETWEEN THE COUNTIES OF ROCK AND GREEN 341.88' SOUTH OF THE QUARTER POST ON THE WEST SIDE OF SEC 7, T2N, R10E AND THE WHOLE LENGTH OF THE ROAD IS 12 MILES 3927'
- 1854 MC VEAN VOL 1 PG 23 SHOWS A DISTANCE OF 2636.70 TO W 1/4 COR & 2670.36' TO S 1/4 COR SEC 6 T2N R12E.

Donald Bauer
May 12 2023

SHEET 1 OF 3 CORNER CODE E-25(2)

PL533

1864 TWP RD REC BK 1 PG 59 COMMENCING AT A PT 33' WEST OF THE $\frac{1}{4}$ POST ON THE EAST LINE OF SEC 12; THENCE RUNNING NORTH 33' WEST OF SAID LINE TO A PT 33' WEST OF THE NE COR OF SAID SECTION 12 TO INTERSECT HWY RUNNING EAST AND WEST IN SAID TOWN, AND THROUGH LANDS DESCRIBED AS FOLLOWS: THE SOUTH $\frac{1}{2}$ OF THE NE $\frac{1}{4}$ AND THE N $\frac{1}{2}$ OF THE NE $\frac{1}{4}$ OF SEC 12, T2 R1E.

1867 TWP RD REC BK 1 PG 59 REPEAT OF ABOVE

1867 LEE VOL 1 PG 331 FD STAKE SET BY LOCKE. SHOWS A DISTANCE OF 2644.46 FROM THE E $\frac{1}{4}$ COR TO NE COR OF SEC 12 PLYMOUTH TWP.

1868 LOCKE PG 31 NORTH ON EAST LINE SEC 12 VAR 6-48

0 SET OFF 6.27' WEST

1153.02 CENTER M&M R/R

1320 SET OFF 3.3' EAST

1650 SET OFF 6.27' WEST

1980 SET OFF 6.6' WEST

2310 SET OFF 4.95' WEST

2653.2 INTERSECTE $\frac{1}{4}$ LINE 1.32' WEST OF COR. FOUND N. BT STUMP OF SOUTH BT AND STAKE NORTH BT IS N79W VAR CORRECTED 7-13

CONTINUED NORTH FROM $\frac{1}{4}$ COR WITH VAR 6-48

4488 SET OFF 31.68' WEST

5306.4 INTERSECTED NORTH BOUNDARY 26.4' WEST OF COR. FOUND NORTH BT COR 5.94' EAST OF CENTER OF BRIDGE VAR CORRECTED 6-55 AUG 26 1868

PG 32 COMMENCED AT COR FOR SEC 1 AND 2 11 AND 12 FOUND BT IN SEC 1 STUMP OF BT IN SEC 11 AND WHERE BT IN SEC 2 WAS DUG OUT & STONE ON COR. COR IN CENTER OF HIGHWAYS EAST BETWEEN SECS 1 & 12 VAR 5-37

481.14 CENTER SLUICE BRIDGE

2686.86 INTERSECTED $\frac{1}{4}$ LINE 14.52' SOUTH OF COR. FOUND NORTH B.T. AND COR AS SET BY SELF (SEE CO SURVEYORS RECORD) VAR CORRECTED 5-54 COR IN CENTER OF HIGHWAY CONTINUED EAST FROM $\frac{1}{4}$ COR WITH VAR 5-54

5303.76 INTERSECTED EAST BOUNDARY 2.64' NORTH OF COR. VAR CORRECTED 5-52 AUG 27 1868

PG 33 NORTH ON EAST LINE SEC 1 VAR 6-40

0 SET OFF 10.56' EAST

2657.82 INTERSECTED $\frac{1}{4}$ LINE 23.1' EAST OF COR. FOUND STONE SET AT END OF SOD FENCE. VAR CORRECTED 6-56 CONTINUED NORTH FROM $\frac{1}{4}$ COR WITH VAR 6-40

5315.64 INTERSECTED NORTH BOUNDARY 20.79' EAST OF COR. FOUND STONE & UNDERNEATH REMAINS OF STAKE. COR. IN CENTER OF HIGHWAY AND NEARLY IN LINE WITH N & S FENCES. VAR CORRECTED 7-07

1870 RUGER VOL 2 PG 43 FD STONE MON. SET BY LOCKE.

1876 RUGER VOL 2 PG 205 CALLS FOR STONE MON. SHOWS A DISTANCE OF 2645.94 FROM E $\frac{1}{4}$ COR TO NE COR OF SECTION 12 PLYMOUTH TWP.

1974 LEE VOL 5 PG 53 COR SET BY DOUBLING DISTANCE AND LINE BETWEEN THE W $\frac{1}{16}$ COR OF THE NW $\frac{1}{4}$ OF SEC 7 AND THE W $\frac{1}{4}$ COR OF SEC 7. HE REFERENCED SAME. SHOWS A DISTANCE OF 2666.27 TO S $\frac{1}{4}$ COR OF SEC 6 AND 2648.62 TO W $\frac{1}{4}$ COR OF SEC 7

1980 BARNES VOL 6 PG 29 SHOWS RECORD DISTANCE TO THE W $\frac{1}{4}$ COR.

1983 BARNES VOL 6 PG 307 THE WEST LINE OF NW $\frac{1}{4}$ OF SEC 7. DEPICTS DIFFERENT DISTANCES AND MONUMENTS FOUND OR SET. SEE VOL 5 PG 53 AND VOL 4 PAGES 587 & 588

1983 COMBS GSM 11-329 SET PK 2629.38 TO S $\frac{1}{4}$ COR SEC 1

1988 BARNES VOL 6 PG 389 SHOWS RECORD DISTANCES.

1989 COMBS CSM VOL 14 PG 8 ALUM. MON. 80-49-25E 2647.52 TO E $\frac{1}{4}$ COR SEC 12 & WEST ON NORTH LINE OF SEC SEC 12.

SHEET 2 OF 3 CORNER CODE E-25(2)

Donald Barnes May 12 2003

PL533

1989 COMBS MAP #12170 FD ALUM. MON.

1990 BARNES E-25 BY USING LOCKE'S DISTANCES OF THE REMONUMENTATION OF PLYMOUTH TOWNSHIP IT SEEMS THAT THE CORNER SHOULD BE ABOUT 13 TO THE WEST AND ABOUT 5' TO THE NORTH. A CMP NOW OCCUPIES THIS SPACE, I DID NOT EXCAVATE. SINCE, I DO NOT HAVE EVIDENCE TO DISPUTE HUGH LEES POSITION, I ACCEPTED THE LOCATION AND PLACED AN ALUMINUM MON. THE FOLLOWING DISTANCES SUPPORT THE CONCEPT THAT THE CORNER WAS PROBABLY TO THE WEST:

1. THE DISTANCE TO A CUT LIMESTONE AT THE S ¼ COR OF SEC 1 IS 2629.44 (LOCKE 2616.90)
2. THE DISTANCE TO A CUT LIMESTONE AT THE W ¼ COR OF SEC 6 IS 2661.79 (LOCKE 2657.82)
3. THE DISTANCE TO A CUT LIMESTONE AT THE W ¼ COR OF SEC 7 IS 2647.50 (LOCKE 2653.20)
4. THE DISTANCE TO THE S ¼ COR OF SEC 6 IS 2666.13 (MCVEAN 2670.36)

REFERENCED SAME. COR IS 2 SOUTH OF CENTER OF PVMT & 13' EAST OF N/S C.M.P. (EAST OF N/S RD)

1990 BARNES E-25(1) PLACED AN ALUM. MON AT THE POSITION THAT LEE ESTABLISHED & FD CUT LIMESTONE THAT IS IN HARMONY WITH RECORD DISTANCES REFERENCED SAME. ALUM MON. IS 13.30' EAST OF CUT L.S. ACCEPTED FD CUT L.S. CUT L.S. IS ON THE EAST EDGE OF THE C.M.P.

1997 COMBS CSM VOL 20 PG 66 PK N1-03-17W 2661.63 TO E ¼ COR SEC 1 & WEST ON NORTH LINE OF SEC 12.

FD ALUM. & CUT L.S.

C) Was the corner restored through acceptance of (1) an obliterated evidence location, or, (2) a found perpetuated location?

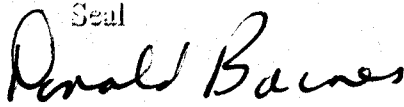
ACCEPTED FOUND CUT L.S.. USED MY OLD OBSERVATIONS. THE BEARINGS ON E-25(1) ARE BASED ON THE ROCK COUNTY PROJECTION.

D) Describe any material discrepancy between the location of the corner as restored or reestablished and the location of that corner as previously restored or reestablished by distance and direction. Show the discrepancy on the plan view drawing under (a), above. Show the distances between the corner as previously restored or reestablished and (1) the corner as restored or reestablished, and (2) to at least 4 of the witness monuments shown on the drawing in (a), above.

E-25(1) SHOWS THE DISCREPANCY BETWEEN THE ALUM. MON. & THE CUT L.S.

(E) Was the corner reestablished through lost corner proportionate methods? If so, show the method, including the directions and distances to other public land survey corners used as evidence or used for proportioning the corner location.

I, **Donald Barnes**, hereby certify that the corner location as identified by the corner code index was determined by me under my direction and control and that this U.S. Public Land Survey Monument Record is correct and complete to the best of my knowledge and belief.

Seal

Emboss

SHEET 3 OF 3

May 12 2003

CORNER CODE

E-25(2)

A.E. 7.08 REQUIREMENT