Paper weight-110# (minimum)

Black nonfading ink required

U.S. PUBLIC LAND SURVEY MONUMENT RECORD


For Public Land Survey Corners In:

WI ADMINISTRATIVE CODE A-E 7.08 REQUIREMENT

REV 10/23/2004 USMONREC.DWG

T. 4 N. R. 11 E. 4th P.M.

CORNER CODE INDEX

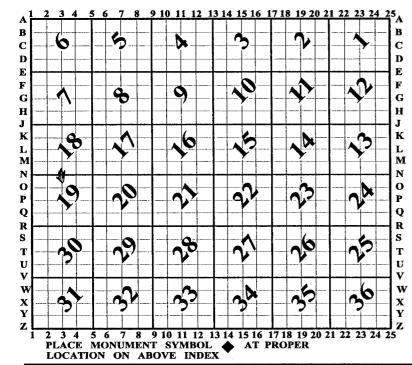

PORTER TWP

IF AVAILABLE ROCK COUNTY COORDINATES PERFERRED

North	Elev.
East	
Hor. Datum	Vert. Datum
LATITUDE	ELLIPS. HT.
LONGITUDE	WARRANCE
NAD83(91)	NETWORK ADJ. YR
GPS (X)	TRAVERSE (X)
BASED ON THE	FOLLOWING CONTROL:

◆ CORNER MONUMENT

WITNESS MONUMENT

BEARINGS ARE BASED ON: ______

(a)

FIELD BOOK _____ PAGE # ____ OF ____ SHEET ___ OF SHOW A PLAN VIEW DRAWING DEPICTING THE CORNER MONUMENT AND SURROUNDING PHYSICAL FEATURES, INCLUDING THE EXCAVATION AREA AND DEPTH.

PLANNING & ZONING COMMITTEE ADOPTED THIS FORM ON 12/2/1982

N1/4CORSEC19

(B) Describe any record evidence, monument evidence, occupational evidence, testimonial evidence or any other material evidence you considered, and whether the monument was found or placed.

- 1833 NOV 5 HARRISON T4N R11E 4TH MER. *WEST BET 18 & 19* 2640.00 QUARTER SEC. COR. {BURR OAK 20 S43W 55.44'; BURR OAK 18 NORTH 26E 33.66' {BURR O 20 BURR O 18}MARKED
 - 5191.60 INT. WEST BDY 66.00' NORTH OF POST. {BURR OAK 18 \$24E 42.9'; BURR OAK 10 N22E 91.74' LAND @ ? SAME
- 1848 STEBBINS PORTER TWP RD REC BK 1 PG 3 BEGINNING AT THE 1/4 POST OF THE SOUTH LINE OF SEC 18 T4N R11EAST; THENCE SOUTH ON THE 1/4 LINE OF SEC 19 5280' TO THE 1/4 POST ON THE NORTH LINE OF SEC 30; THENCE SOUTH ON THE 1/4 LINE OF SEC 30 5280' TO THE 1/4 POST ON THE SOUTH LINE OF SEC 30; THENCE SOUTH ON THE 1/4 LINE OF SEC 31 990' TO THE CENTER OF THE RD LEADING FROM JANESVILLE TO MADISON. THE WHOLE LENGTH OF THE RD IS 11550. VARIATION OF NEEDLE 7-3/4 HARRISON STEBBINS CO. SURVEYOR.
- 1860 STEBBINS PORTER TWP RD REC BK 2 PG 2 BEGINNING AT THE SOUTH EAST COR OF SEC 18 T4N R11E; THENCE WEST ON THE SEC LINE BETWEEN SECTION 18 & 19, 2640' TO THE 1/4 POST ON THE SOUTH LINE OF SAID SECTION 18; THENCE WEST ON THE SAID LINE 2,477.64' TO THE SOUTH WEST COR OF SEC 18 AND THE WHOLE LENGTH OF THE ABOVE SURVEYED RD IS 5117.64' COURSES ACCORDING TO THE TRUE MERIDIAN, VARIATION OF NEEDLE 8. H. STEBBINS-SURVEYOR
- 1860 STEBBINS PORTER TWP RD REC 8K 2 PG 2 & 3 BEGINNING AT THE SOUTH EAST COR OF SEC 18 T4N R11E; THENCE WEST ON THE SEC LINE BETWEEN SECTION 18 & 19, 2640 TO THE 1/4 POST ON THE SOUTH LINE OF SAID SECTION 18; THENCE WEST ON THE SAID LINE 2,477.64 TO THE SOUTH WEST COR OF SEC 18; AND THE WHOLE LENGTH OF THE ABOVE SURVEYED RD IS 5117.64 COURSES ACCORDING TO THE TRUE MERIDIAN, VARIATION OF NEEDLE 8.
- 1868 LOCKE VOL 1 PG 329 & #3607 FD STUMPS OF BTS & STONE ON COR. SET BR O. STAKE WITH HARDEADS ON E. AND S. W. AND LARGE HARD HEAD ON N. VAR 8-15 1296.08 TO STAKE WITH HH ON E & W @ N 1/16TH COR OF NW 1/4 OF SEC 19, 2501.40 TO NW COR SEC 19, VAR8-05' 1338.15 TO BR SCANTLING WITH HH ON N & S @ E 1/16TH COR OF NW 1/4 SEC 19, VAR8-05 2676.30 TO STAKE WITH HH ON N.S.E. & W IN W. EDGE OF WATERHOLE BR OAK 22 N3E 87.95' @ CENTER OF SEC 19.
- PORTER TWP RD REC BK 3 PG 13 BEGINNING ON THE NORTH AND SOUTH QUARTER SECTION LINE RUNNING NORTH AND SOUTH THROUGH SEC 31, T4N R11E, ROCK COUNTY AT A POINT WHERE THE PUBLIC HIGHWAY NOW RUNNING NORTH AND SOUTH THROUGH THE CENTER OF SECTION 7, 18,19,30, AND A PART OF 31 IN SAID T4 INTERSECTS THE PUBLIC HIGHWAY RUNNING FROM EVANSVILLE TO JANESVILLE AND KNOWN AS THE MADISON ROAD AND RUN THENCE DUE SOUTH ALONG THE QUARTER SECT LINE THROUGH SAID SEC 31 IN SAID T4 TO THE SOUTH LINE OF SAID SEC 31 SAID PROPOSED HIGHWAY CROSSING LAND OWNED BY W.B. VAN WART, O.C. & EDD GRIFFITH, JACOB BENKERT, JACOB ELMEN AND THE CHICAGO & NORTHWESTERN RAILWAY COM.

AFTERWARDS UPON APPEAL TAKEN BY FRANK MONTGOMERY FROM THE DETERMINATION SO REFUSING TO LAY OUT SUCH HAIGHWAY AS AFORESAID, COMMISSIONERS

SHEET 1 OF 4 CORNER CODE N-3(2)

Wild Faces 3-17-2009

PD562 N1/4CORSEC19

WERE DULY APPOINTED TO REVIEW THE SAID DETERMINATION AND SUCH PROCEEDINGS WERE DULY HAD BEFORE THEM THAT THE SAME WAS FINALLY REVERSED AS APPEARS BY THEIR DECISION """" BEGINNING ON THE NORTH AND SOUTH QUARTER SEC LINE RUNNING NORTH & SOUTH THROUGH SEC 31, T4N R11E AT A POINT WHERE THE PUBLIC HIGHWAY NOW RUNNING NORTH AND SOUTH THROUGH THE CENTER OF SEC 7-18-19-30 AND A PART OF 31 IN SAID T4 INTERSECTS THE PUBLIC HIGHWAY RUNNING DUE SOUTH ON QUARTER LINE TO WITHIN 165' OF LAND OWNED BY CHICAGO & NORTHWESTERN RAILROAD CO. CROSSES SAID 1/4 LINE; THENCE SOUTH EAST TO LAND OWNED BY CHICAGO & NORTHWESTERN RAILROAD TO A POINT 164' EAST OF RAILROAD BRIDGE NOW ON SAID QUARTER LINE; THENCE SOUTH ACROSS LAND OWNED BY CHICAGO & NORTHWESTERN RAILROAD CO. AS NEAR AS PRACTICABLE; THENCE SOUTH WEST TO A POINT WHERE SAID QUARTER LINE INTERSECTS THE SOUTH LINE OF SAID SEC 31 SAID LINE IS THE CENTER OF SAID HIGHWAY AND THE SAME IS LAID OUT OF THE WIDTH OF 66'. E.M. STEBBINS TOWN CLERK.

- 1940 SUNNY VOL 3 PG 466 FD 60D SPK 2¹ BELOW RD SURFACE SET 1-1/2 PIPE FOR CORNER. N & S 1/4 COR OF SEC 18 &19. SHOWS IN MIDDLE OF E/W RD & CENTER OF N/S RD. 2499.25 TO NW COR SEC 19
- 1957 BATTERMAN JR. VOL 3 PG 519 FD 1 1/2 PIPE AS SET BY SUNNY. REFERENCED COR. IN MIDDLE OF RD INT.
- 1970 WIDOT CTH M #13069 STATES NOTHING REFERENCED CORNER ON SHEET 4.7. THE DISTANCES TO THE REFERENCE MONUMENTS AND DISTANCES BETWEEN THE REFERENCE MONUMENTS ARE THE SAME AS SHOWN IN 1957, VOL 3 PG 519.
- 1971 LEE VOL 4 PG 533 AT N 1/4 COR SEC 19 WAS SHOWN T BAR OVER COR BY FRED SAGE PROJECT ENGINEER OF RD BUILDING. ALL PREVIOUS REFERENCES HAD BEEN DESTROYED. REFERENCED SAME.
- 1985 BARNES N-3 PREPARED FOR RD CONSTRUCTION PROJECT. FD T-BAR & FD REFERENCE PIPES. REFERENCED SAME.
- 1985 BARNES N-3(1) AFTER CONSTRUCTION. I FD THE T-BAR 12"
 DEEP & REPLACED IT WITH A POLY MON. UNDER THE BAR
 THERE WAS A 1-1/2X1-1/2X8" WOOD HUB.
- 1985 BARNES VOL 6 PG 346 EAST 2670.94 TO SE COR SEC 18, S89-49-29W 2498.54 TO NW COR SEC 19, S00-12-35W 2674.61 TO CEN SEC 19, 5346.49 TO S 1/4 COR SEC 19
- 1986 BARNES VOL 6 PG 360 NO1-04-06E 5360.81 TO N 1/4 COR SEC 18, EAST 2670.94 TO SE COR SEC 18, SOO-12-35W 2674.61 TO ALUM @ CEN OF SEC 19, 5346.49 TO 1 1/2 PIPE IN MON BOX @ S 1/4 COR SEC 19
- 1992 KUPSCH #11556 FD BROKEN OFF TOP OF ALUM. MON. 2670.83 TO ALUM MON @ NE COR SEC 19
- 1994 KARNS CSM VOL 17 PG 148 FD ROCK COUNTY ALUM. MON SOUTH TO S 1/4 COR SEC 19, S89-41-20W 2498.57 TO NW COR SEC 19
- 1990 SCHROEDER #2237 SCHROEDER #2237 STATES NOTHING ABOUT MON. S89-49-29W TOWARDS NW COR SEC 19
- 1995 KARNS CSM VOL 18 PG 190 FD ROCK COUNTY ALUM. MON 5346.99 TO S 1/4 COR SEC 19
- 1998 KARNS CSM VOL 21 PG 350 ROCK COUNTY MON. SOO-O4-O52E TO S 1/4 COR SEC 19, S89-41-20W TO NW COR SEC 19
- 2000 KARNS CSM VOL 24 PG 268 ROCK COUNTY MON. S00-04-52W ALONG N/S 1/4 LINE OF SEC 19, S89-41-20W 2498.57 TO NW COR SEC 19
- 2002 COMBS CSM VOL 25 PG 325 PK 5360.99 TO ALUM @ N 1/4 COR SEC 18

SHEET 2 OF 4
CORNER CODE N-3(2)

Venald Formes 3-17-2009

PO562 N1/4CORSEC19

2003 LATHROP CSM VOL 26 PG 224 PK 589-24-27E 2670.89 TO CI @ SE COR SEC 18

SEARCHED FOR THE 1957 REFERENCE MONUMENTS AND FOUND NOTHING. FOUND THE 1971LEE VOL 4 PG 533 REFERENCES AS FOUND IN1985 [BARNES N-3 & N-3(1)]. LARGE CUT & FILL AREA.

C) Was the corner restored through acceptance of (1) an obliterated evidence location, or, (2) a found perpetuated location?

ACCEPTED FD POLY.

D) Describe any material discrepancy between the location of the corner as restored or reestablished and the location of that corner as previously restored or reestablished by distance and direction. Show the discrepancy on the plan view drawing under (a), above. Show the distances between the corner as previously restored or reestablished and (1) the corner as restored or reestablished, and (2) to at least 4 of the witness monuments shown on the drawing in (a), above.

NONE

(E) Was the corner reestablished through lost corner proportionate methods? If so, show the method, including the directions and distances to other public land survey corners used as evidence or used for proportioning the corner location.

NO

I, **Donald Barnes**, hereby certify that the corner location as identified by the corner code index was determined by me under my direction and control and that this U.S. Public Land Survey Monument Record is correct and complete to the best of my knowledge and belief.

SHEET 3 OF 4

CORNER CODE N-3(2)

A.E. 7.08 REQUIREMENT

