U.S.


## PUBLIC LAND SURVEY MONUMENT RECORD

For Public Land Survey Corners in:

WI ADMINISTRATIVE CODE A-E 7.08 REQUIREMENT

T.2N, R. // E

CORNER CODE INDEX

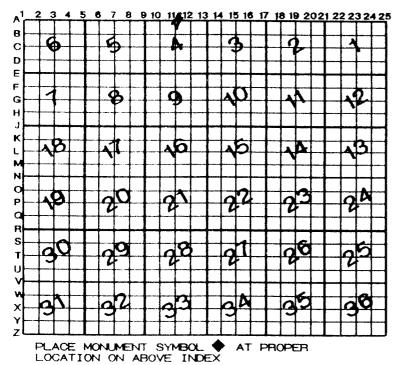

PLYI	n	00	17	H	T	W	P
ROCK	C	OU)	NT	Y	wı		

IF AVAILABLE ROCK COUNTY COORDINATES PERFERRED

North Elev.
East
Hor. Datum Vert. Datum
LATITUDEELLIPS. HT.
LONGITUTE
GPS (X) TRAVERSE (X)
BASED ON THE FOLLOWING CONTROL:

**♦**CORNER MONUMENT

O WITNESS MONUMENT

BEAFINGS ARE BASED ON:

(a)

OBSERVATION SHEET 506,507, 7070, 2250	7010
1010, 2210	

FIELD BOOK \_\_\_\_PAGE # \_\_\_\_ SHEET \_\_\_\_ OF \_\_\_\_ SHOW A PLAN VIEW DRAWING DEPICTING THE CORNER MONUMENT AND SURROUNDING PHYSICAL FEATURES, INCLUDING THE EXCAVATION AREA AND DEPTH.

PLANNING & ZONING COMMITTEE ADOPTED THE ABOVE FORM ON 12/2/1982

CORNER CODE A - 1/(4)

## PL506

- (B) Describe any record evidence, monument evidence, occupational evidence, testimonial evidence or any other material evidence you considered, and whether the monument was found or placed.
- 1833 MULLETT WEST ON SOUTH SIDE SECTION 33 T3N R11E
  2640 SET QUARTER SECTION POST IN PRAIRIES AND MADE
  MOUND
  - 5280 SET POST CORNERS SECTIONS 32 & 33 IN PRAIRIE AND MADE MOUND. LAND & C SAME.
- 1866 LOCKE VOL 1 PG 277 FOUND COR AS SET BY SELF.
- 1868 LOCKE PG 49 WEST ON NORTH LINE SEC 4 VAR 7
  - 503.58 STONE CULVERT
  - 1256.64 CENTER SLUICE BRIDGE 3.3' WIDE
  - 2684.88 INTERSECTED 1/4 LINE FOR TOWN 3 2.11' SOUTH OF COR FOUND OLD STAKE IN CENTER OF HIGHWAY AND NEARLY IN LINE WITH FENCES RUNNING N AND S.
  - 2651.88 SET 1/4 COR FOR SEC 4 33' EAST OF COR. FOR TOWN 3 33' BEING 1/2 OF THE SUM OF THE MEAN BETWEEN THE "JOGS" AT THE SEC. CORS. VAR CORRECTED 6-44

## CONTINUED WEST FROM 1/4 COR WITH VAR 7

- 5311.18 INTERSECTED WEST BOUNDARY 26.90' SOUTH OF COR. FOUND STONE SET BY SELF. (SEE CO. SURVEYORS RECORD SEC 4) VAR CORRECTED 6-25 MARKED 1/4 MONUMENT WITH FIGURE 4 ON SOUTH FACE. SEPT 3, 1868
- 1913 OWEN A-11(3) & MAP #6306 WEST 2661.0 TO NW COR SEC 4 & SOUTH 2560.5 TO CENTER SEC 4. INT. SECTION OF FENCES & TOWNSHIP LINE. INT. OF FENCES & TWP LINE
- 1934 SUNNY VOL 3 PG 236 FOUND IRON PIPE IN CONCRETE PAVEMENT IN LINE WITH FENCES SET BY ELY. 2.8' NORTH OF CENTER OF CONCRETE PAVEMENT.
- 1968 LEE VOL 6 PG 386 ANGLE 89-54-12 @ N  $\frac{1}{4}$  COR SEC 4 FROM NE COR SEC 4 TO CENTER OF SEC 4.
- 19?? BATTERMAN ? DOT PROJECT TIE SHEET. FD 1" PIPE 2.8'
  NORTH OF CENTER OF PVMT. REFERENCED SAME.
- 19?? WIDOT? A-11(1) DOT PROJECT TIE SHEET. ORIG PIN IN CONCRETE REMOVED IN REMOVAL OF PVMT. IN GRADING CONTRACT. 3/4" STEEL ROD (FLUSH) & REFERENCED SAME.
- 1974 LEE MAP #4316 PIPE IN MON. BOX
- 1988 LEE CSM 13-216 POLY. MON. 25.97 EAST OF S  $\frac{1}{4}$  COR SEC 33 CENTER TWP, 2625.14 TO NE COR SEC 4
- 1988 BARNES VOL 6 PG 386 N89-03-54E 2651.06 TO NE COR SEC 4, S89-24-32W 2659.86 TO NW COR SEC 4, S1-02-25E 2556.71 TO CENTER SEC 4, & ANGLE 89-53-41 @ N 1/4 COR SEC 4 FROM NE COR SEC 4 TO CENTER SEC 4.
- 1988 BARNES Z-11 (CENTER TWP) FD 1" PIPE IN MON BOX @ N 1/4 & S 1/4 COR SEC 33 CENTER TWP. N 1/4 SEC 4 IS 25.97 EAST OF S 1/4 COR SEC 33 SEE REVERSE SIDE. DID NOT ACCEPT 1" PIPE IN MON. BOX. IS NOT IN HARMONY WITH LOCKE'S JOG DISTANCE AND DISTANCE TO THE SE COR OF SEC 33. N89-23-54E 2673.45 (TO SW COR SEC 33 & N89-03-57E 2650.63 (LOCKE 2658.28) TO SE COR SEC 33; N89-24-32E 2659.86 (LOCKE 2659.31 TO NW COR SEC 4 & N89-03-54E 2651.06 (LOCKE 2651.88) TO NE COR SEC 4.
- 1988 BARNES A-11(2) FOUND PIPE IN MON. BOX 25.97 (LOCKE 33') FD PIPE IN MON. BOX @ 5 1/4 COR SEC 33 CENTER TWP & REFERENCED SAME REFERENCED SAME CORNER THAT IS REFERENCED SHOULD NOT BE USED AS CORNER. SEE REVERSE SIDE. DID NOT ACCEPT 1" PIPE IN MON. BOX. IS NOT IN HARMONY WITH LOCKE'S JOG DISTANCE AND DISTANCE TO THE SE COR OF SEC 33. N89-23-54E 2673.45 (TO SW COR SEC 33 & N89-03-57E 2650.63 (LOCKE 2658.28) TO SE COR SEC 33; N89-24-32E 2659.86 (LOCKE 2659.31 TO NW COR SEC 4 & N89-03-54E 2651.06 (LOCKE 2651.88) TO NE COR SEC 4.

SHEET 1 OF 2 CORNER CODE A-11(4)

1/16/03 Donali Baines PL506

- 1989 WIDOT STH 11 MAP #16698 PROJECT 1704-03-22 1" PIPE 245,973.01 N/S; 2,215,324.16 E/W. AT S 1/4 COR SEC 33 1" PIPE 249,972.61 N/S; 2,215,298.20 E/W
- 1989 COMBS MAP #12283 S89-24-32W 2659.86 TO NW COR SEC 4, N89-03-54E 2651.06 TO NE COR SEC 4, & S1-02-25E 2556.71 TO CENTER SEC 4. MON BOX AT N  $\frac{1}{4}$  COR SEC 4. AT S  $\frac{1}{4}$  COR SEC 33 SET IRON PIPE FROM INFORMATION PROVIDED BY COUNTY SURVEYOR
- 1995 LEUNEMBURGER CSM VOL 18 PG 425 PIPE IN MON BOX AT N  $\frac{1}{4}$  COR SEC 4 & S  $\frac{1}{4}$  COR SEC 33. 25.97 (WESTERLY TO S  $\frac{1}{4}$  COR SEC 33) 2651.11 FROM N  $\frac{1}{4}$  COR SEC 4 TO NE COR SEC 4, & 2650.62 FROM S  $\frac{1}{4}$  COR SEC 33 TO SE COR SEC 33.
- 1995 BARNES A-11(3) & Z-11(1) SHOWS REFERENCE DIAGRAM & DISCREPANCY WITH NEW ESTABLISHED MONUMENTS. SET 34X24 REROD ON LINE WITH REROD AT THE S 1/4 COR SEC 33 AND THE ERRONEOUS CORNER THAT LOCKE STET AT THE N 1/4 COR SEC 4. REROD IS MIDWAY BETWEEN THE NE & NW CORNERS OF SEC 4. I DID NOT ACCEPT THE 1" PIPE IN THE MONUMENT BOX. LOCKE'S METHOD OF USING THE JOG DISTANCES TO DETERMINE THE DISTANCE FROM THE S 1/4 COR OF SEC 33 WAS NOT A FEDERAL OR STATE LAW AT THAT TIME. THE LAWS STATED THE CORNER WAS TO BE PLACED EQUAL DISTANCE BETWEEN THE NE & NW CORNERS OF SEC 4. ON PAGE 230 OF TOM SPARGUE'S MANUAL OF STATE & FEDERAL LAWS FOR ESTABLISHING AND PERPETUATING THE ORIGINAL GOVERNMENT SURVEY IN WISCONSIN, THE PLACEMENT OF THE N 1/4 CORNER OF SEC 4 FOR THE GENERAL LAWS OF WISCONSIN 1860, CHAPTER 3223, SECTION 2 IS SHOWN. THE DIAGRAM SHOWS THE N 14/ COR NEAR BEING MID WAY BETWEEN THE NE & NW CORNERS OF SEC 4. THE GENERAL LAWS OF WISCONSIN, 1862 AND 1867 DID NOT CHANGE THE METHOD. USED LOCKE'S POSITION TO ESTABLISH THE 5 1/4 COR OF SEC 33 CENTER TWP. 2659.83 FROM MON. BOX TO NW COR SEC 4, 2650.99 FROM MON BOX TO NE COR SEC 4 26.26 BETWEEN MON. BOXES, 2673.44 FROM MON BOX NEAR S 1/4 COR SEC 33 TO SW COR SEC 33, 2650.54 FROM MON BOX NEAR S  $\frac{1}{4}$  COR SEC 33 TO SE COR SEC 33 CENTER TWP. 2655.41 FROM REROD AT N 1/4 COR SEC 4 TO NW COR SEC 4, 2655.41 FROM REROD AT N  $\frac{1}{4}$  COR SEC 4 TO NE COR SEC 4, 28.58 BETWEEN RERODS AT N 1/4 & S 1/4 CORNERS. 2666.41 FROM MON BOX NEAR S 1/4 COR SEC 33 TO SW COR SEC 33, 2657.57 FROM MON. BOX NEAR S 1/4 COR SEC 33 TO SE COR SEC 33.

2002 REIGEL MAP #14302 1" PIPE IN MON. BOX. 25.97 EAST OF S COR SEC 33. 2651.14 TO NE COR SEC 4

## FD TIES & MONUMENTS. USED MY 1995 OBSERVATIONS

C) Was the corner restored through acceptance of (1) an obliterated evidence location, or, (2) a found perpetuated location?

ACCEPTED RERODS.

I, **Donald Barnes**, hereby certify that the corner location as identified by the corner code index was determined by me under my direction and control and that this U.S. Public Land Survey Monument Record is correct and complete to the best of my knowledge and belief.

Soul

1/16/03 Con Id Barnes

SHEET 2 OF 2

CORNER CODE A-11(4)

A.E. 7.08 REQUIREMENT